PARENT PARCEL: 10-005-107-129, 374, 375
CHILD PARCEL: 10-00-005-107-394 thru [illegible]4
STARTING POINT: cL of Highland Park Dr. & cL of Chestnut Ridge Rd.
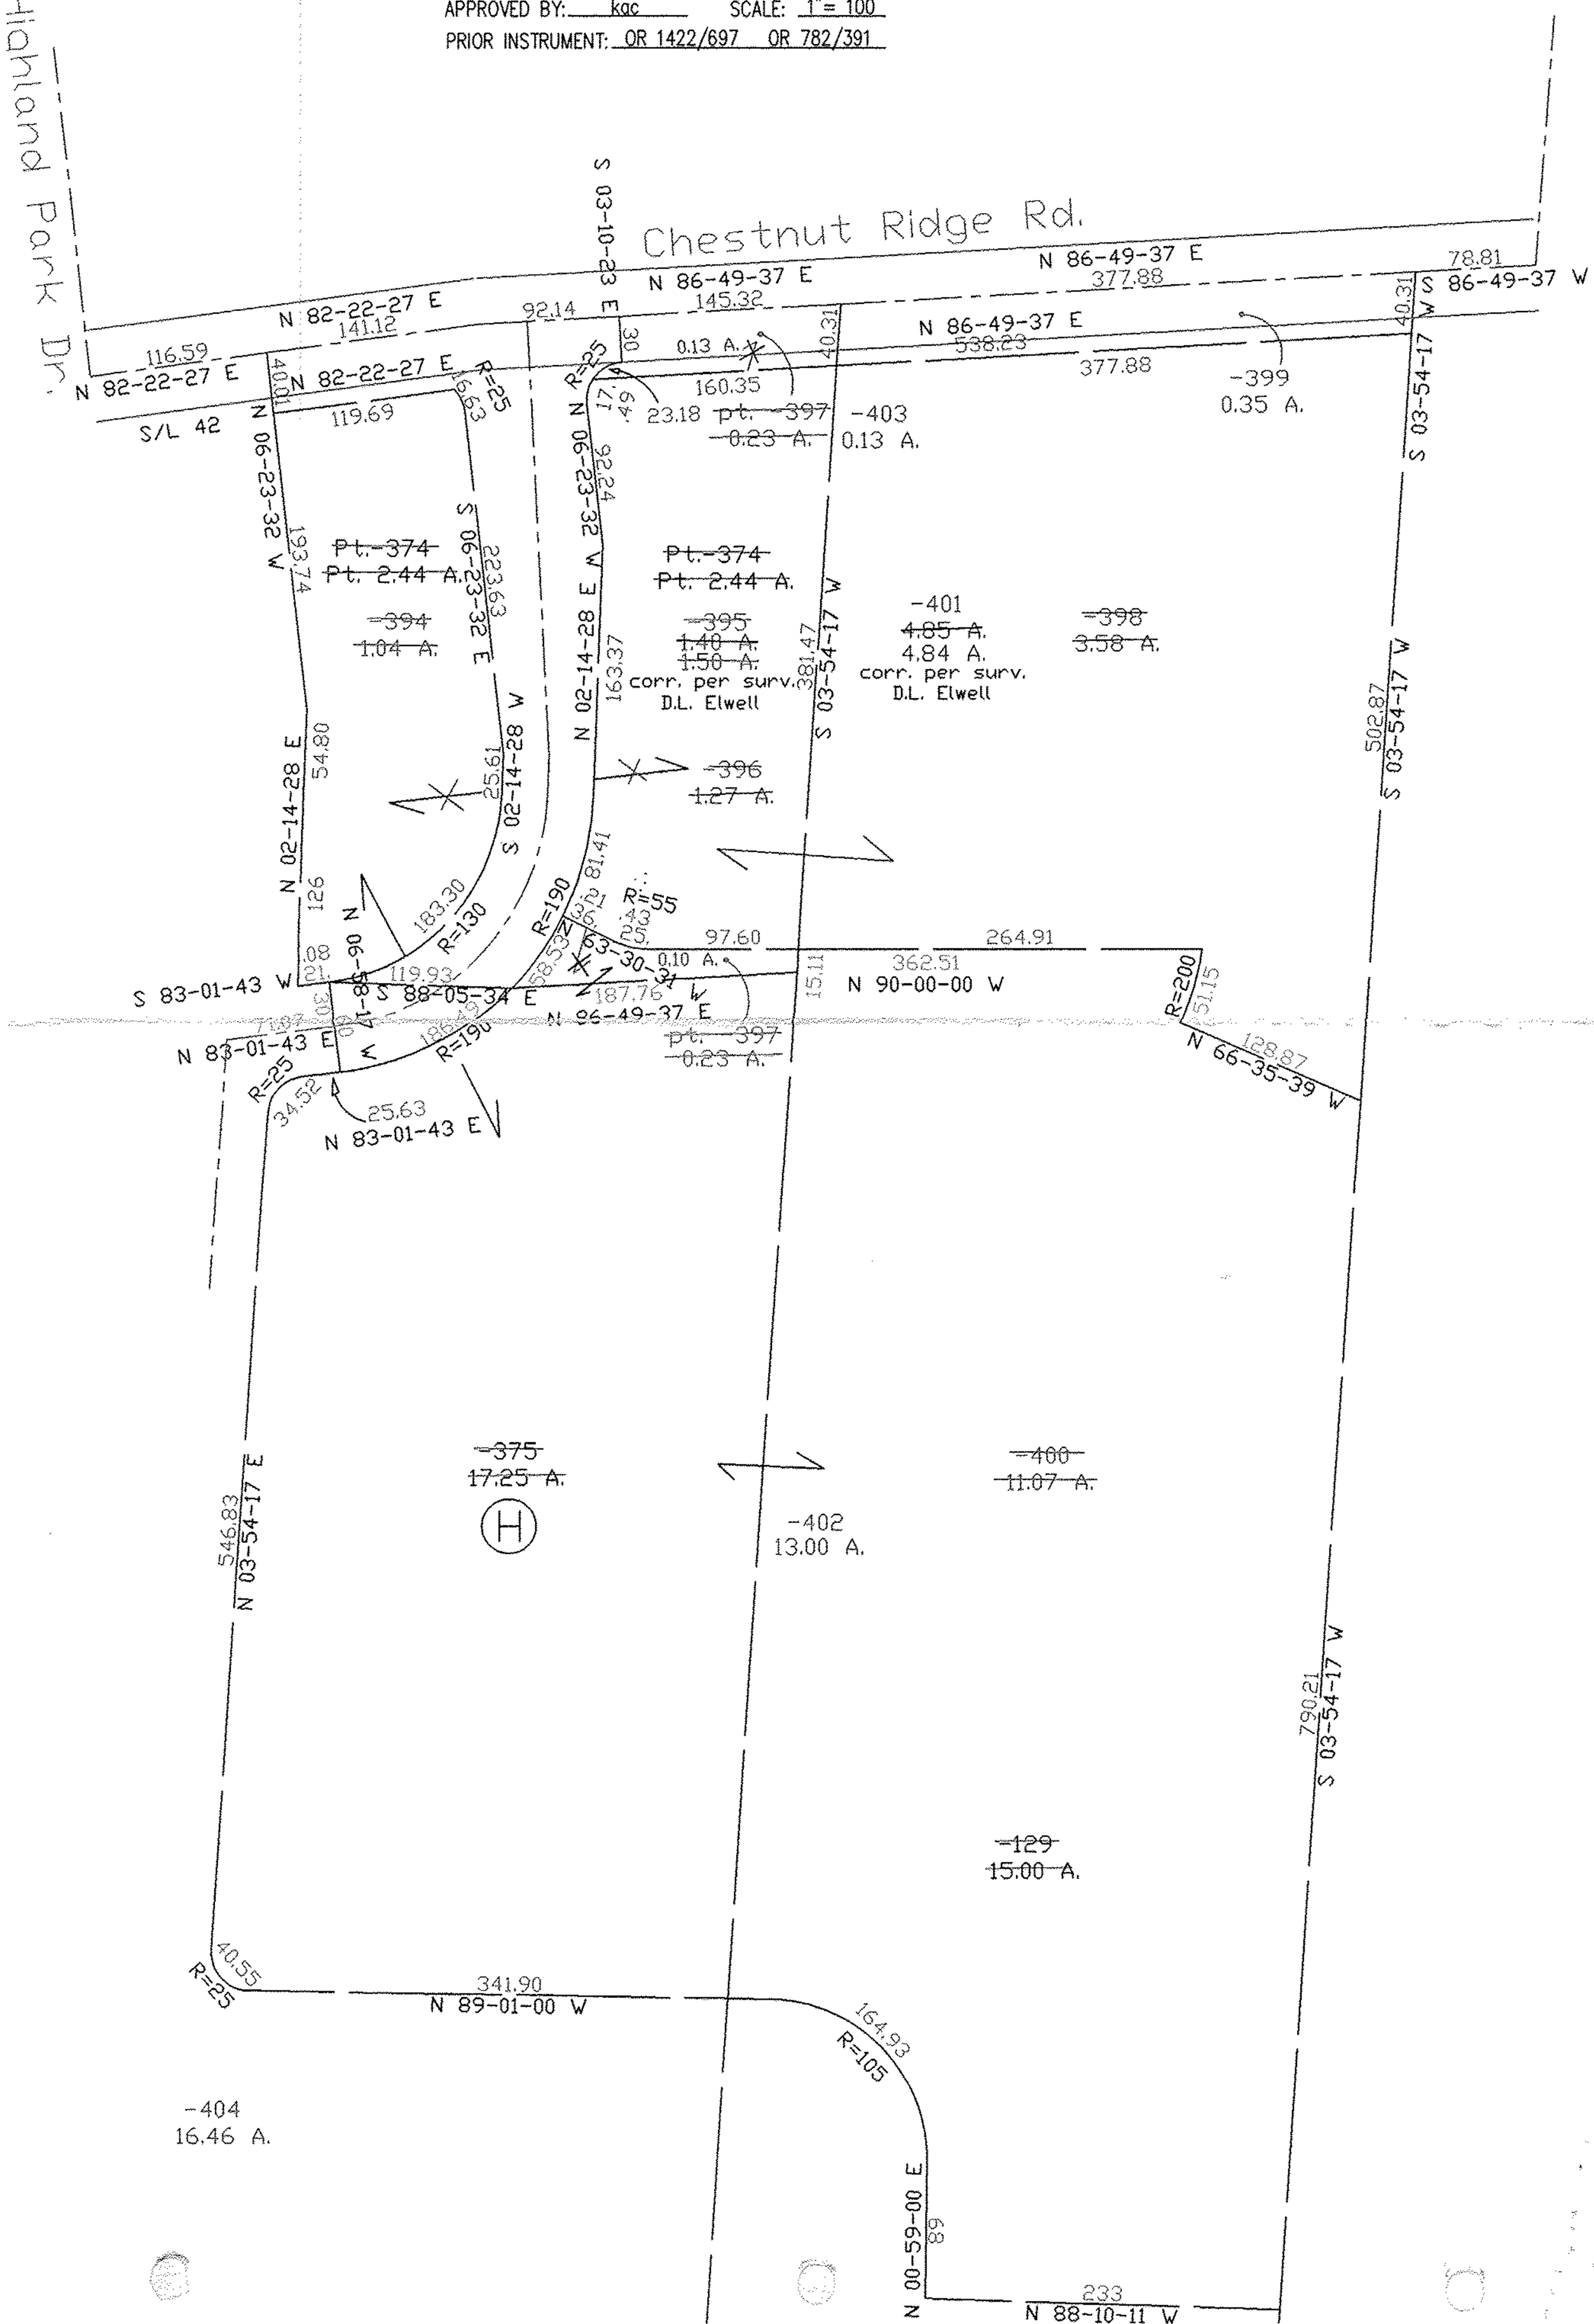
SURVEYED BY: David L. Elwell
CLOSURE: 0.11:10,000
MAP PAGE(S): 10-00-005-E,F DATE: 1/9/98
APPROVED BY: kac SCALE: 1"= 100
PRIOR INSTRUMENT: OR 1422/697 OR 782/391