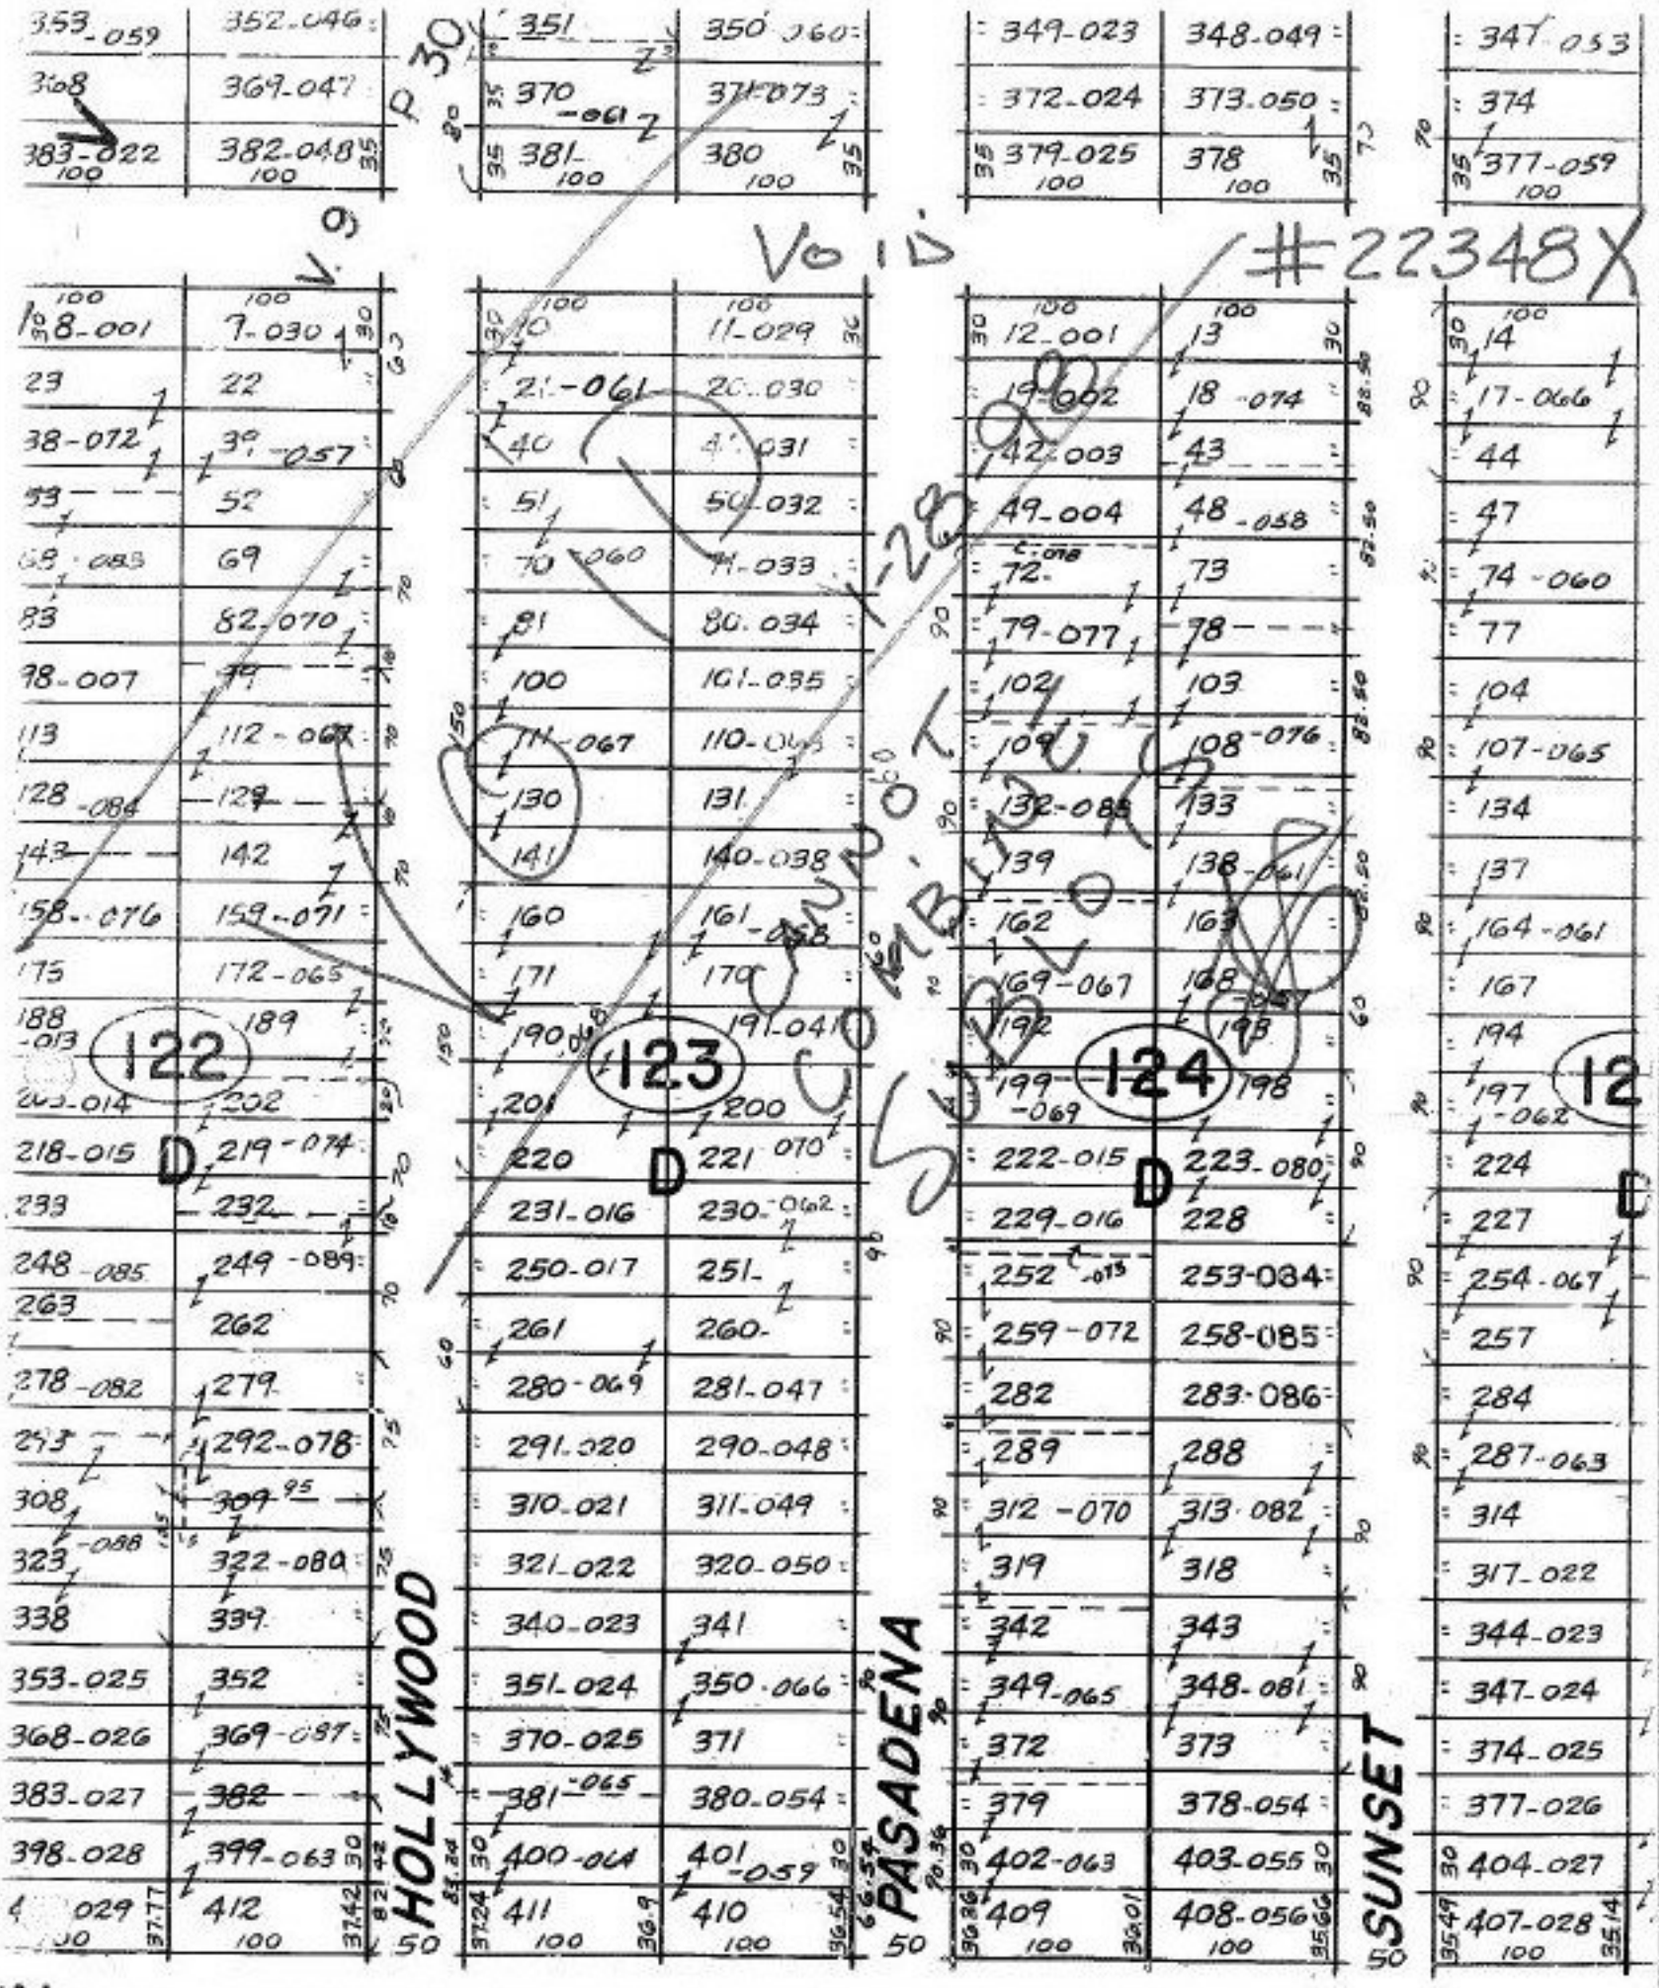

SEE 3-00-027-A

3-00-039-B