~~#22355~~

PARENT PARCEL: 12-00-070-017, 019

CHILD PARCEL: 12-00-070-000-020, 021, 022

STARTING POINT: SW corner of O.L. 70

NO. 22355

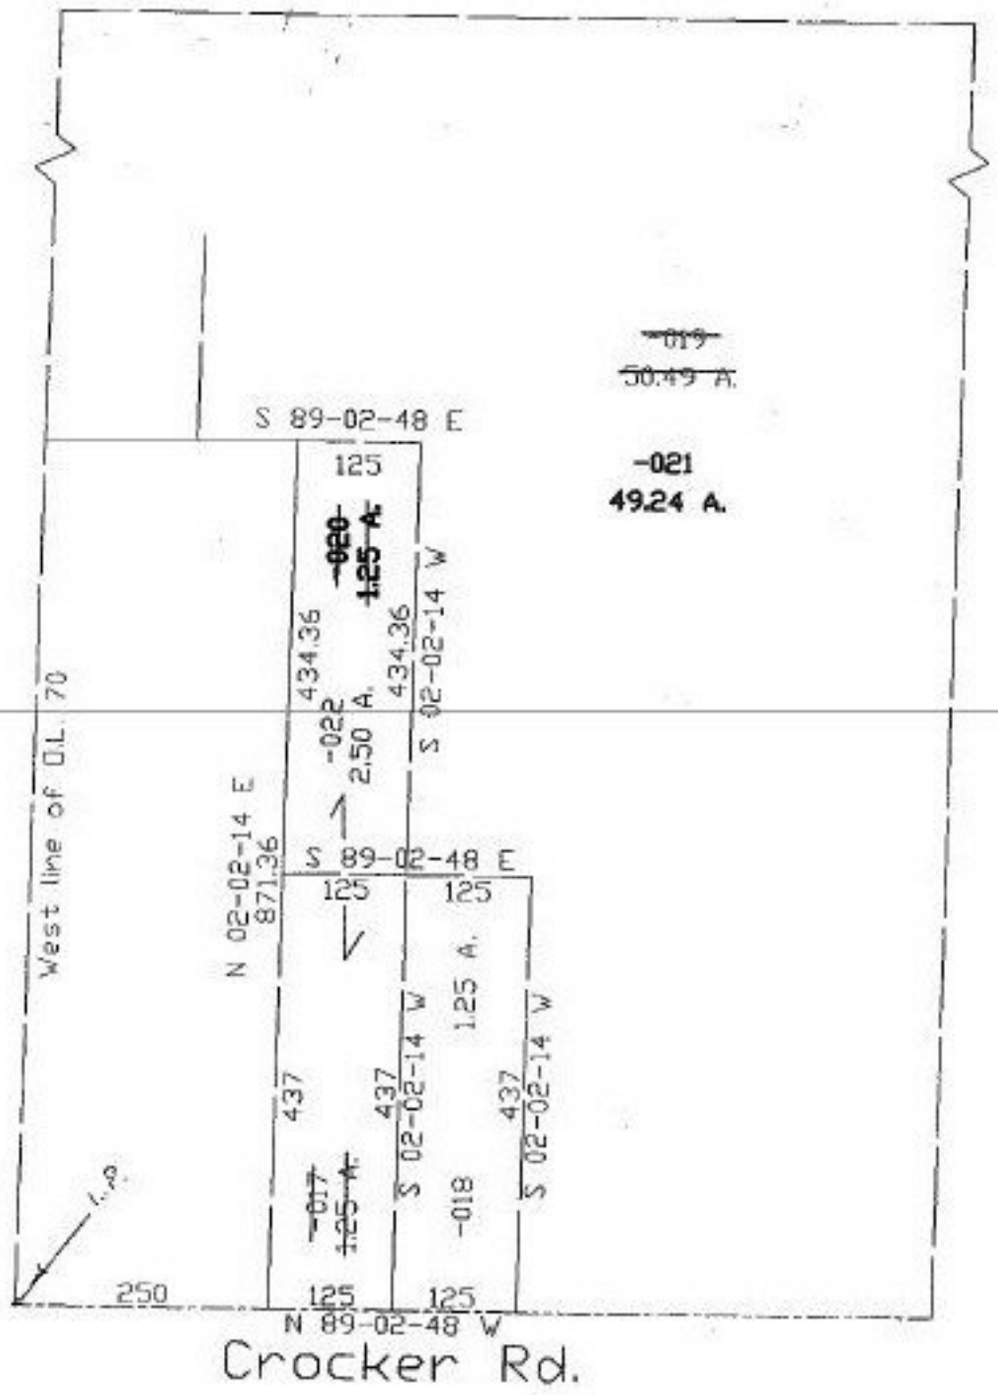

SPLITS/DEEDS PROCESSED

LORAIN COUNTY TAX MAP DEPARTMENT

226 MIDDLE AVE. ELYRIA, OHIO

SURVEYED BY: John Pazywak

CLOSURE: 0.10:10,000

MAP PAGE(S): 12-F APPROVED BY: kac

SCALE: 1"= 200 DATE: 11/11/97

PRIOR INSTRUMENT: DV 1409/208 & #970491430