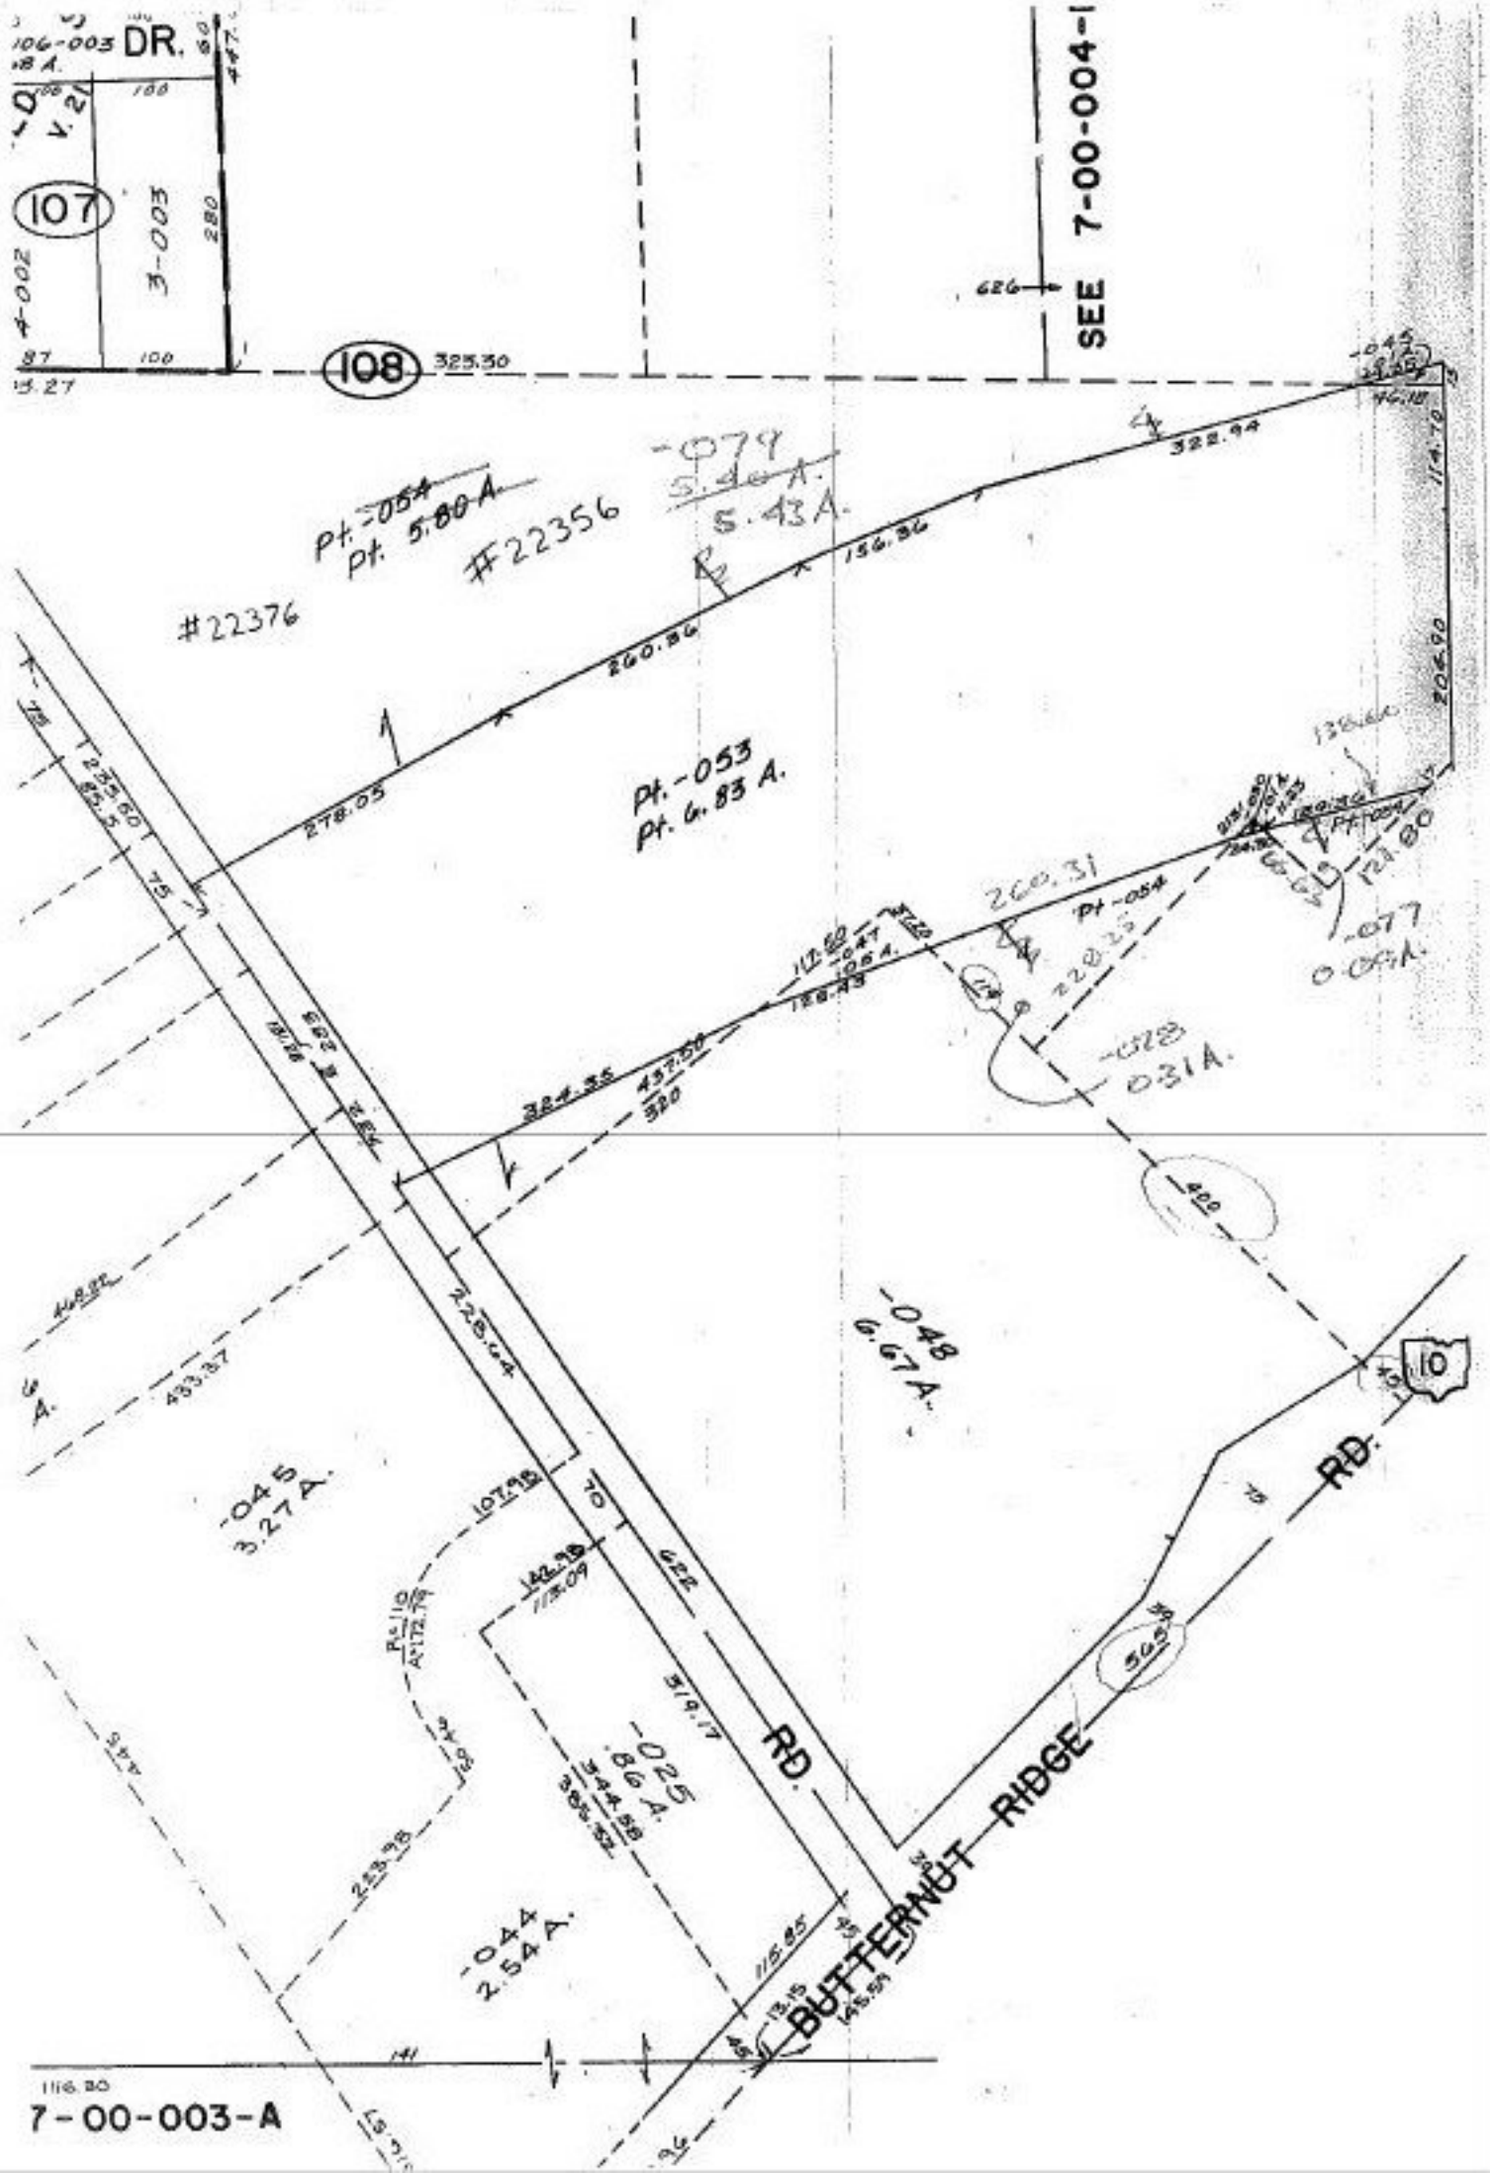

DR.
107
3-003
108
SEE 7-00-004-
Pt. -054
Pt. 5.80 A.
#22356
-079
5.40 A.
5.43 A.
#22376
Pt. -053
Pt. 6.83 A.
Pt. -054
-077
0.09 A.
-028
0.31 A.
-048
6.67 A.
-045
3.27 A.
-025
.86 A.
-044
2.54 A.
RD.
BUTTERNUT RIDGE
RD.
10
7-00-003-A