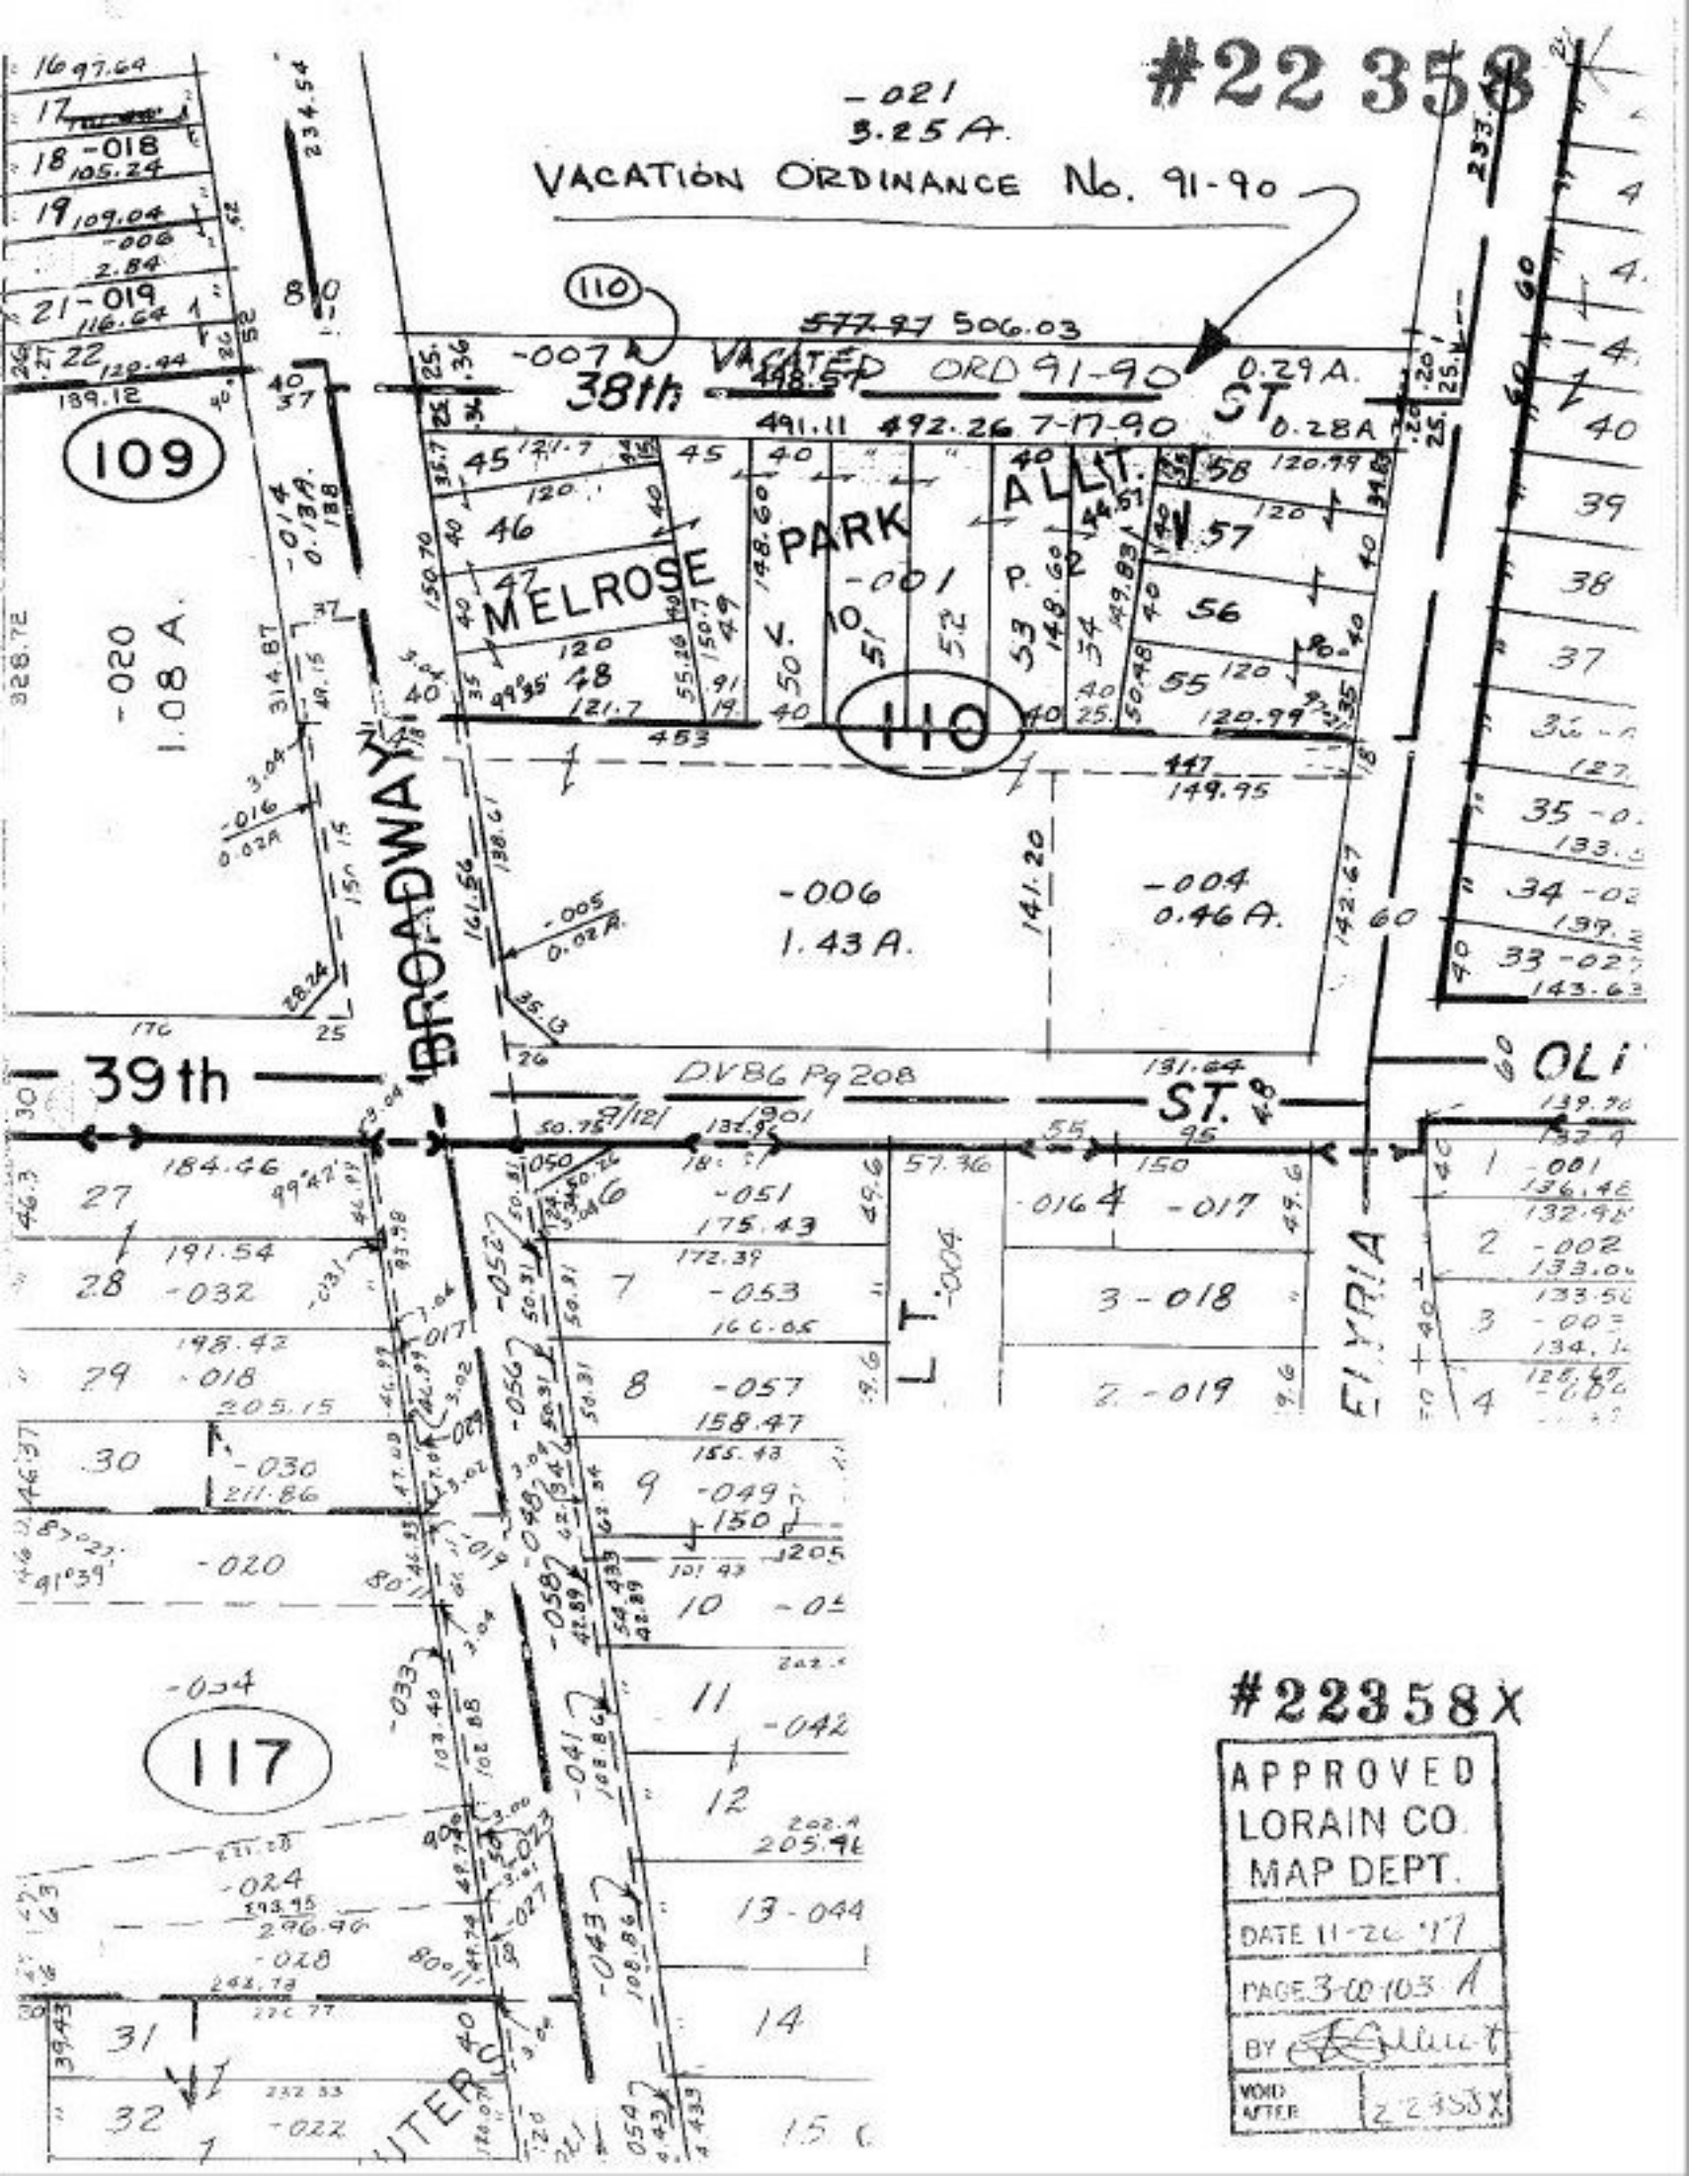
#22 358
-021
5.25A.
VACATION ORDINANCE No. 91-90
110
577.97 506.03
-007
VACATED ORD 91-90
0.29A.
38th ST
0.28A
491.11 492.26 7-17-90
109
MELROSE PARK ALLT.
-001
-014
0.13A.
-020
1.08 A.
-016
0.02A
-005
0.02A.
-006
1.43A.
-004
0.46A.
BROADWAY
39th ST.
DV86 Pg 208
ELYRIA
OLI
L T. -004
117
-034
-024
-028
-027
-043
-054
-042
-041
-033
-023
-022
-058
-048
-056
-052
-051
-053
-057
-049
-030
-031
-017
-018
-032
-019
-042
-044
-001
-002
-00
-0
#22358X
APPROVED
LORAIN CO.
MAP DEPT.
DATE 11-26 '97
PAGE 3-00 103 A
BY
VOID AFTER
2 2 3 5 X