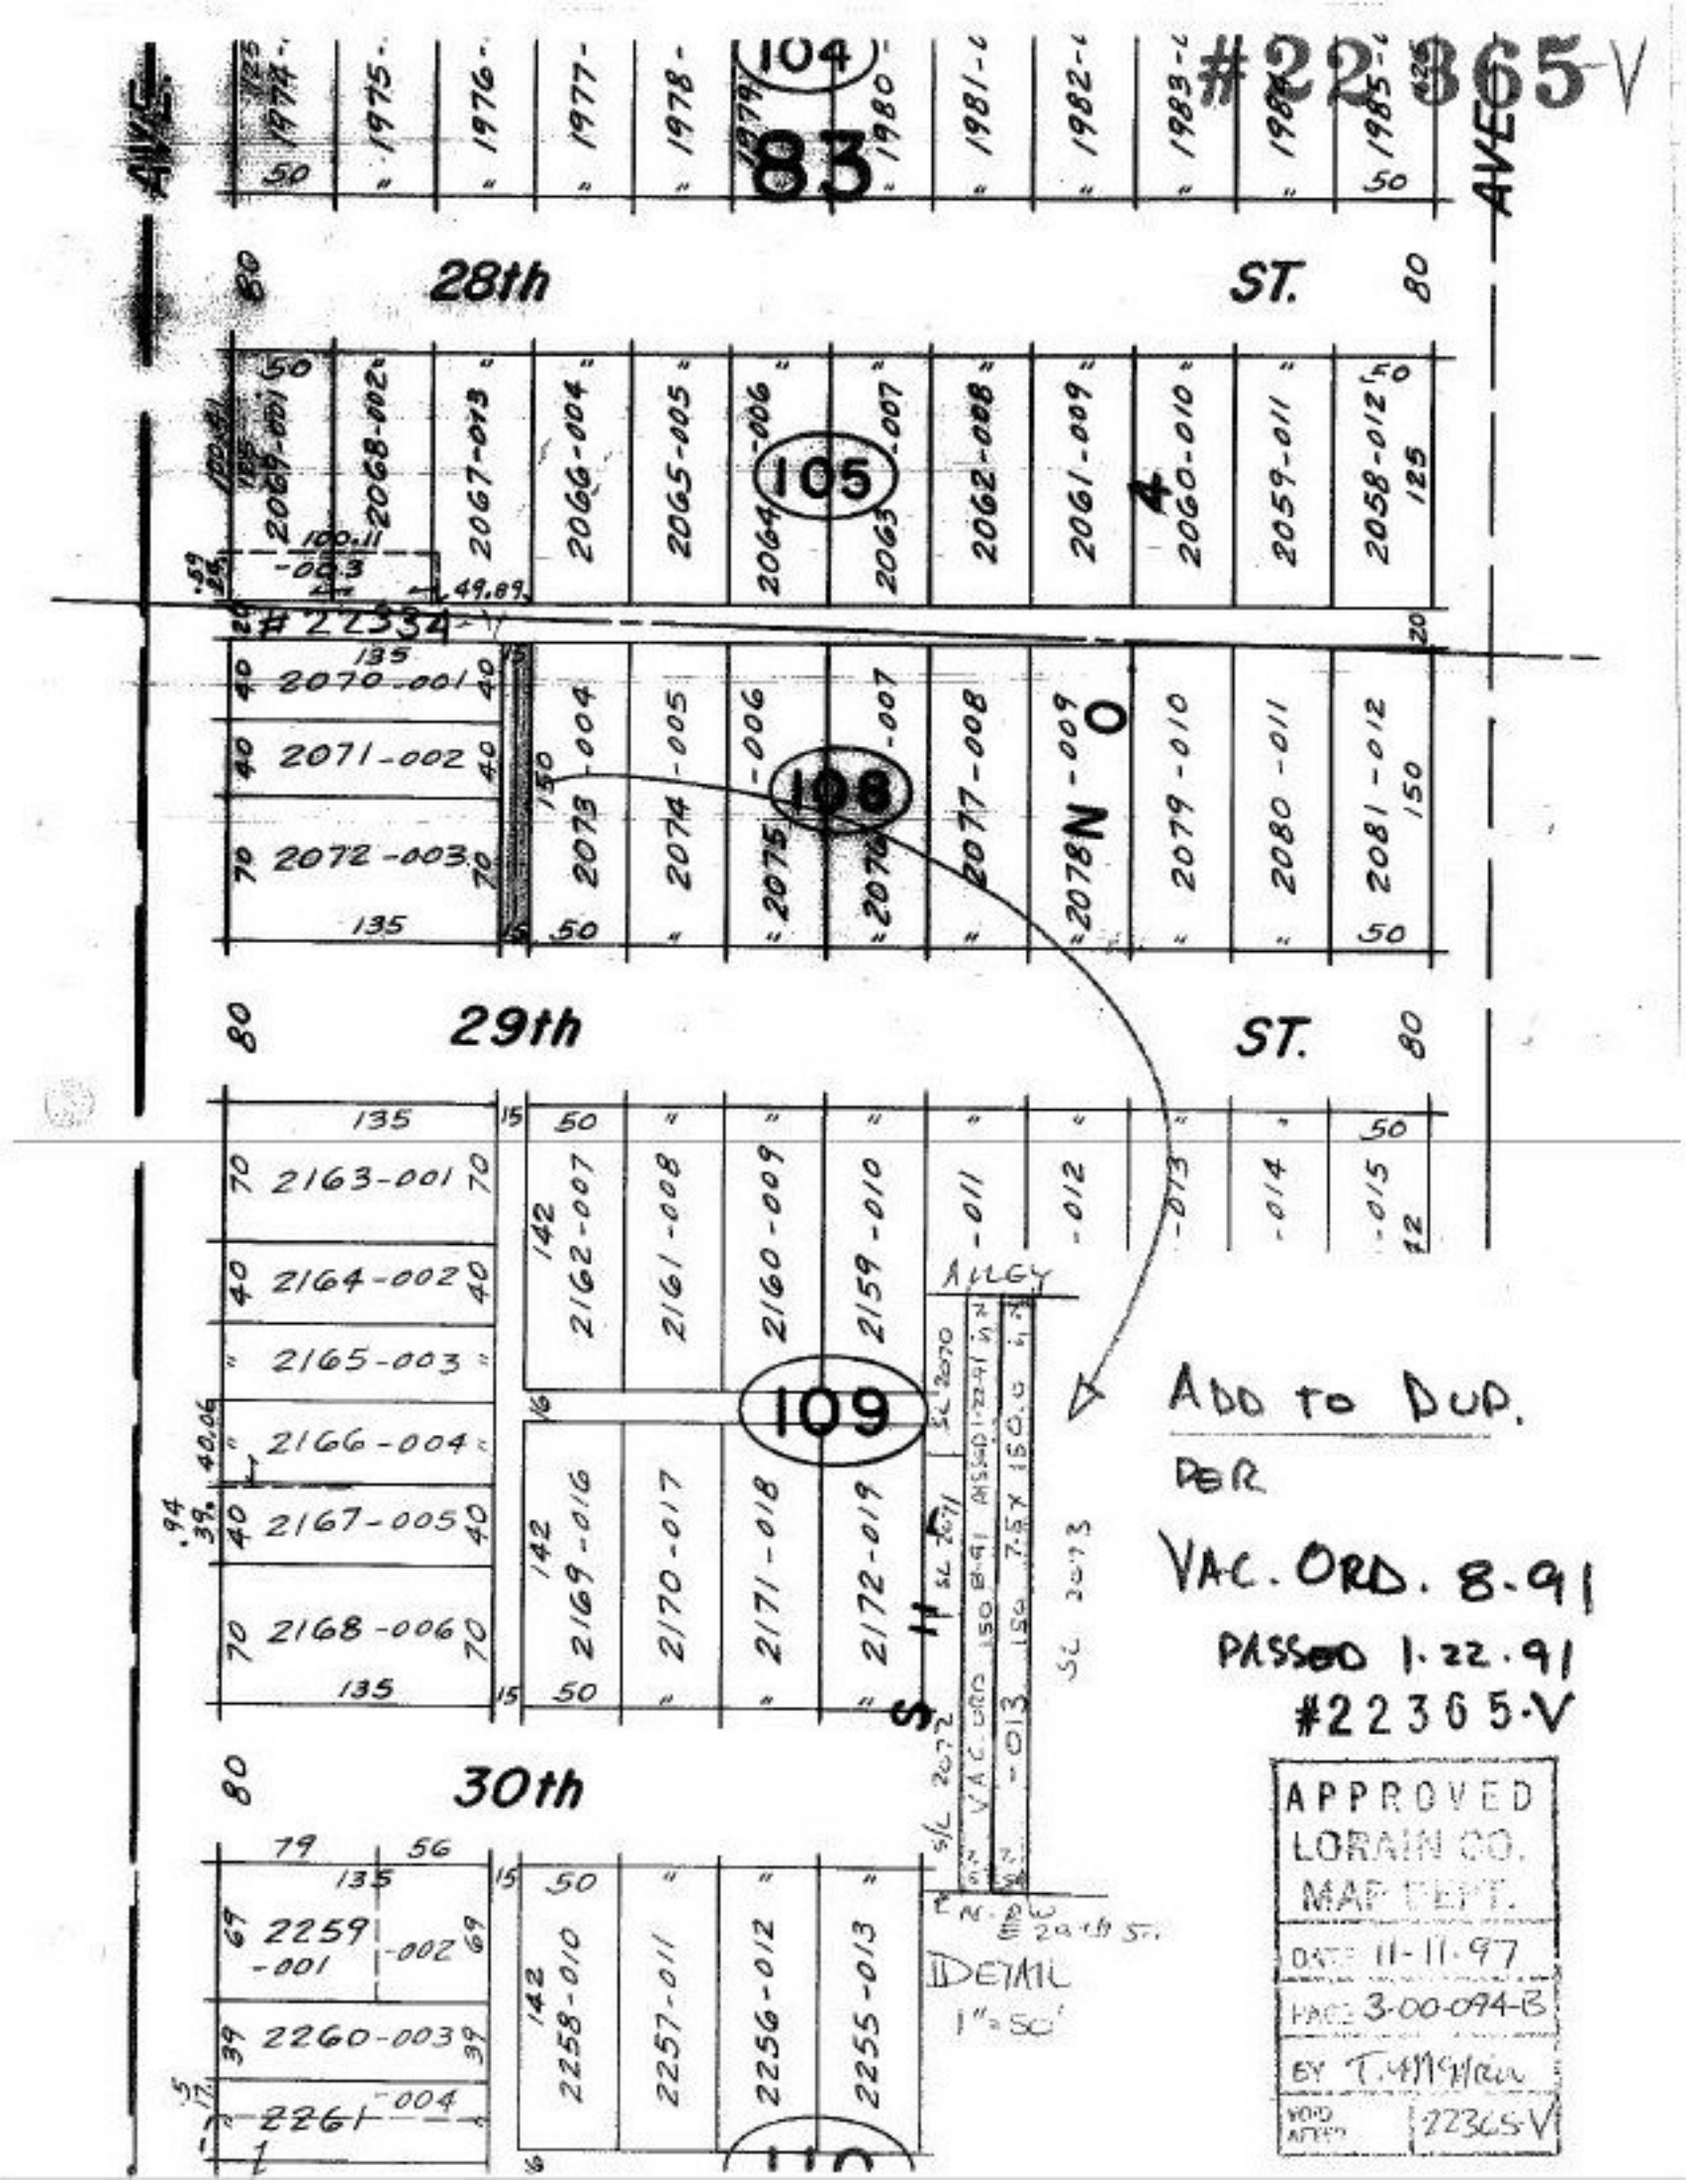
#22365-V
AVE.
AVE.
28th ST.
29th ST.
30th
83
104
105
108
109
110
#22334
ALLEY
DETAIL
1"=50'
ADD TO DUP.
PER
VAC. ORD. 8-91
PASSED 1-22-91
#22365-V
APPROVED
LORAIN CO.
MAP DEPT.
DATE 11-11-97
PAGE 3-00-094-B
BY T. McMahon
VOID AFTER 22365-V