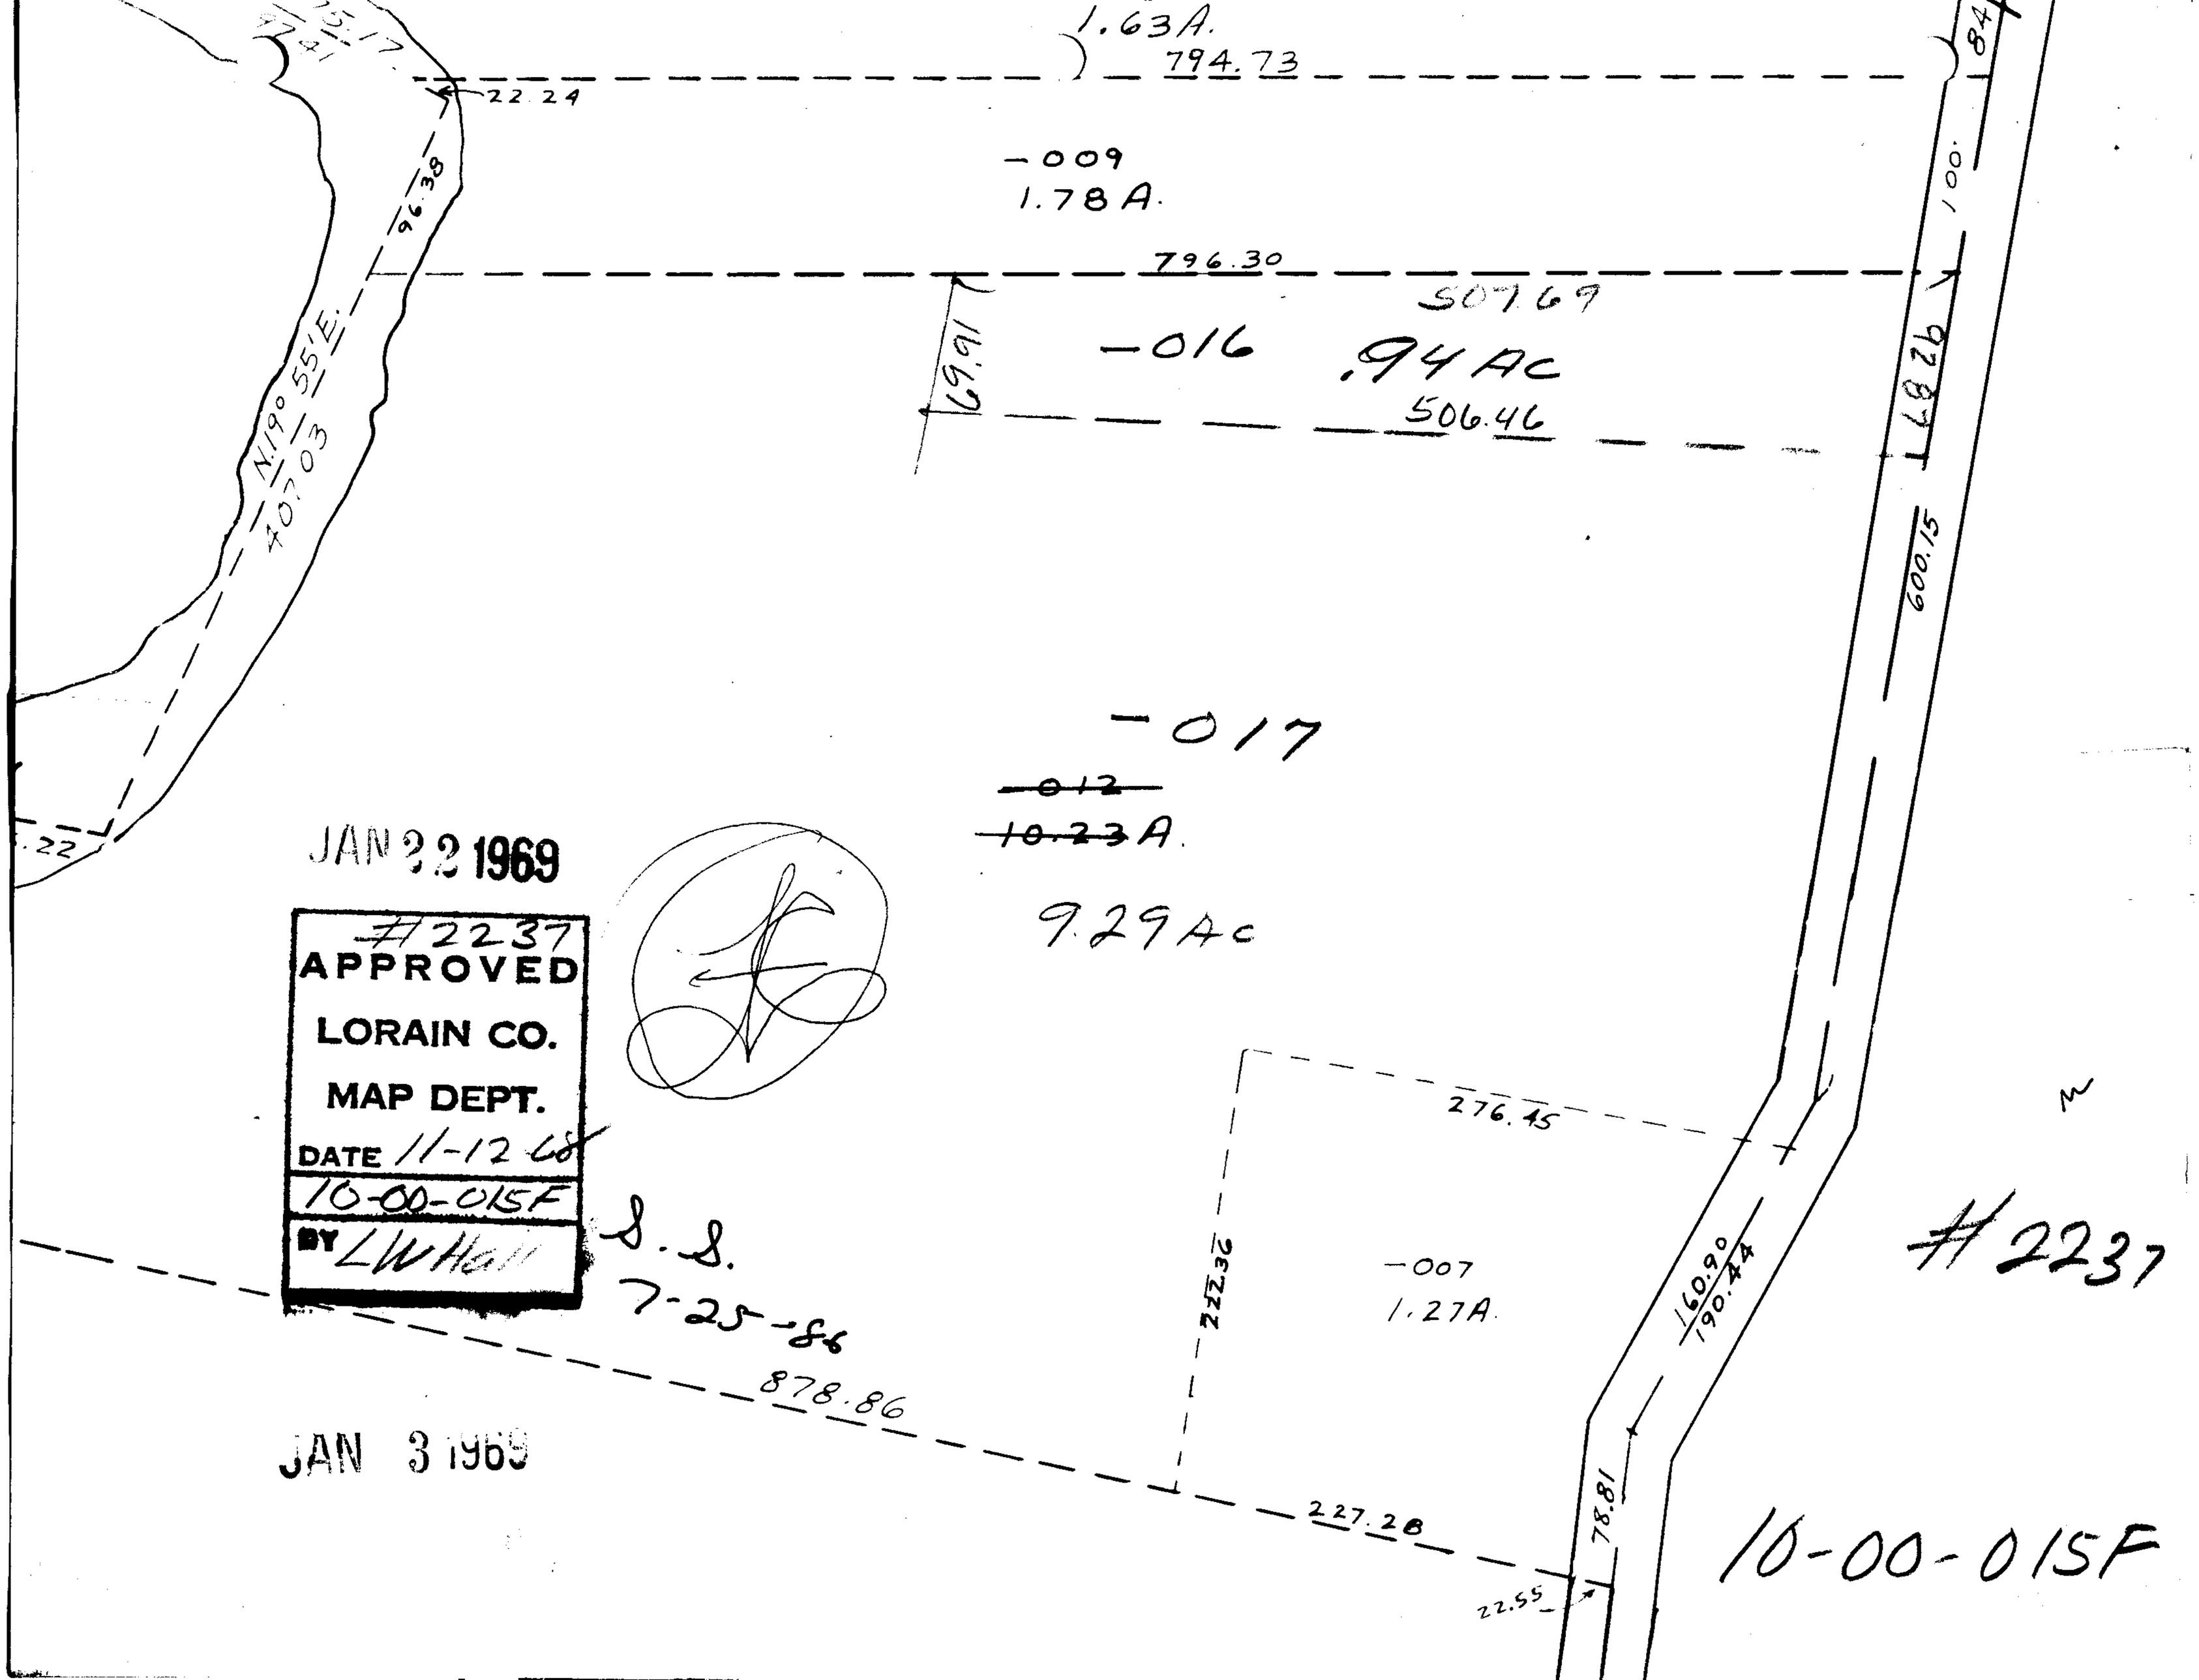
1.63A.
794.73
22.24
-009
1.78A.
796.30
507.69
-016
.94 Ac
506.46
69.91
96.38
N.19° 55'E.
407.03
-017
~~-012~~
~~10.23~~A.
9.29 Ac
JAN 22 1969
#2237
APPROVED
LORAIN CO.
MAP DEPT.
DATE 11-12-68
10-00-015F
BY LWHall
S.S.
7-25-86
878.86
JAN 3 1969
276.45
222.36
-007
1.27A.
160.90
190.44
78.81
227.28
22.55
#2237
10-00-015F
600.15
100.
84