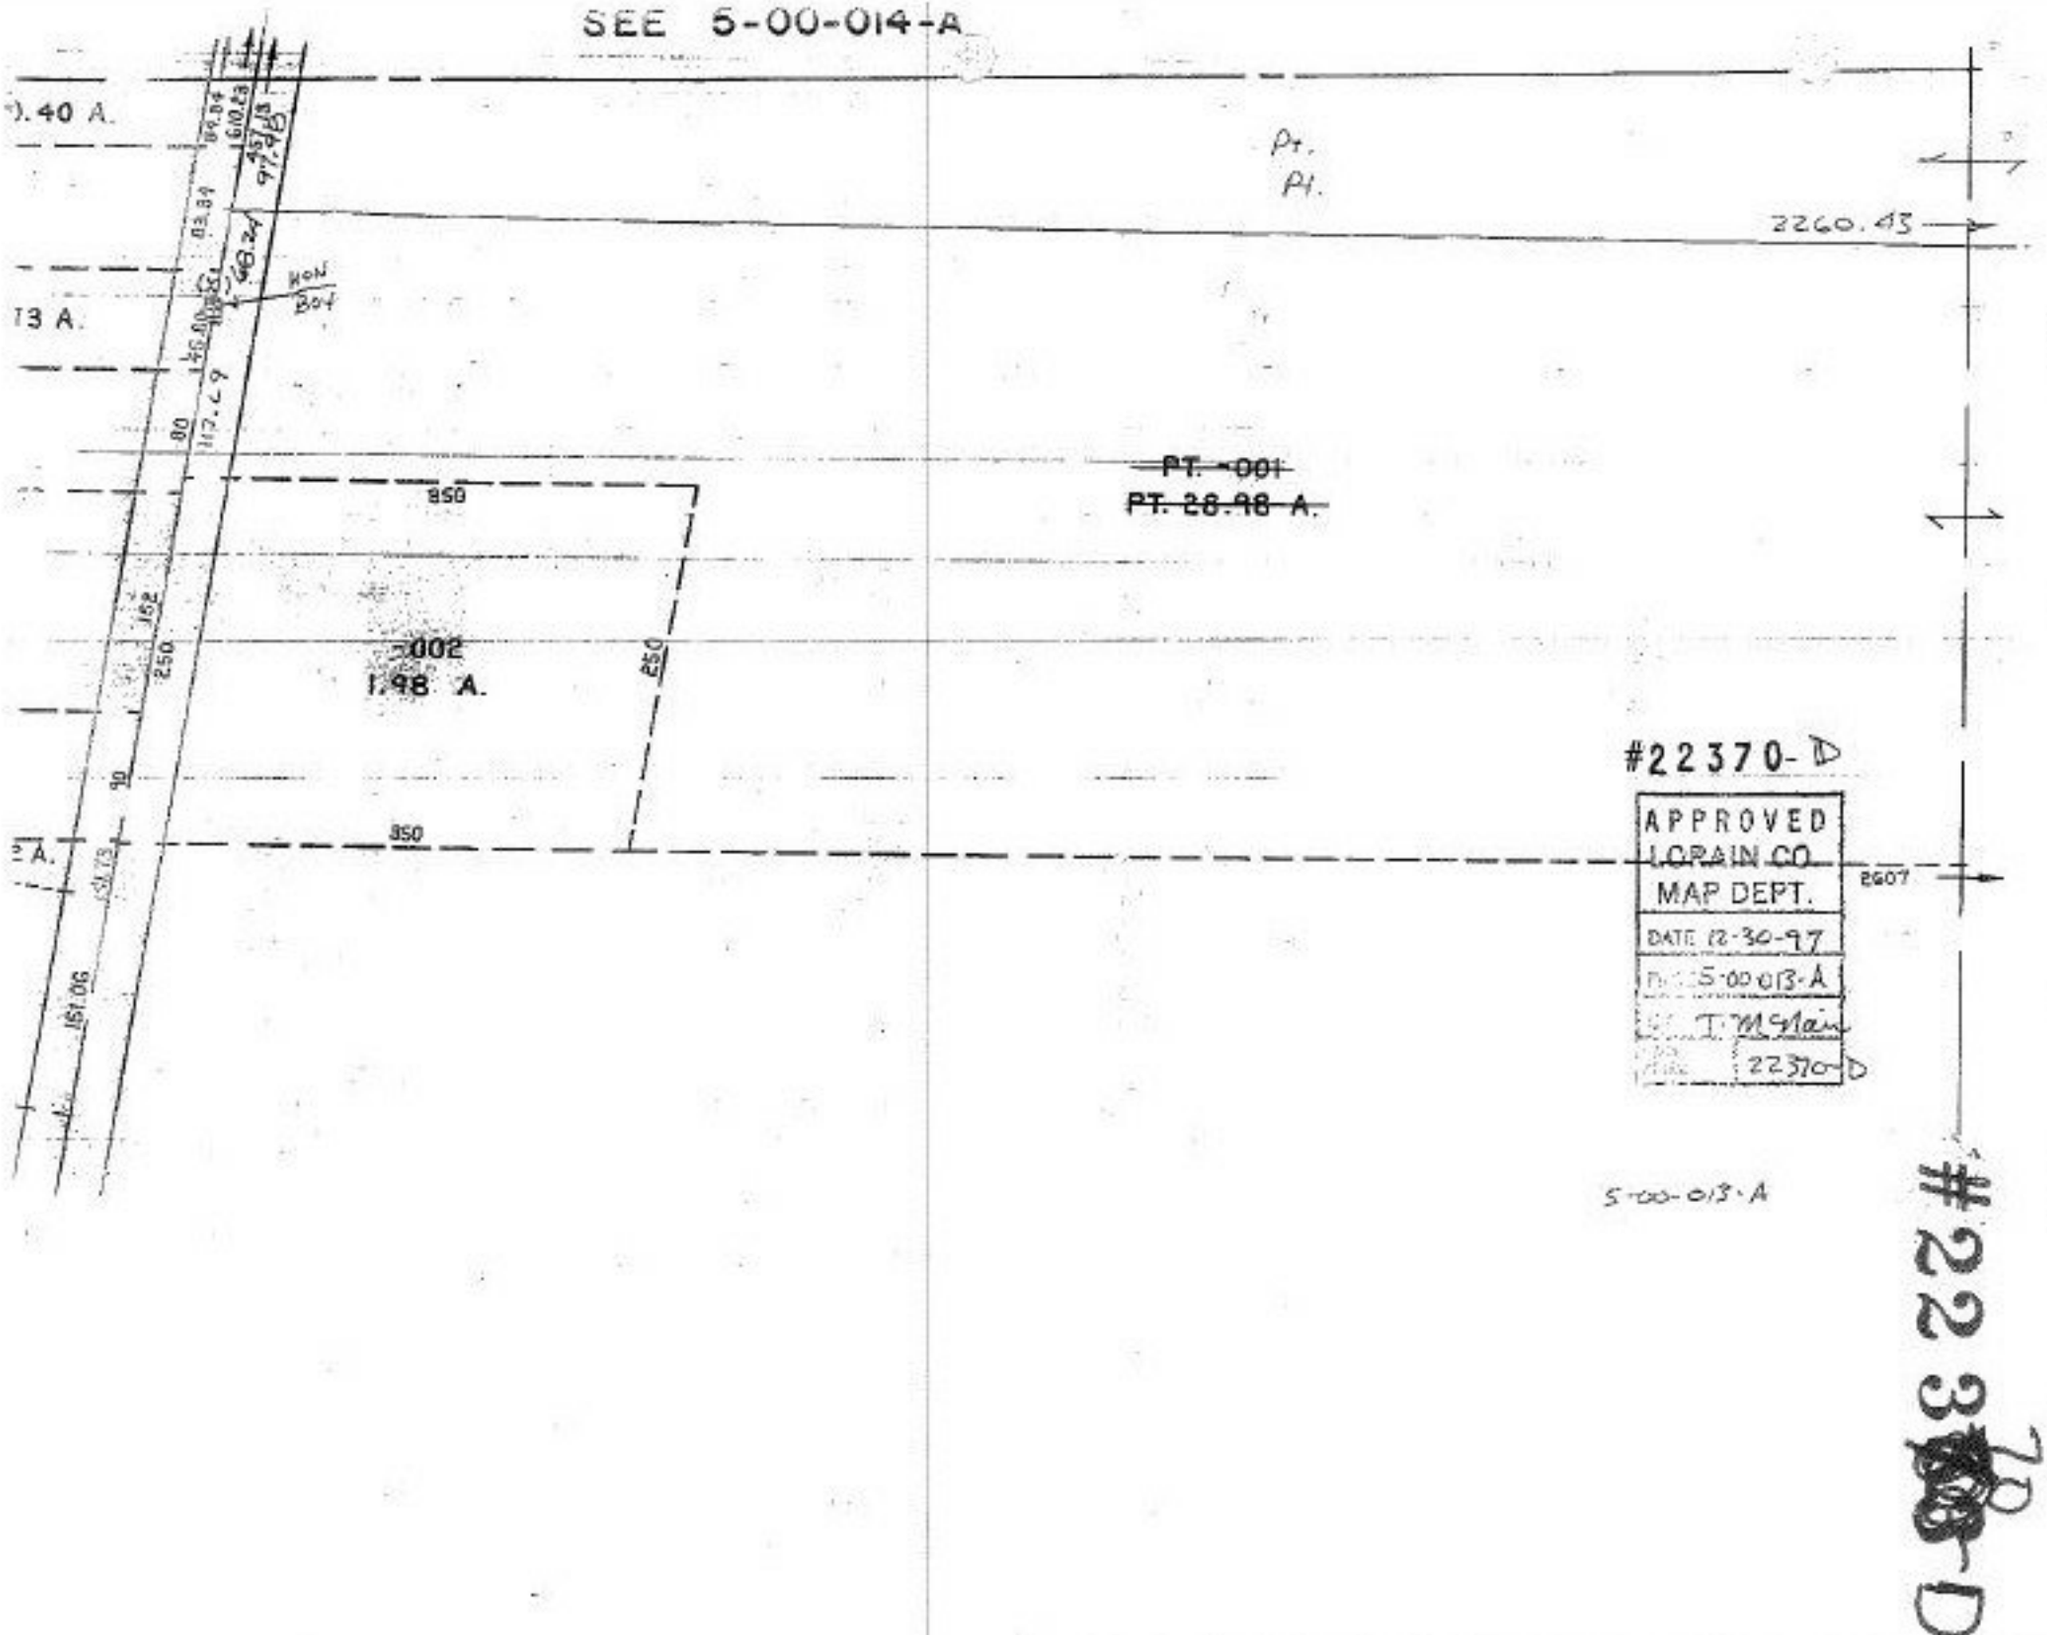
SEE 5-00-014-A
Pt.
Pl.
2260.43
PT. -001
PT. 28.98 A.
-002
1.98 A.
850
250
#22370-D
APPROVED
LORAIN CO
MAP DEPT.
DATE 12-30-97
5-00-013-A
I. McClain
22370-D
2607
5-00-013-A
#22370-D