PARENT PARCEL: 07-00-004-108-079

CHILD PARCEL: 07-00-004-108-080, 081

STARTING POINT: cl. of Chestnut Ridge & cl. of Lear Nagle Rd.

NO. 22376

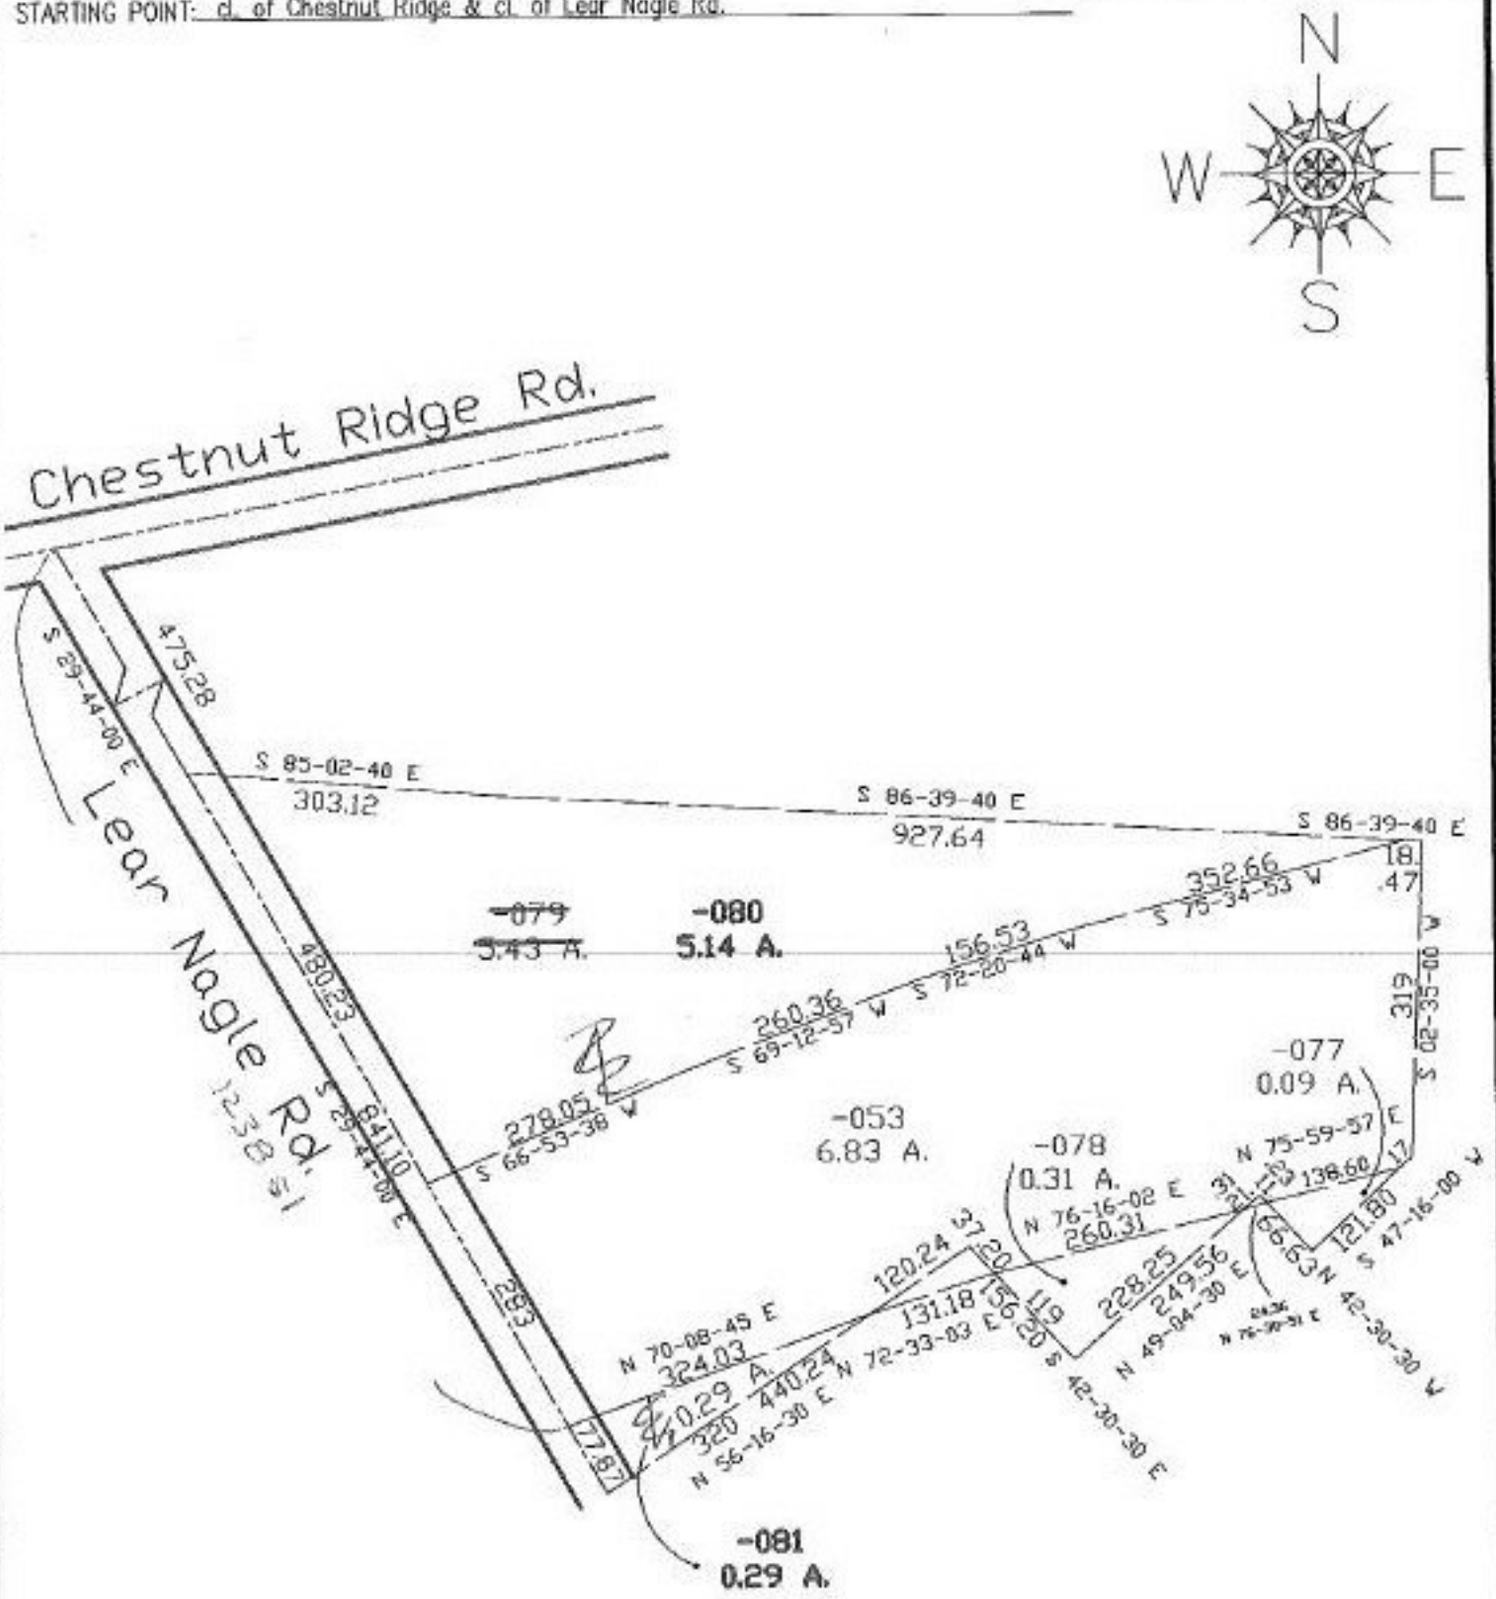

SPLITS/DEEDS PROCESSED

LORAIN COUNTY TAX MAP DEPARTMENT

226 MIDDLE AVE. ELYRIA, OHIO

SURVEYED BY: Dane Haponek & CE Richards

CLOSURE: 0.02:10,000

MAP PAGE(S): 7-00-004-C

APPROVED BY: kac DATE: 12/16/97

SCALE: 1"= 200 PRIOR INSTRUMENT: