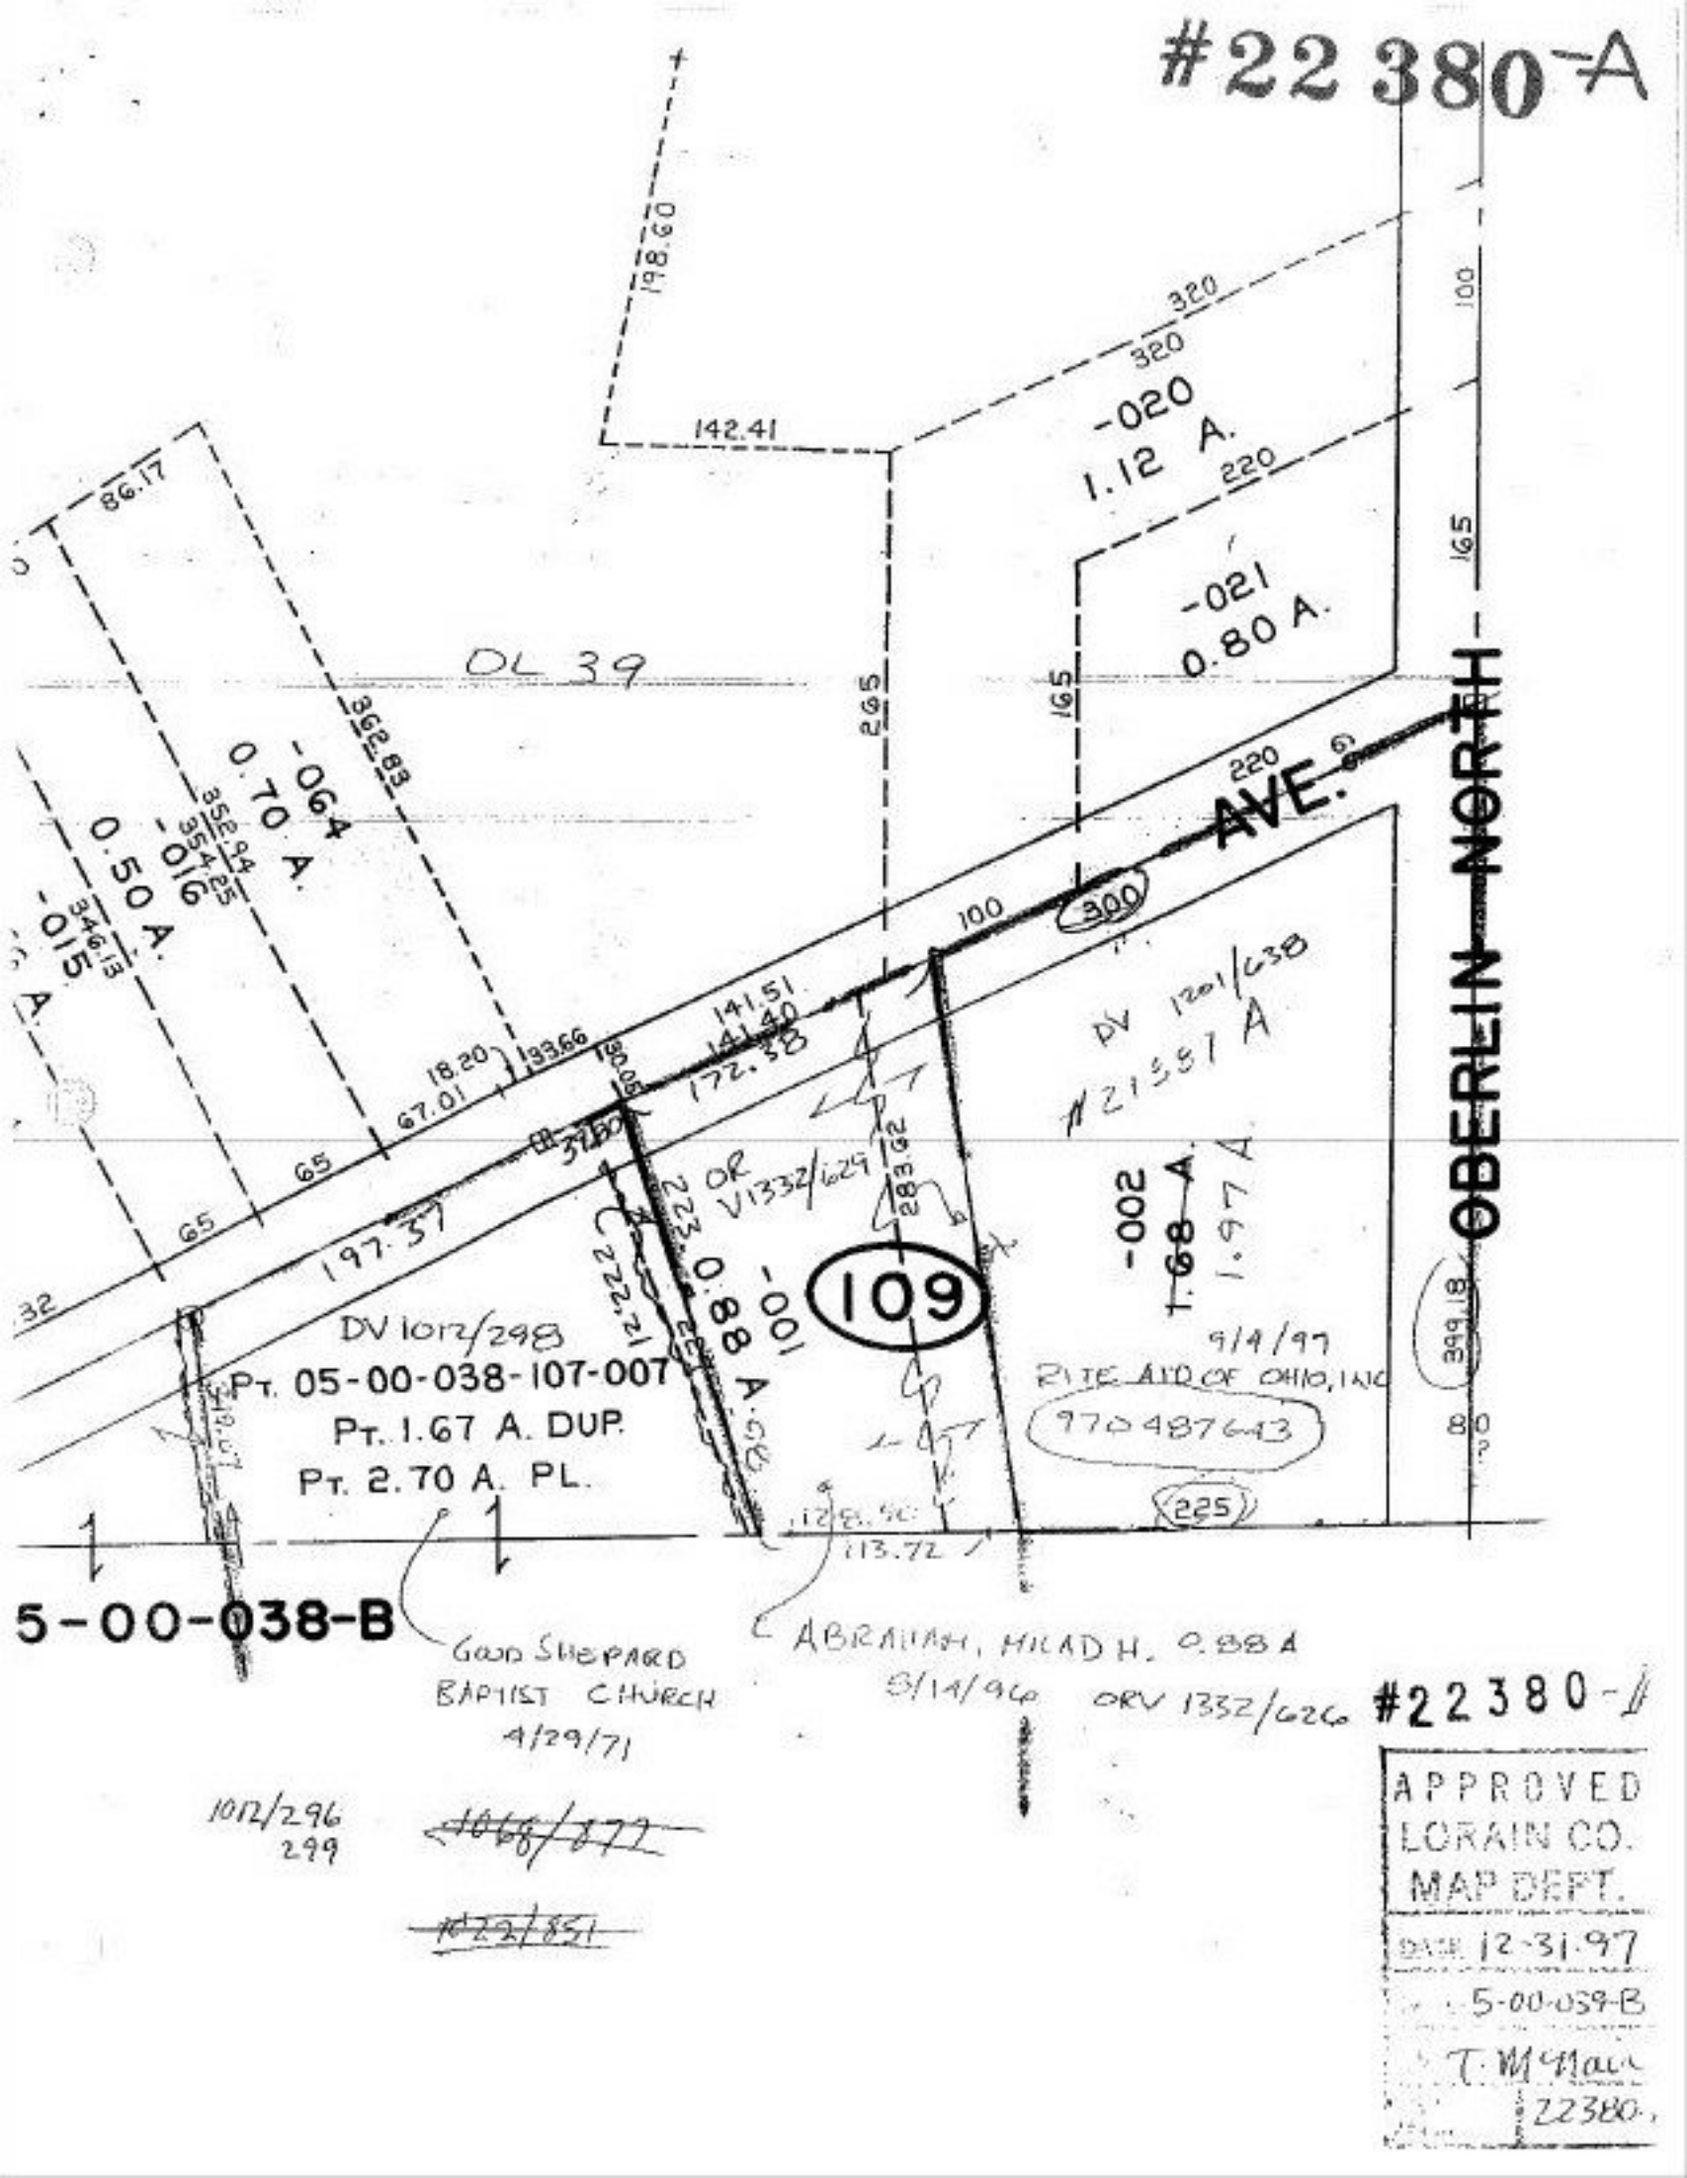
#22380-A
198.60
320
320
142.41
-020
1.12 A.
220
100
165
-021
0.80 A.
OL 39
265
165
86.17
352.83
-064
0.70 A.
352.94
354.25
-016
0.50 A.
346.13
-015
220
6
AVE.
OBERLIN NORTH
300
100
141.51
141.40
172.38
18.20
67.01
33.66
38.05
DV 1201/638
#21551 A
65
65
197.37
32
283.62
222.21
223.25
0.88 A.
-001
109
DV 1012/298
PT. 05-00-038-107-007
PT. 1.67 A. DUP.
PT. 2.70 A. PL.
-002
1.68 A.
1.97 A.
9/4/97
RITE AID OF OHIO, INC
97048743
399.18
225
112.50
113.72
5-00-038-B
GOOD SHEPARD
BAPTIST CHURCH
4/29/71
1012/296
299
ABRAHAH, HILAD H. 0.88 A
5/14/96 ORV 1332/626
#22380-B
APPROVED
LORAIN CO.
MAP DEPT.
DATE 12-31-97
5-00-039-B
T. McMaw
22380.