#22383 D

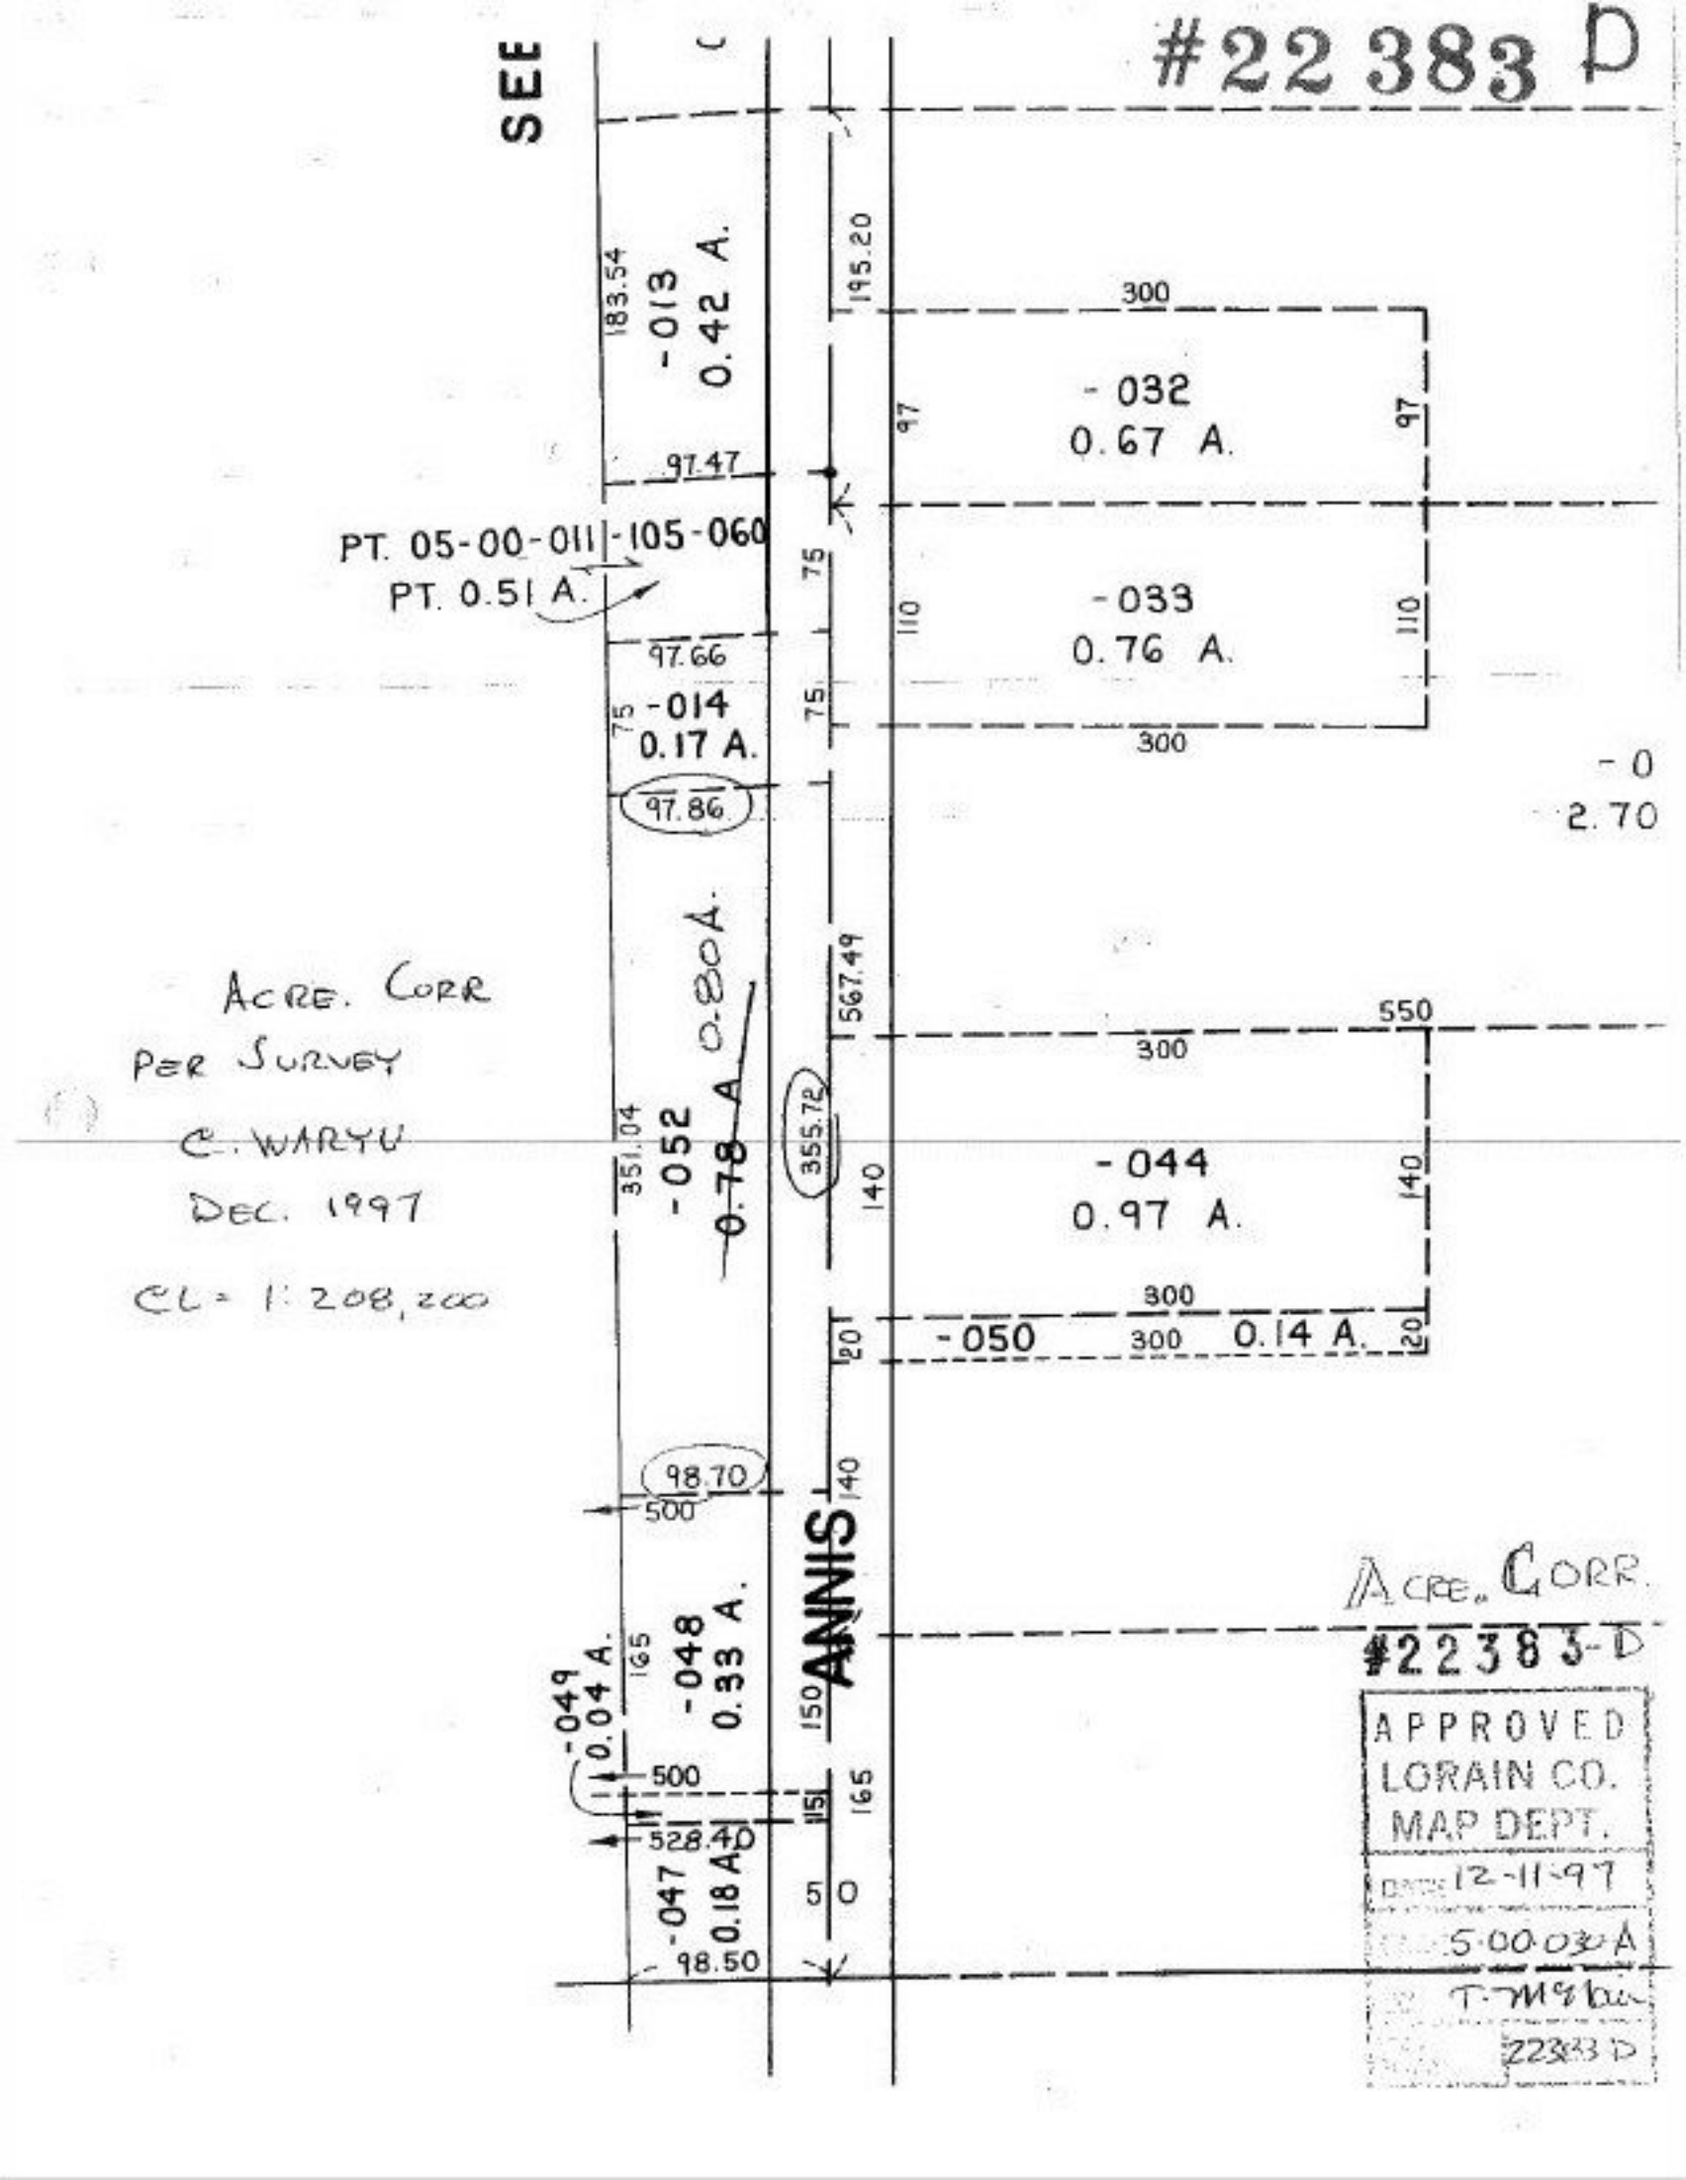
SEE
-013
0.42 A.
183.54
195.20
97.47
300
-032
0.67 A.
97
97
PT. 05-00-011-105-060
PT. 0.51 A.
97.66
75
-033
0.76 A.
110
110
75
75
-014
0.17 A.
300
97.86
-0
2.70
ACRE. CORR
PER SURVEY
C. WARYU
DEC. 1997
CL = 1:208,200
0.80 A.
567.49
550
300
351.04
-052
0.78 A.
355.72
140
-044
0.97 A.
140
300
-050
300
0.14 A.
20
20
98.70
500
ANNIS
140
150
ACRE. CORR.
#22383-D
-049
0.04 A.
-048
0.33 A.
165
500
151
165
528.40
-047
0.18 A.
51
0
98.50
APPROVED
LORAIN CO.
MAP DEPT.
DATE 12-11-97
5.0003 A
T-M & bu
22383 D