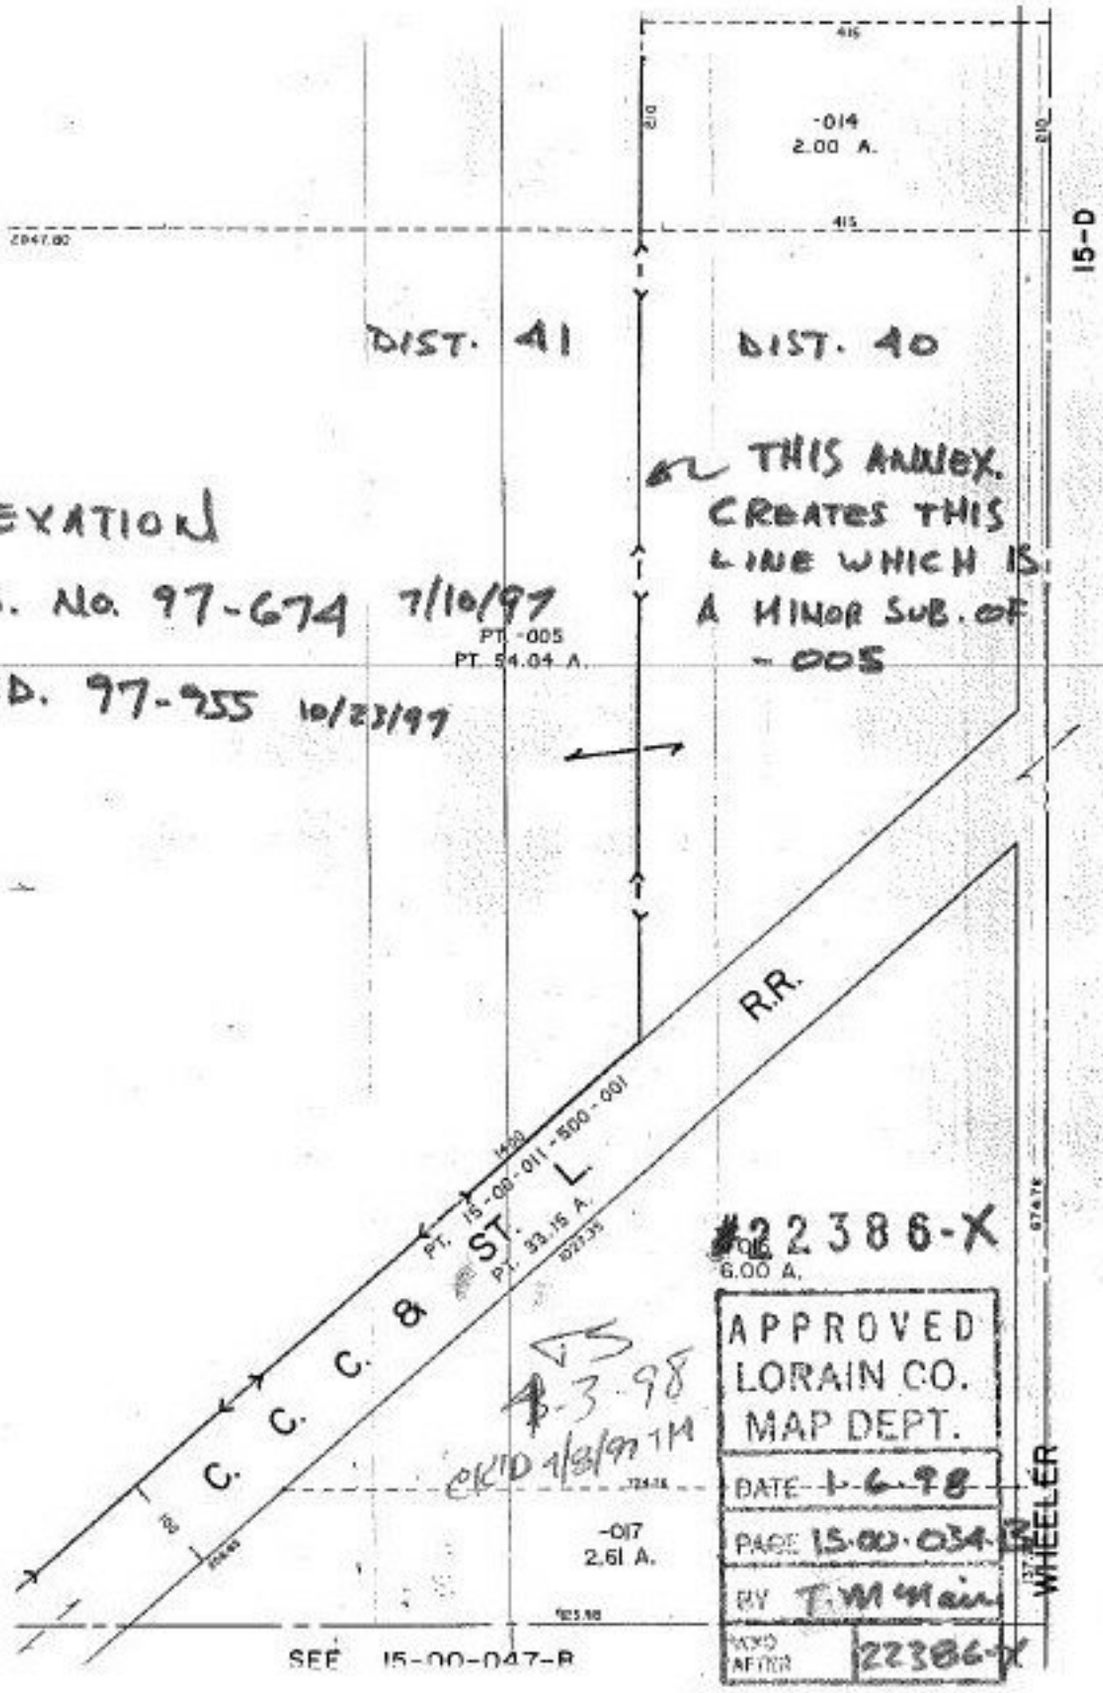

-014
2.00 A.
15-D
DIST. 41
DIST. 40
THIS ANNEX. CREATES THIS LINE WHICH IS A MINOR SUB. OF -005
ANNEXATION
RES. No. 97-674 7/10/97
ORD. 97-955 10/23/97
PT. -005
PT. 54.04 A.
R.R.
C. C. C. & ST. L.
PT. 15-00-011-500-001
PT. 33.15 A.
#22386-X
6.00 A.
APPROVED
LORAIN CO.
MAP DEPT.
DATE 1-6-98
PAGE 15-00-034-B
BY T. McMain
VOID AFTER 22386-X
4-3-98
CK'D 1/8/97 TM
-017
2.61 A.
WHEELER
SEE 15-00-047-B