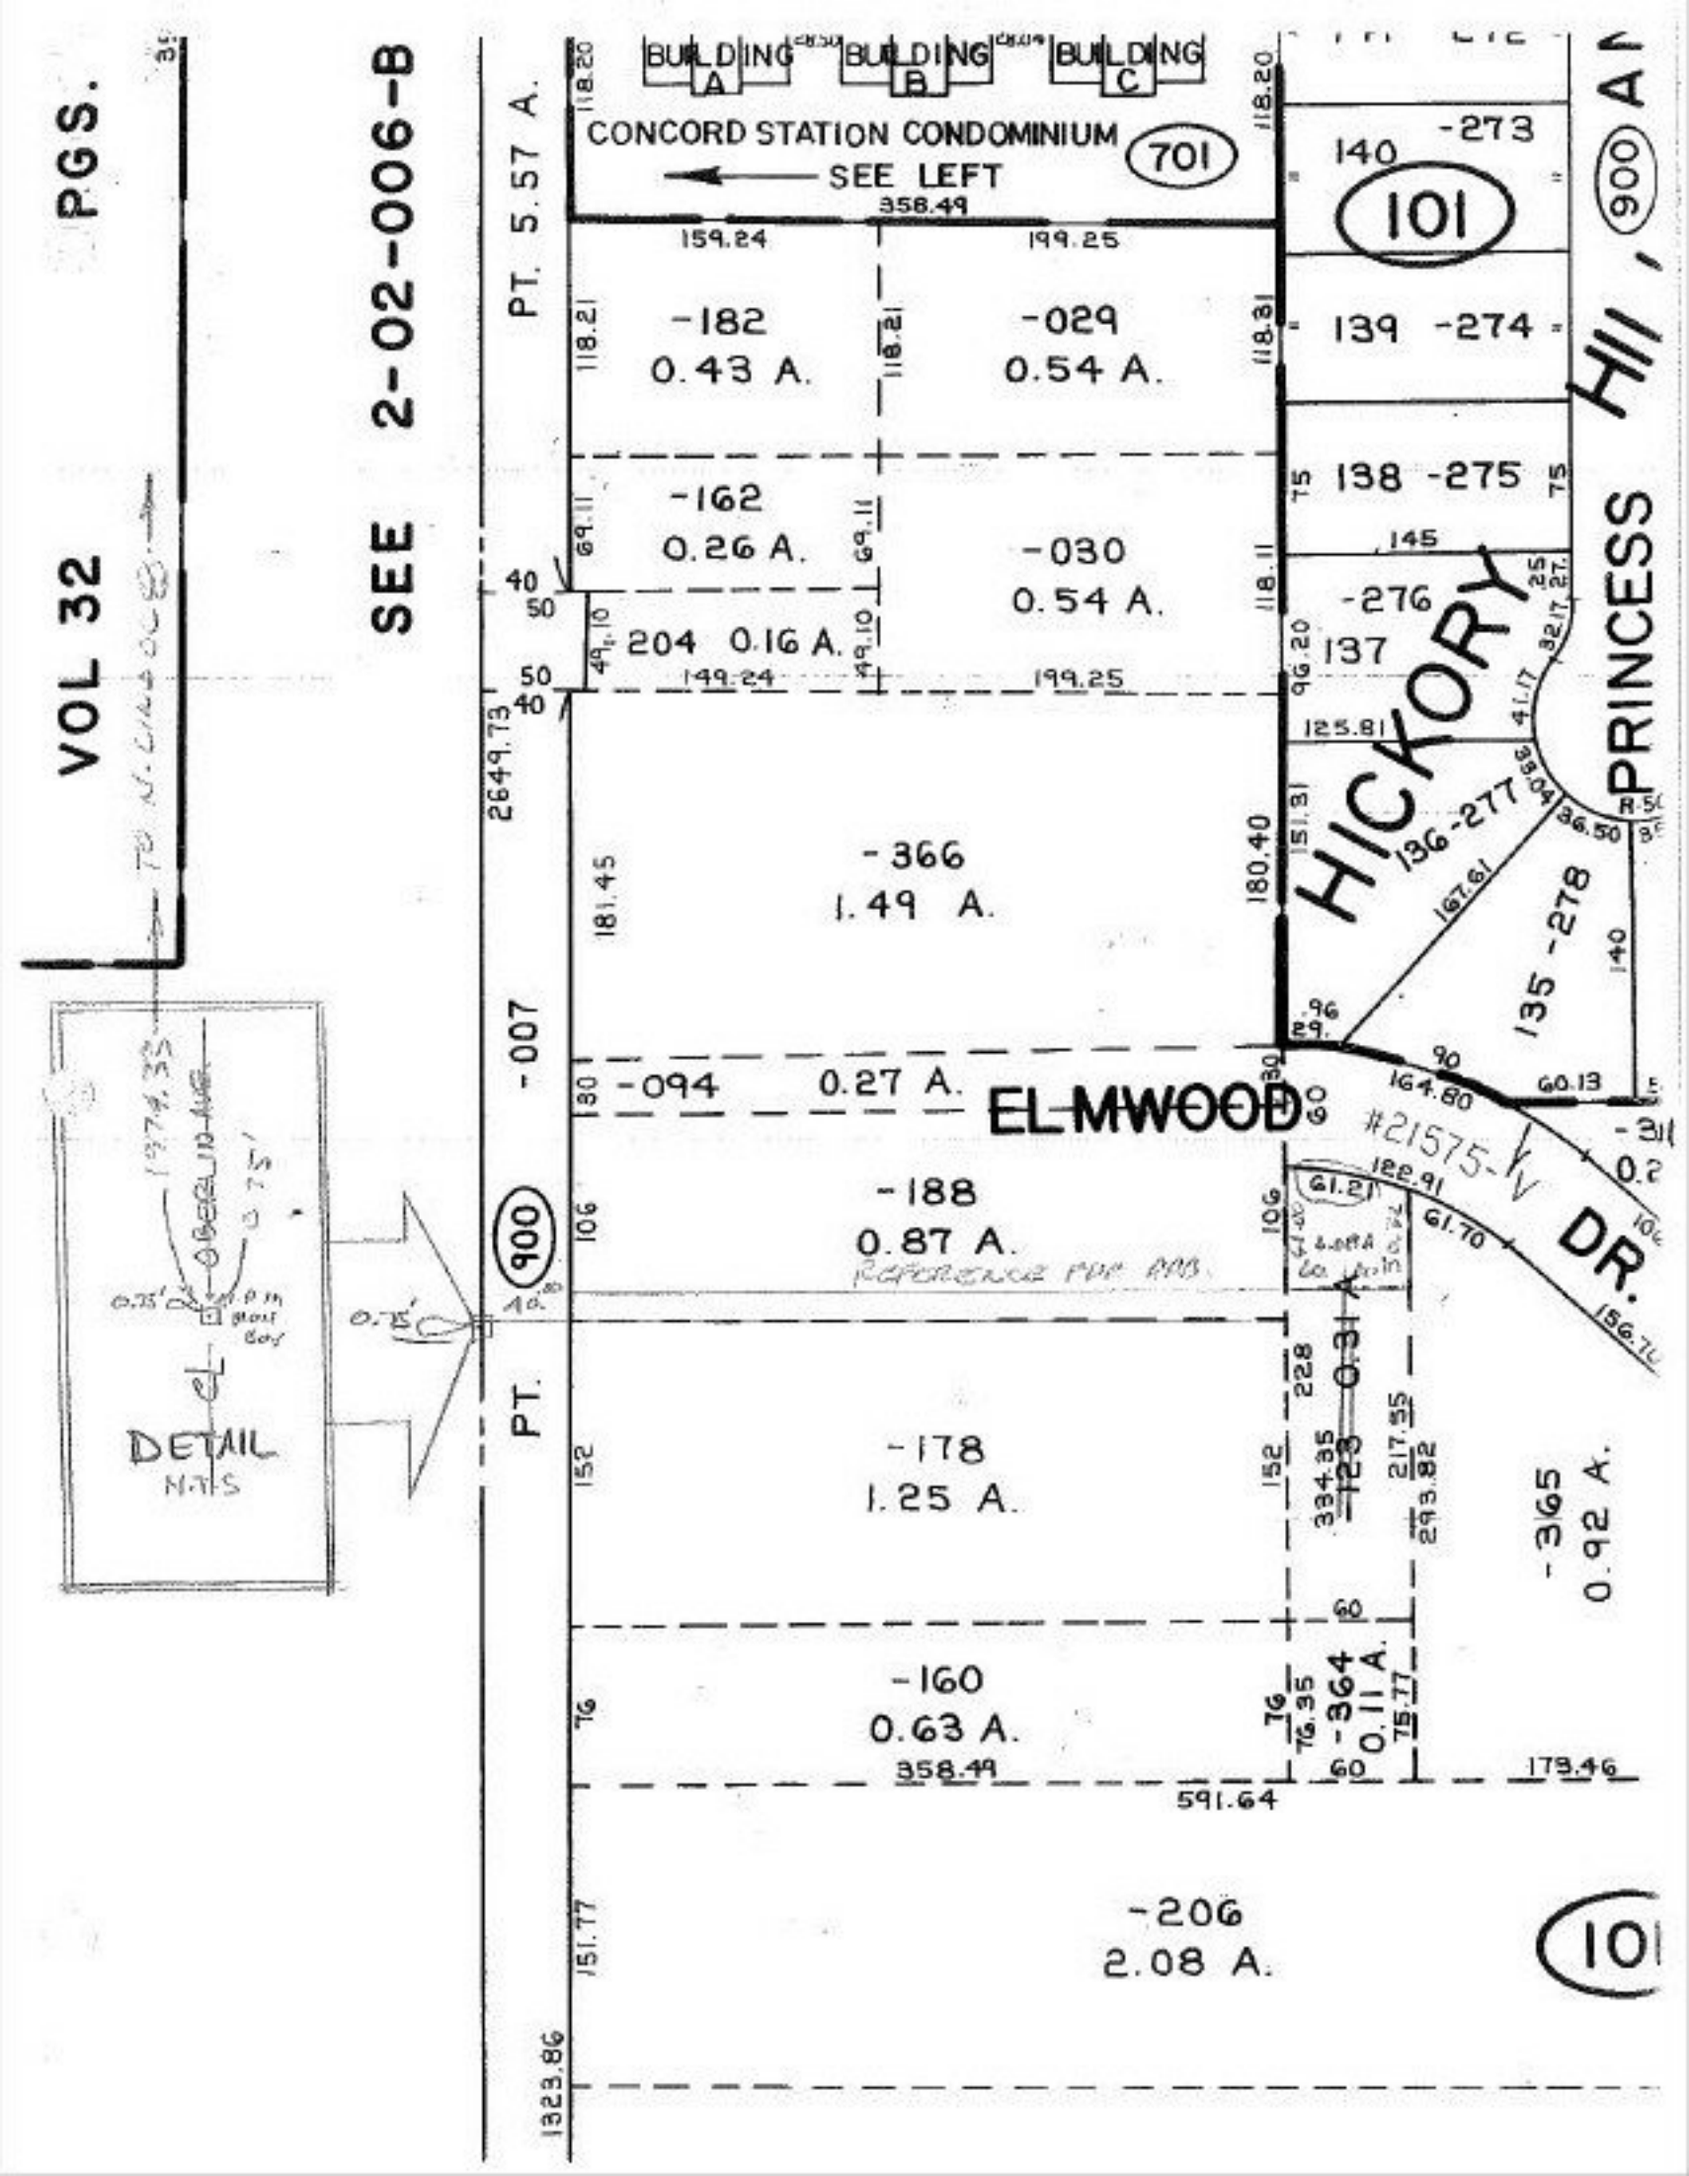
VOL 32
PGS.
SEE 2-02-006-B
PT. 5.57 A.
BUILDING A
BUILDING B
BUILDING C
CONCORD STATION CONDOMINIUM
701
SEE LEFT
358.49
159.24
199.25
-182
0.43 A.
-029
0.54 A.
-162
0.26 A.
-030
0.54 A.
204 0.16 A.
2649.73
-366
1.49 A.
-007
-094 0.27 A.
-188
0.87 A.
900
PT.
-178
1.25 A.
-160
0.63 A.
-206
2.08 A.
1323.86
591.64
140 -273
101
139 -274
138 -275
145
-276
137
HICKORY
136-277
135-278
PRINCESS
ELMWOOD
DR.
#21575-V
-311
-365
0.92 A.
-364
0.11 A.
DETAIL
N.T.S