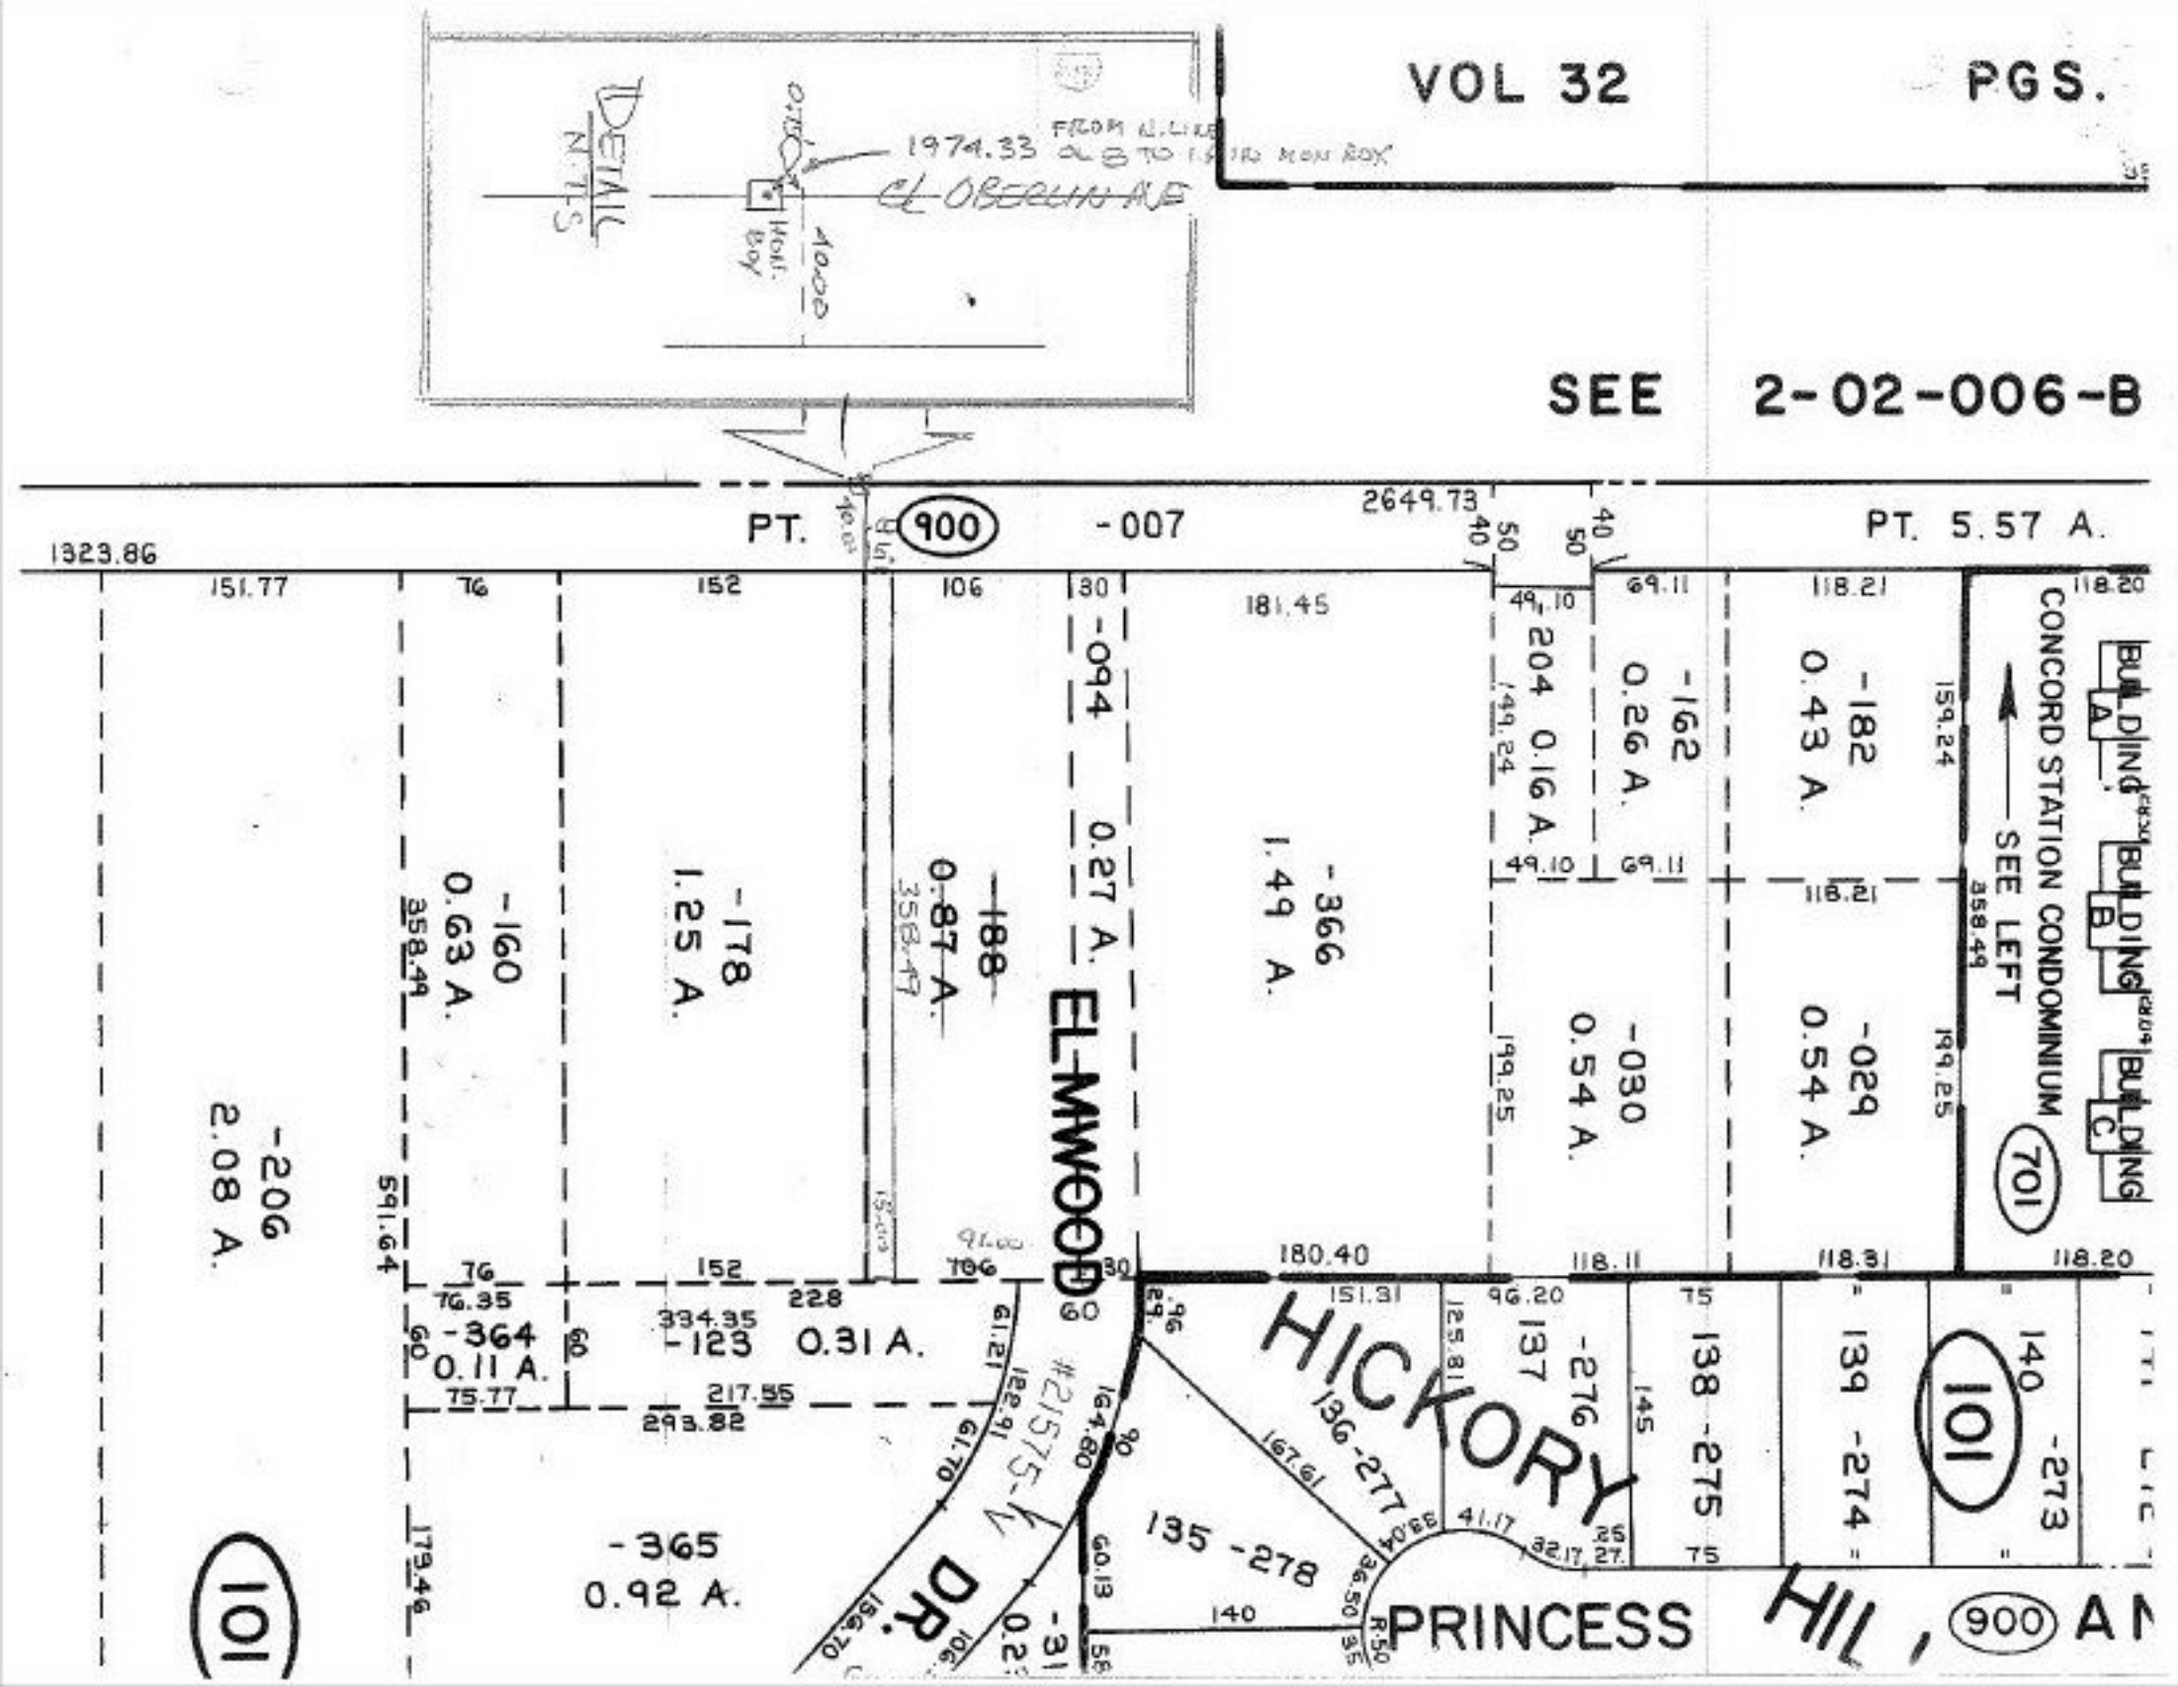
VOL 32
PGS.
SEE 2-02-006-B
DETAIL N.T.S.
1974.33
Hyd. Box
PT. 900 -007
2649.73
PT. 5.57 A.
1323.86
-094 0.27 A.
-188 0.87 A.
-366 1.49 A.
-204 0.16 A.
-162 0.26 A.
-182 0.43 A.
-030 0.54 A.
-029 0.54 A.
CONCORD STATION CONDOMINIUM
SEE LEFT
701
BUILDING A
BUILDING B
BUILDING C
-160 0.63 A.
-178 1.25 A.
-206 2.08 A.
-364 0.11 A.
-123 0.31 A.
-365 0.92 A.
EL-MWOOD
HICKORY
136-277
137 -276
138 -275
139 -274
140 -273
135 -278
#21575-Y
DR.
PRINCESS
101
900