PARENT PARCEL: 10-00-006-126-015, 072

CHILD PARCEL: 10-00-006-126-128, 129, 130

STARTING POINT: cl. of Robson Rd. & cl. of Grafton Rd.

NO. 22398

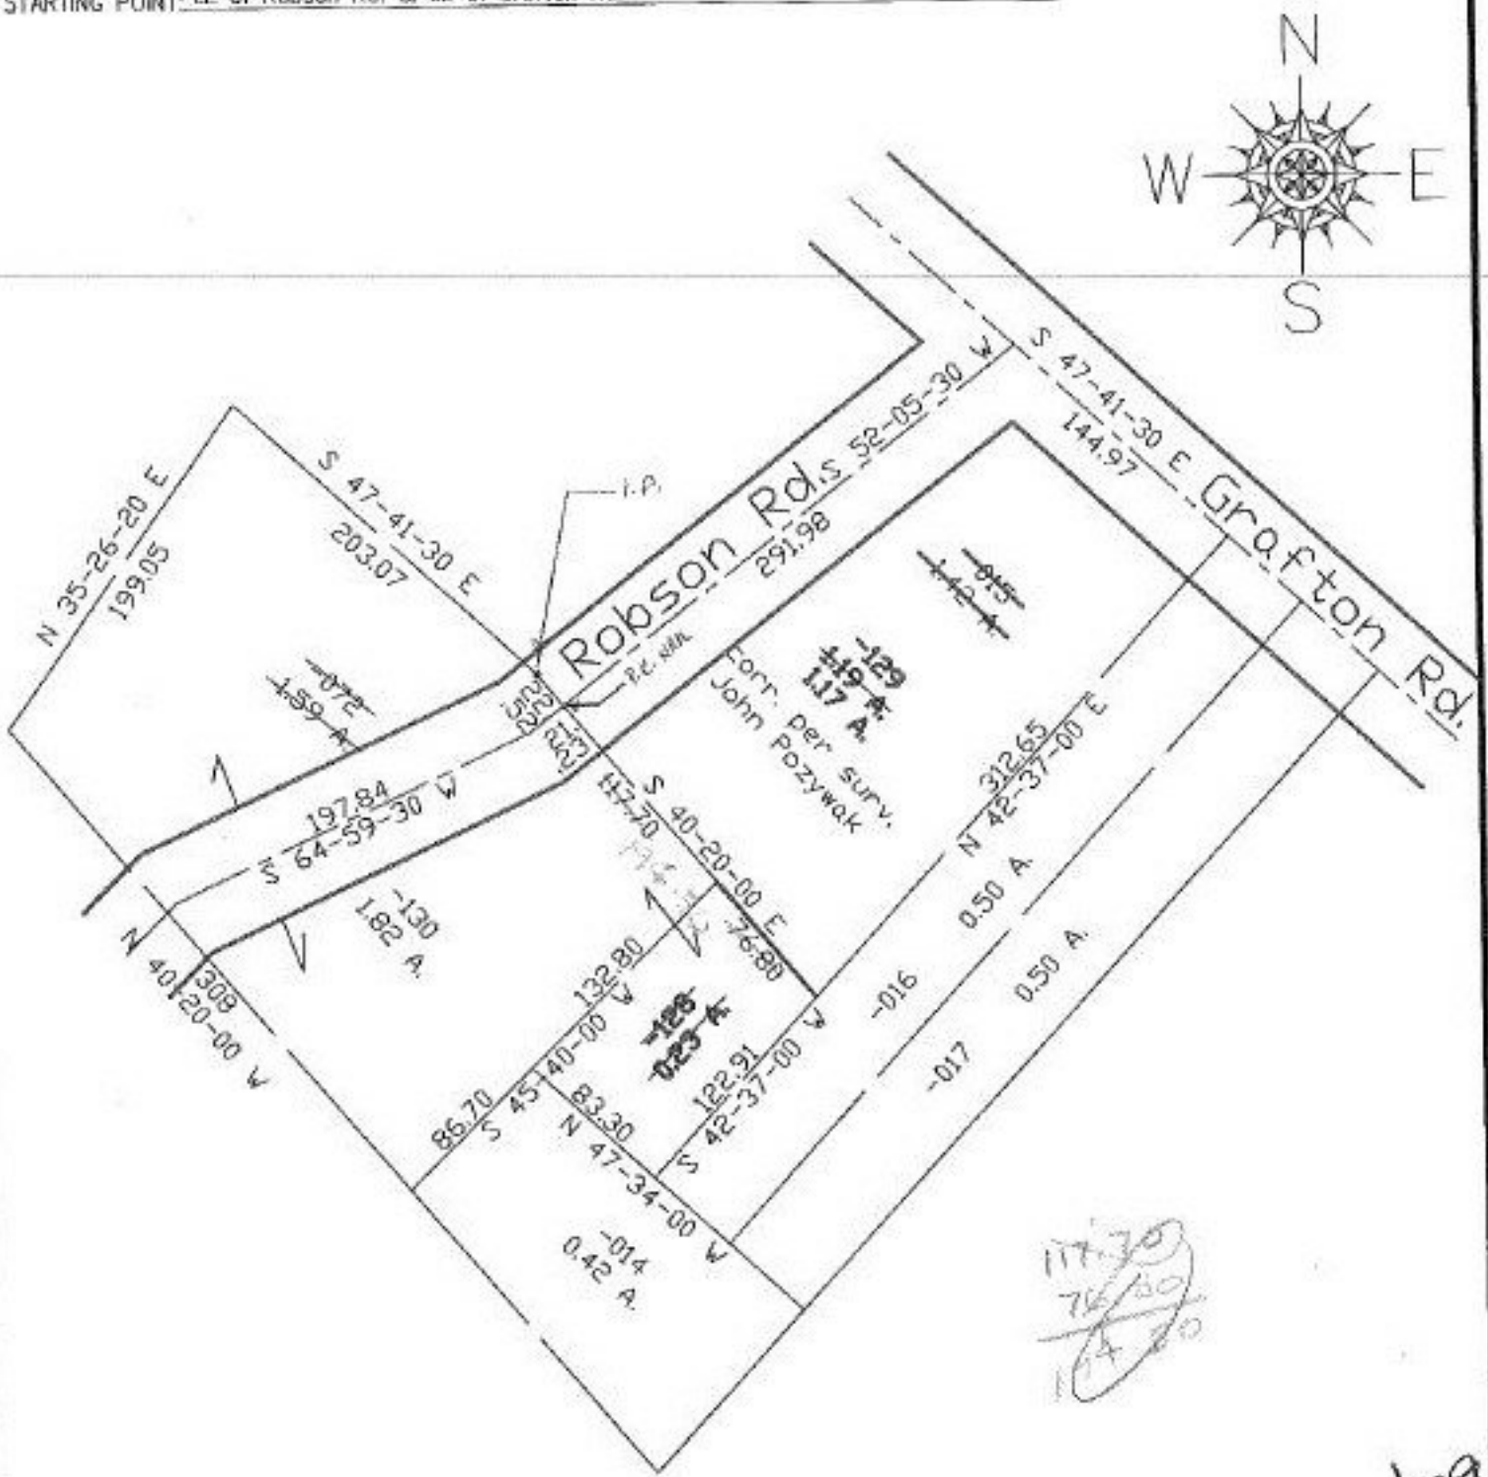

SPLITS/DEEDS PROCESSED

LORAIN COUNTY TAX MAP DEPARTMENT

226 MIDDLE AVE. ELYRIA, OHIO

SURVEYED BY: John Pozywok

CLOSURE:

MAP PAGE(S): 10-00-006-G, H DATE: 1/6/98

APPROVED BY: kac SCALE: 1"= 100

PRIOR INSTRUMENT: OR 404/749 OR 1042/377