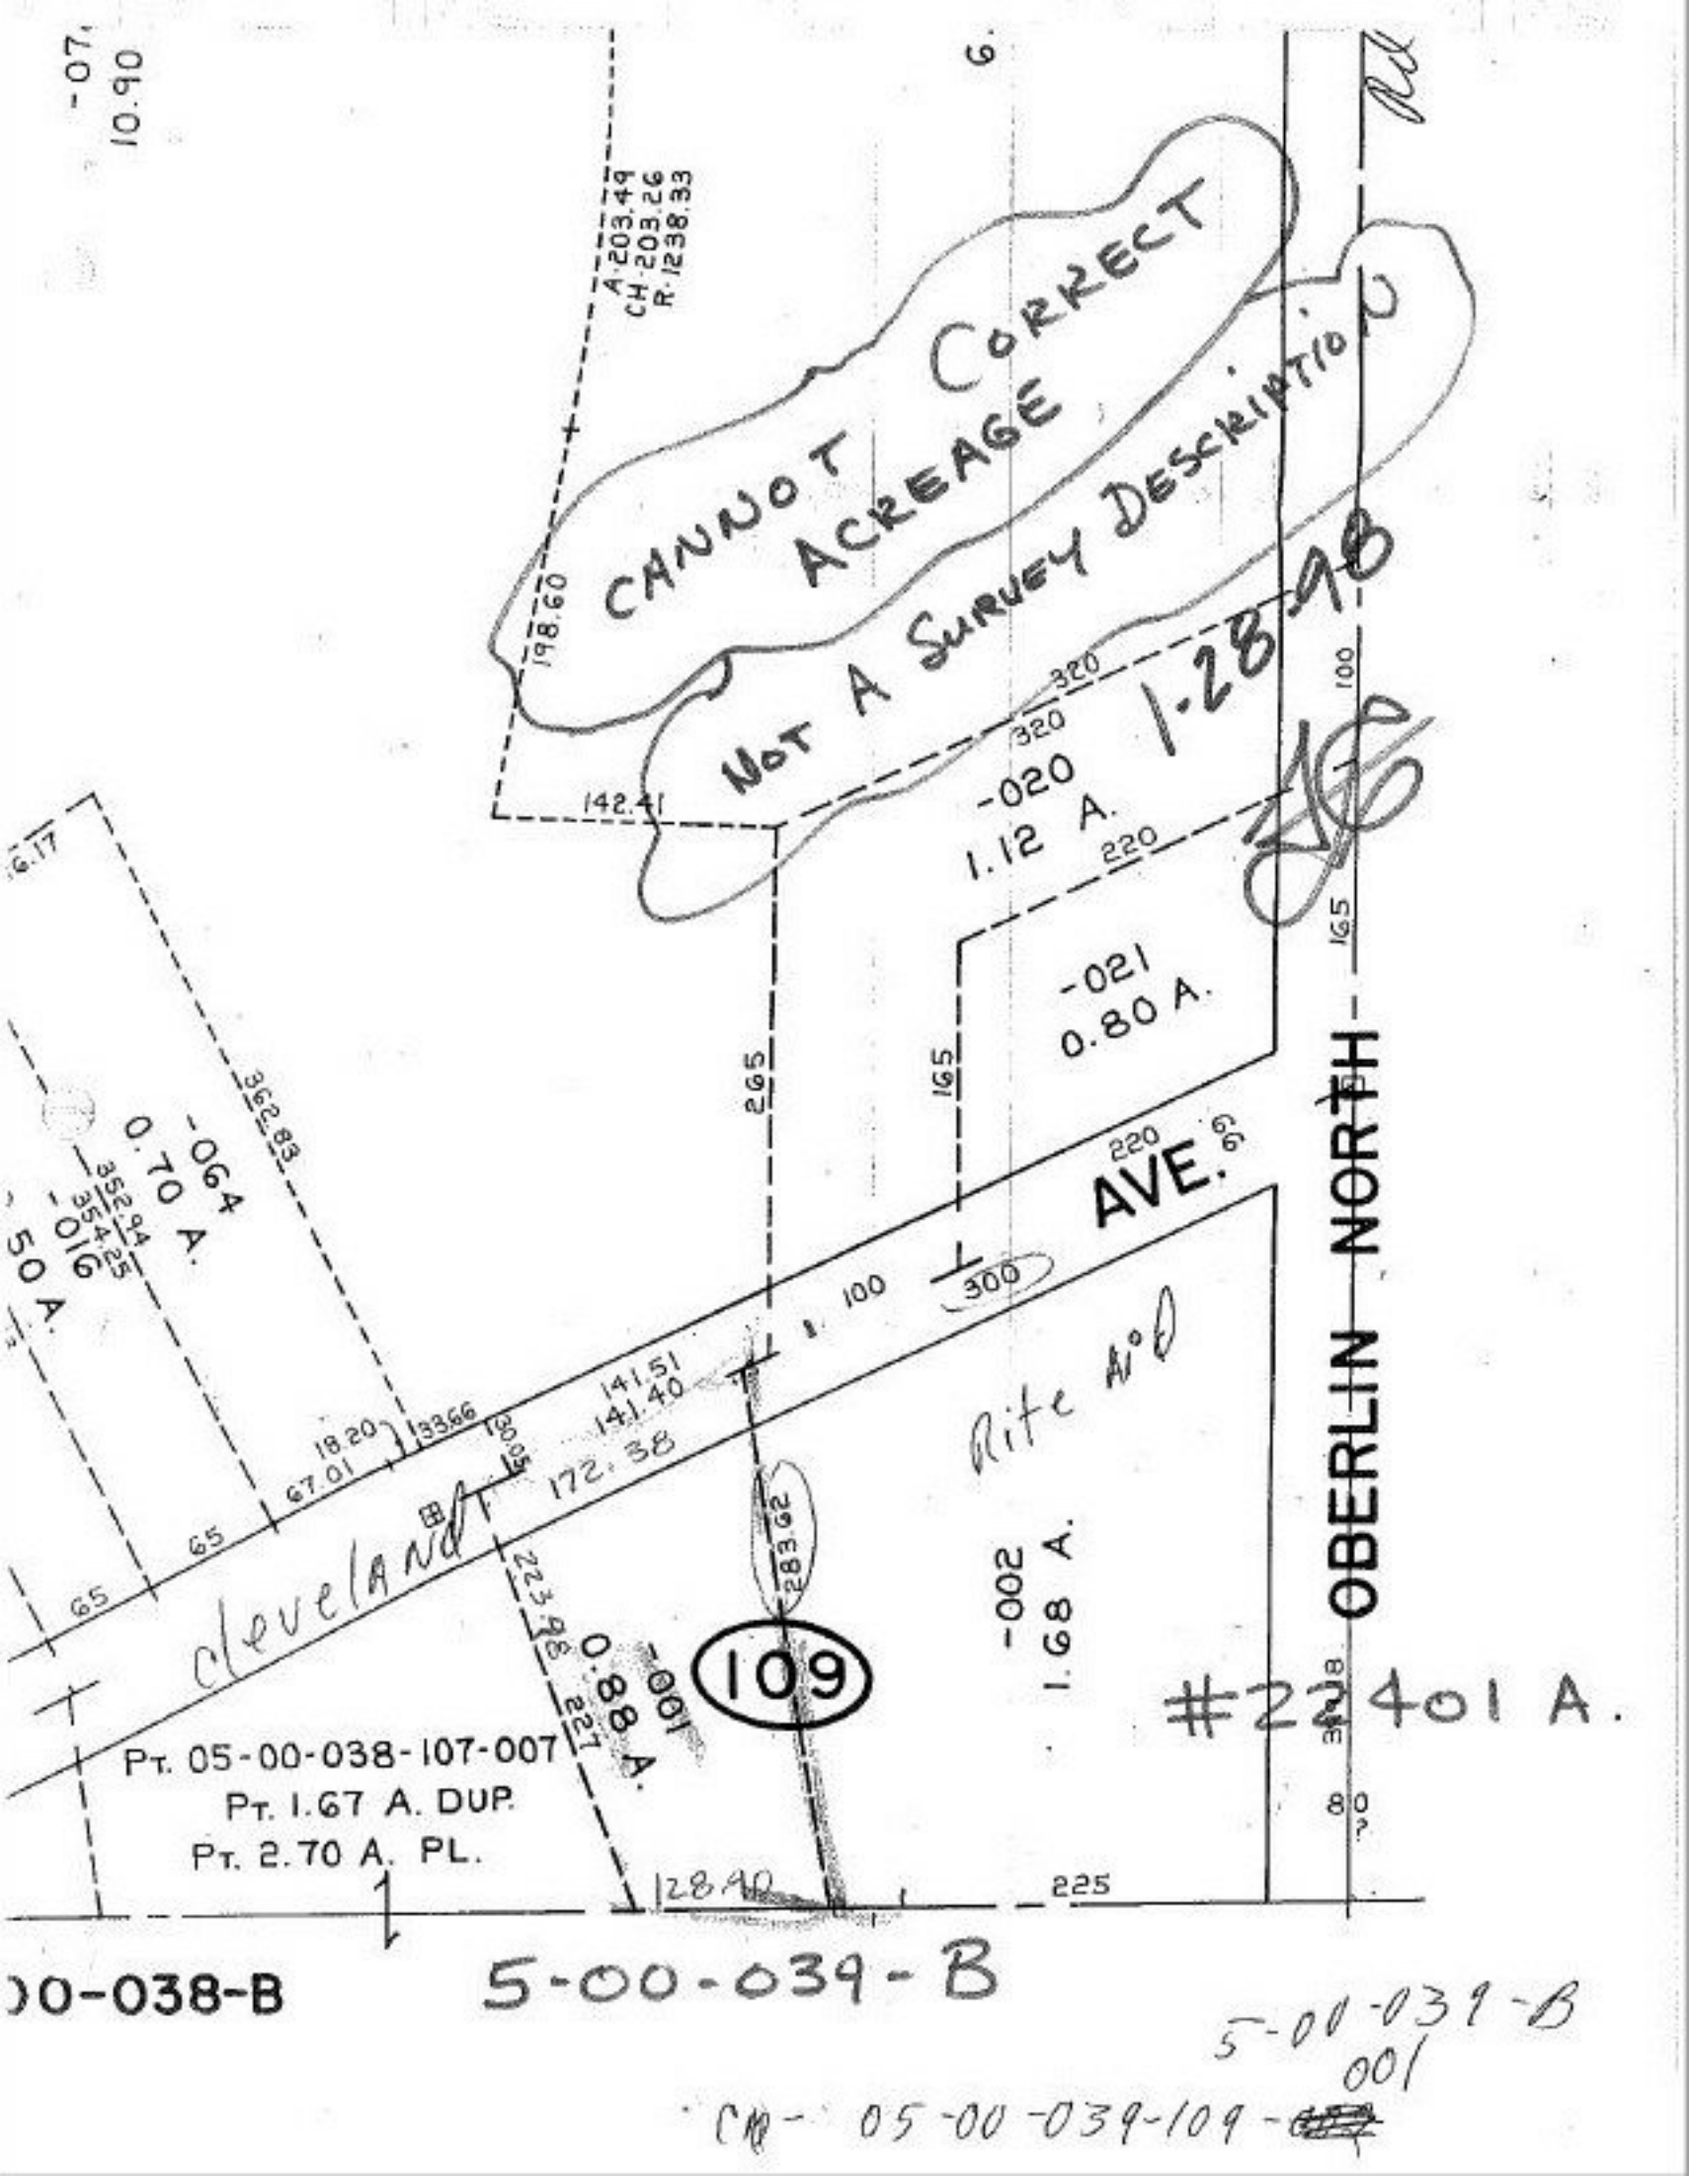
CANNOT CORRECT
ACREAGE
NOT A SURVEY DESCRIPTION
1-28-98
A-203.49
CH-203.26
R-1238.33
198.60
142.41
320
320
100
-020
1.12 A.
220
165
-021
0.80 A.
265
165
OBERLIN NORTH
AVE.
66
220
300
100
141.51
141.40
172.38
283.62
Rite Aid
-002
1.68 A.
#2 2401 A.
Cleveland
65
65
67.01
18.20
336.66
352.83
352.94
354.25
-064
0.70 A.
-016
50 A.
223.98
221
-001
0.88 A.
109
Pt. 05-00-038-107-007
Pt. 1.67 A. DUP.
Pt. 2.70 A. PL.
128.90
225
80
00-038-B
5-00-039-B
5-00-039-B
001
CM- 05-00-039-109-