PARENT PARCEL: 21-03-000-000-018, 068, 069

CHILD PARCEL: 21-03-000000-082 thru -090

STARTING POINT: cl. of Clark Rd. & cl. of Stewart Rd.

NO. 22403

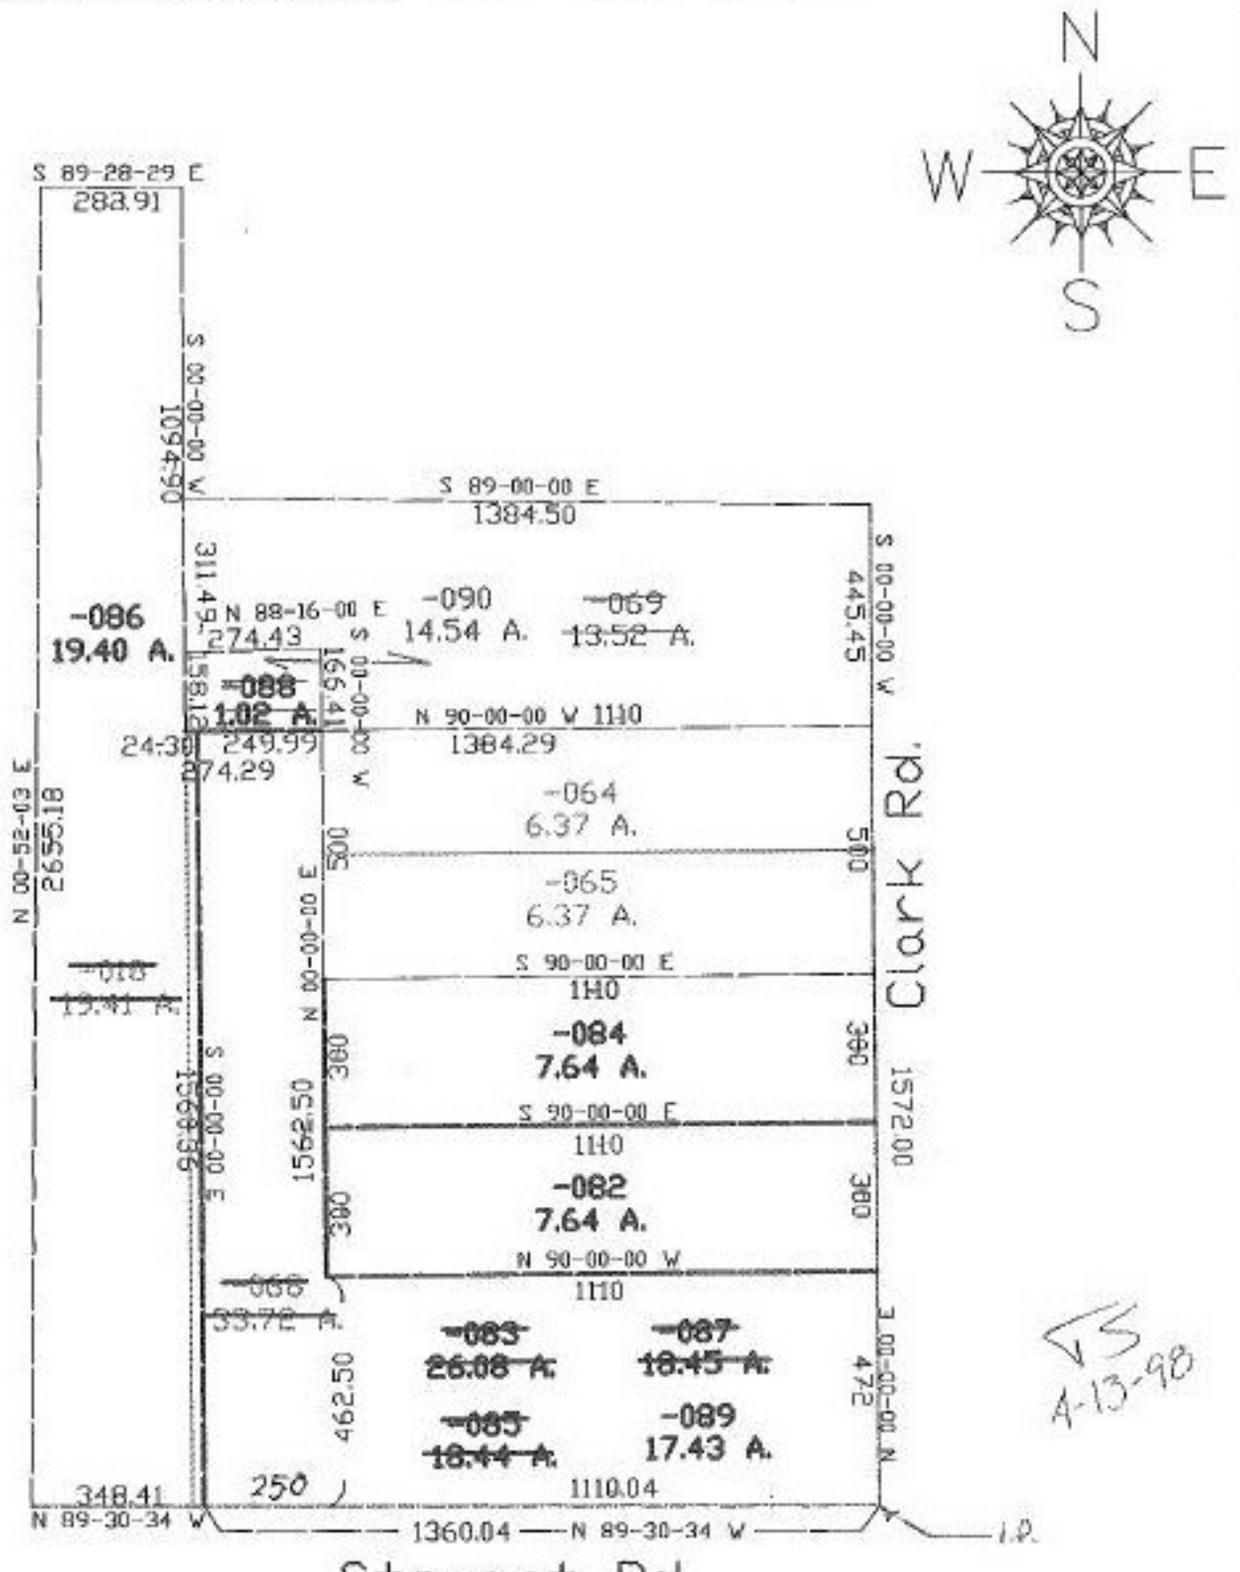

SPLITS/DEEDS PROCESSED

LORAIN COUNTY TAX MAP DEPARTMENT

226 MIDDLE AVE. ELYRIA, OHIO

SURVEYED BY: David L. Elwell

CLOSURE: 0.21:10,000

MAP PAGE(S): 21-E

APPROVED BY: kac DATE: 1/20/98

SCALE: 1"= 400 PRIOR INSTRUMENT: DV 1178/176