PARENT PARCEL: 02-02-003-102-012

CHILD PARCEL:

STARTING POINT:

NO. 22404-A

Ref:
DV 1287/541 8/24/01
OR 1017/850 12/9/94
OR 1210/840 12/17/97

N
W E
S

(102) - 012 ACREAGE CORRECTION

(900) -004 ADD TO DUPLICATE FOR SR 58 R/W

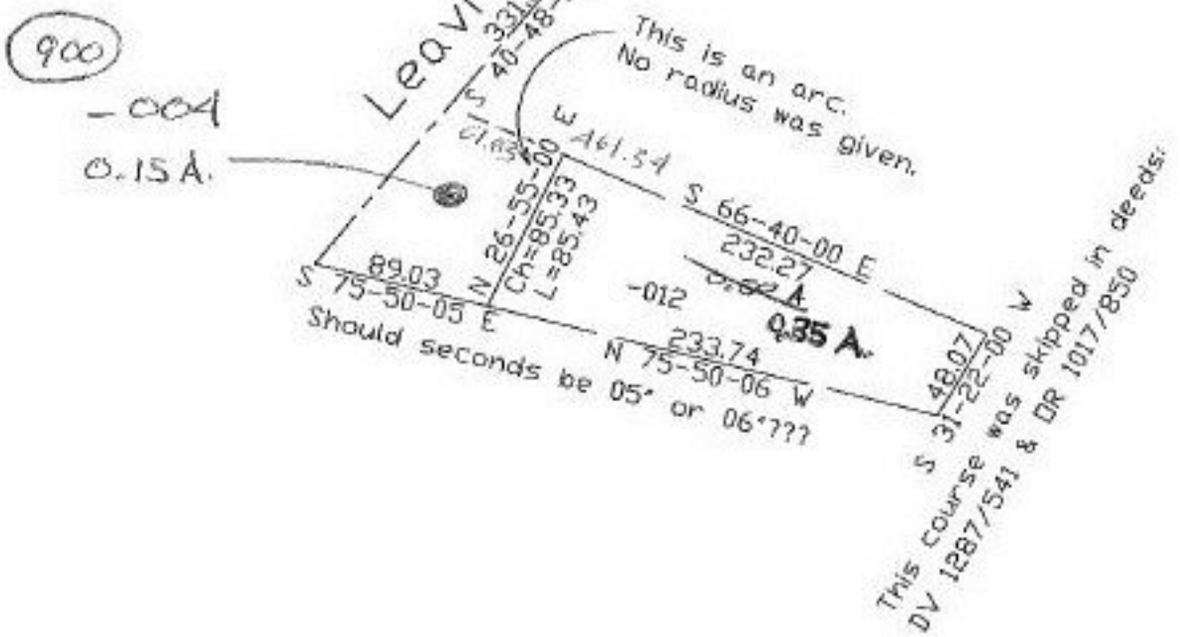

(900)
-004
0.15 A.

DV 1287/541
OR 1017/850
#97005796
OR 1210/840

SPLITS/DEEDS PROCESSED
LORAIN COUNTY TAX MAP DEPARTMENT
226 MIDDLE AVE. ELYRIA, OHIO

SURVEYED BY: Ray E. Hollis
CLOSURE: 0.35:10,000
MAP PAGE(S): 02-02-003
APPROVED BY: kac DATE: 1/27/98
SCALE: 1" = 100 PRIOR INSTRUMENT: