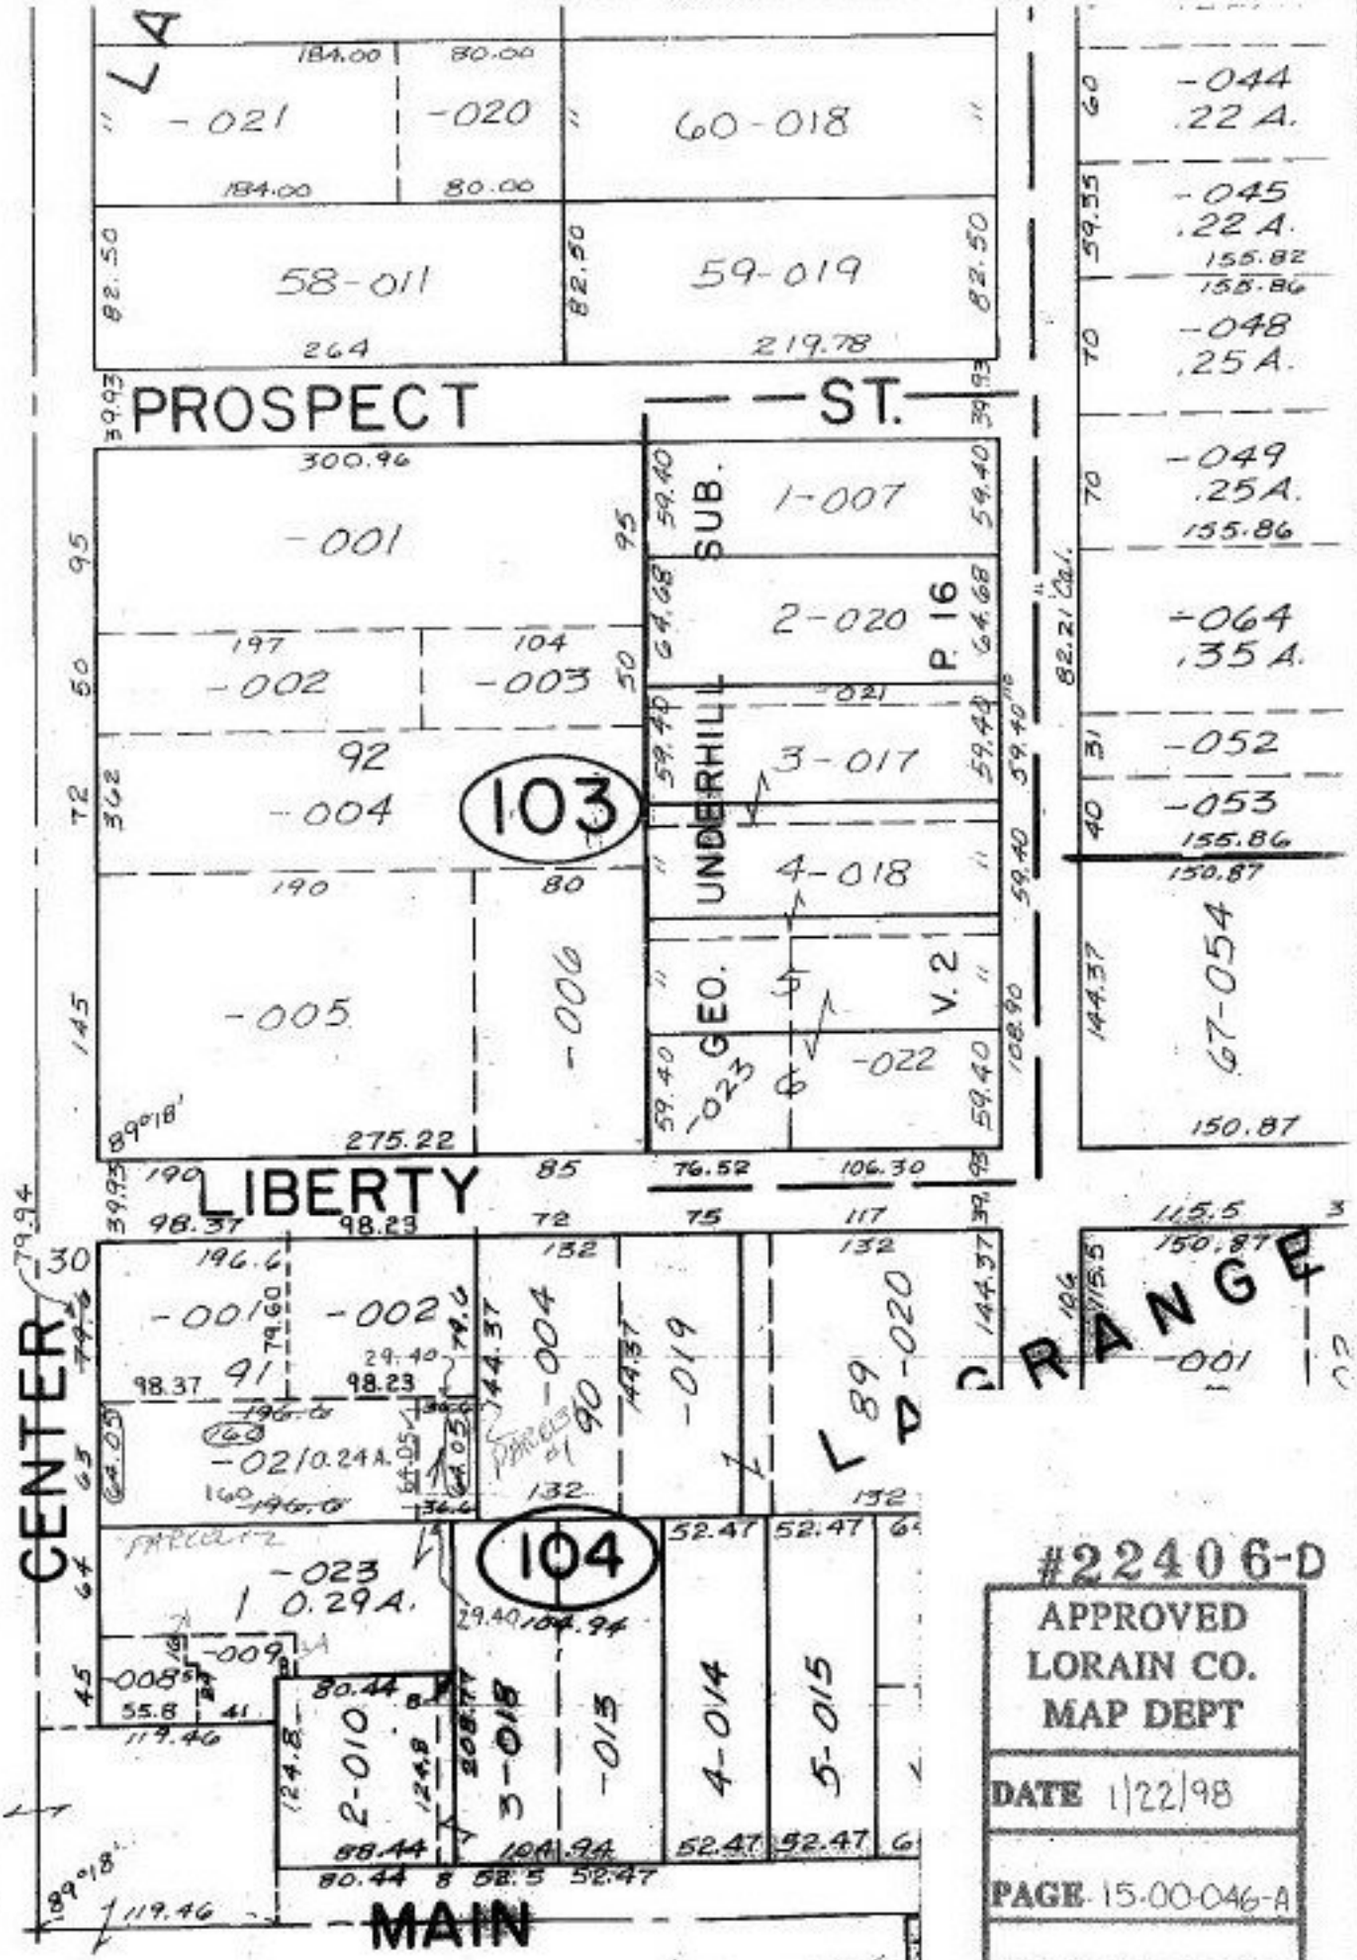

MAP CORRECTION ONLY

DEPTH CORRECTION ON -023
CORRECT 36.60 TO BE 29.40