#22

NO 22411-X

PARENT PARCEL: 01-00-056-000-032, 006, 031
CHILD PARCEL: 01-00-056-000-037, (038) 039 — REASON FOR MAP CORRECT.
STARTING POINT: cl. of Middle Ridge Rd. & w. line of O.L. 56

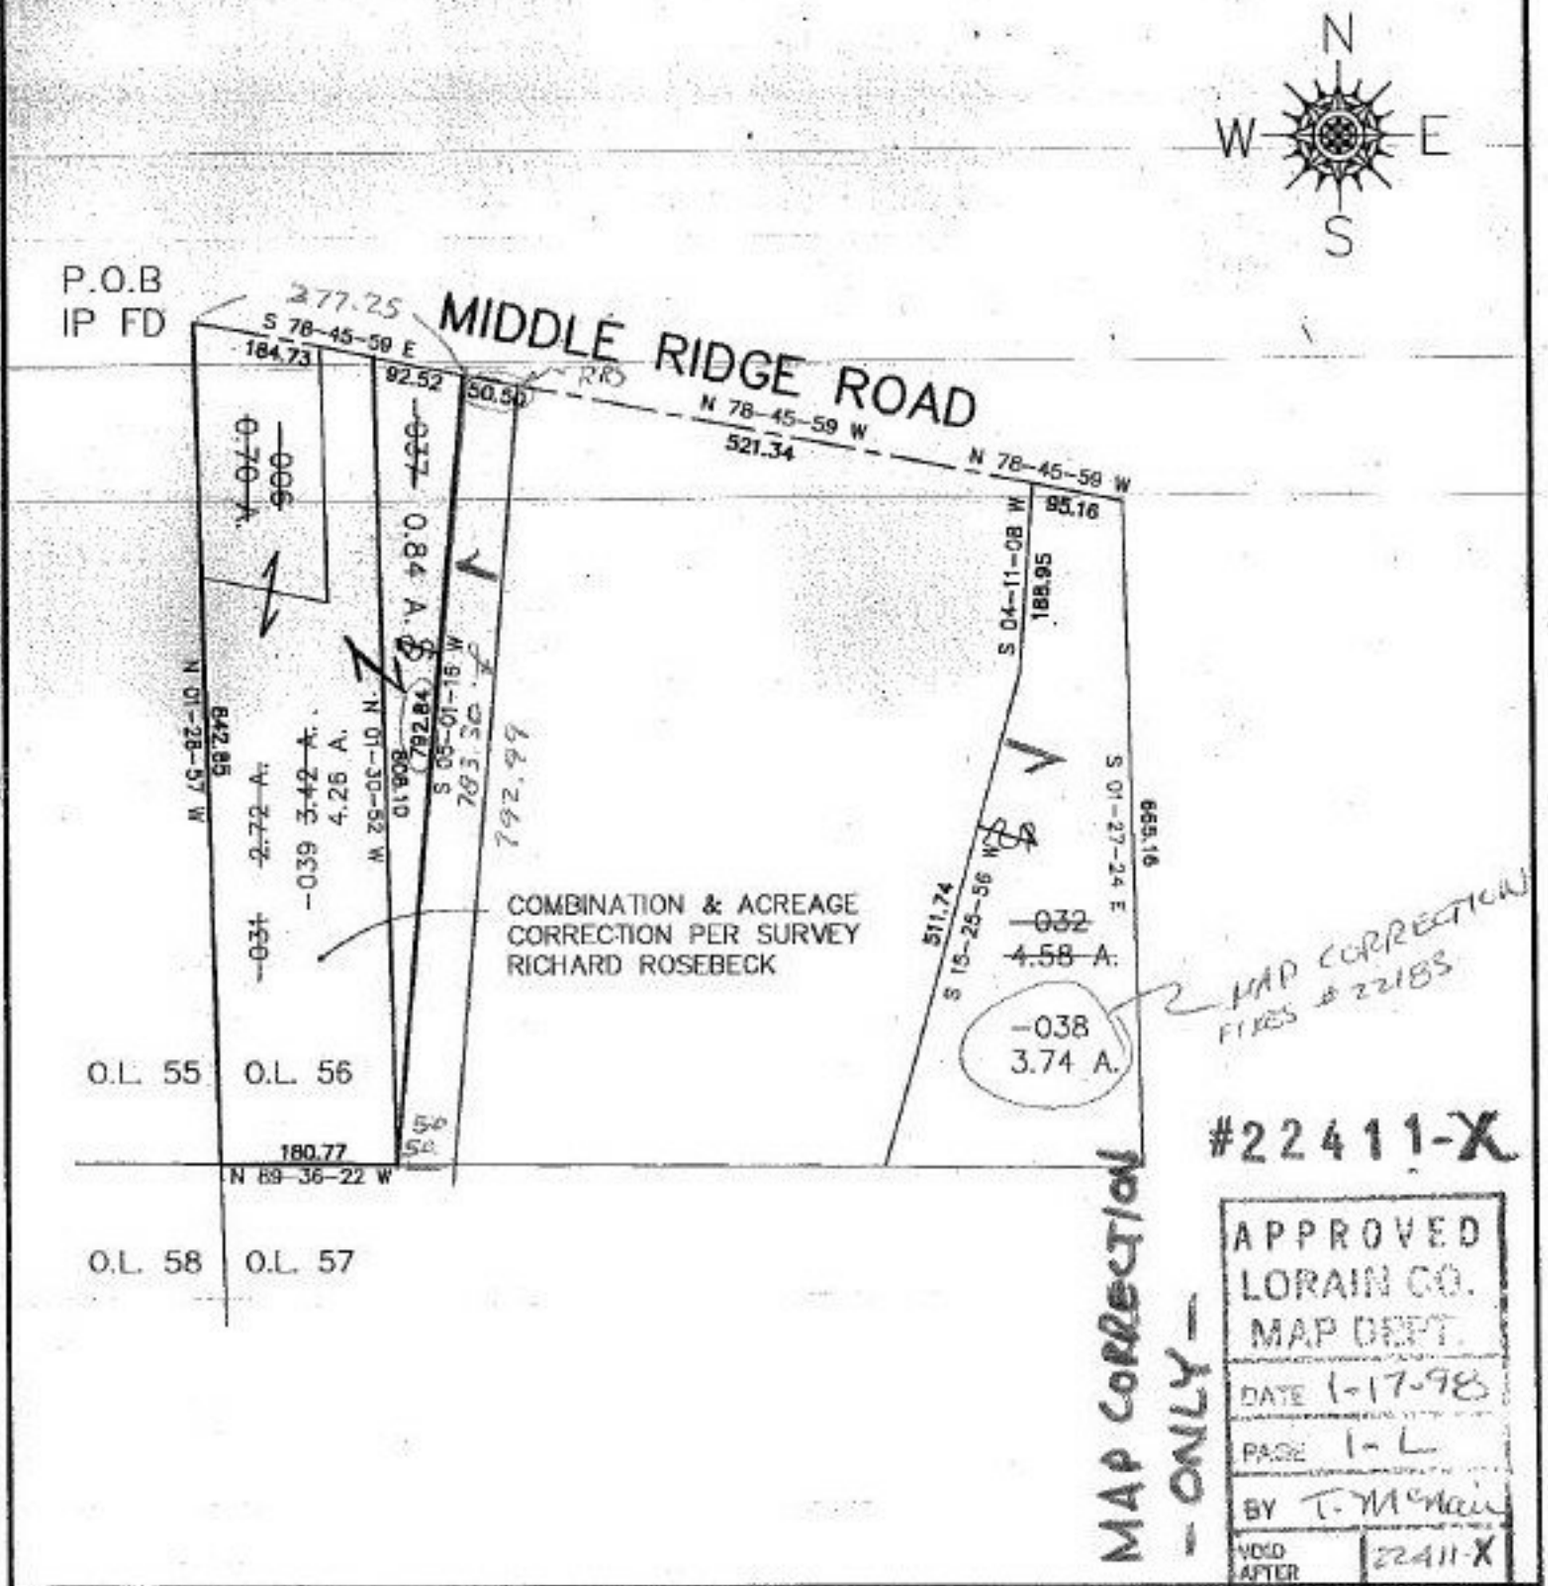

MAP CORRECTION FILES #22185

MAP CORRECTION - ONLY -

#22411-X

APPROVED
LORAIN CO.
MAP DEPT.
DATE 1-17-98
PAGE 1-L
BY T. McNair
VOID AFTER 22411-X

SPLITS/DEEDS PROCESSED
LORAIN COUNTY TAX MAP DEPARTMENT
226 MIDDLE AVE. ELYRIA, OHIO

SURVEYED BY: Richard Rosebeck
CLOSURE: 0.12 per 10,000
MAP PAGE(S): 1-L
APPROVED BY: kac/REB DATE: 05-15-97
SCALE: 1"=200