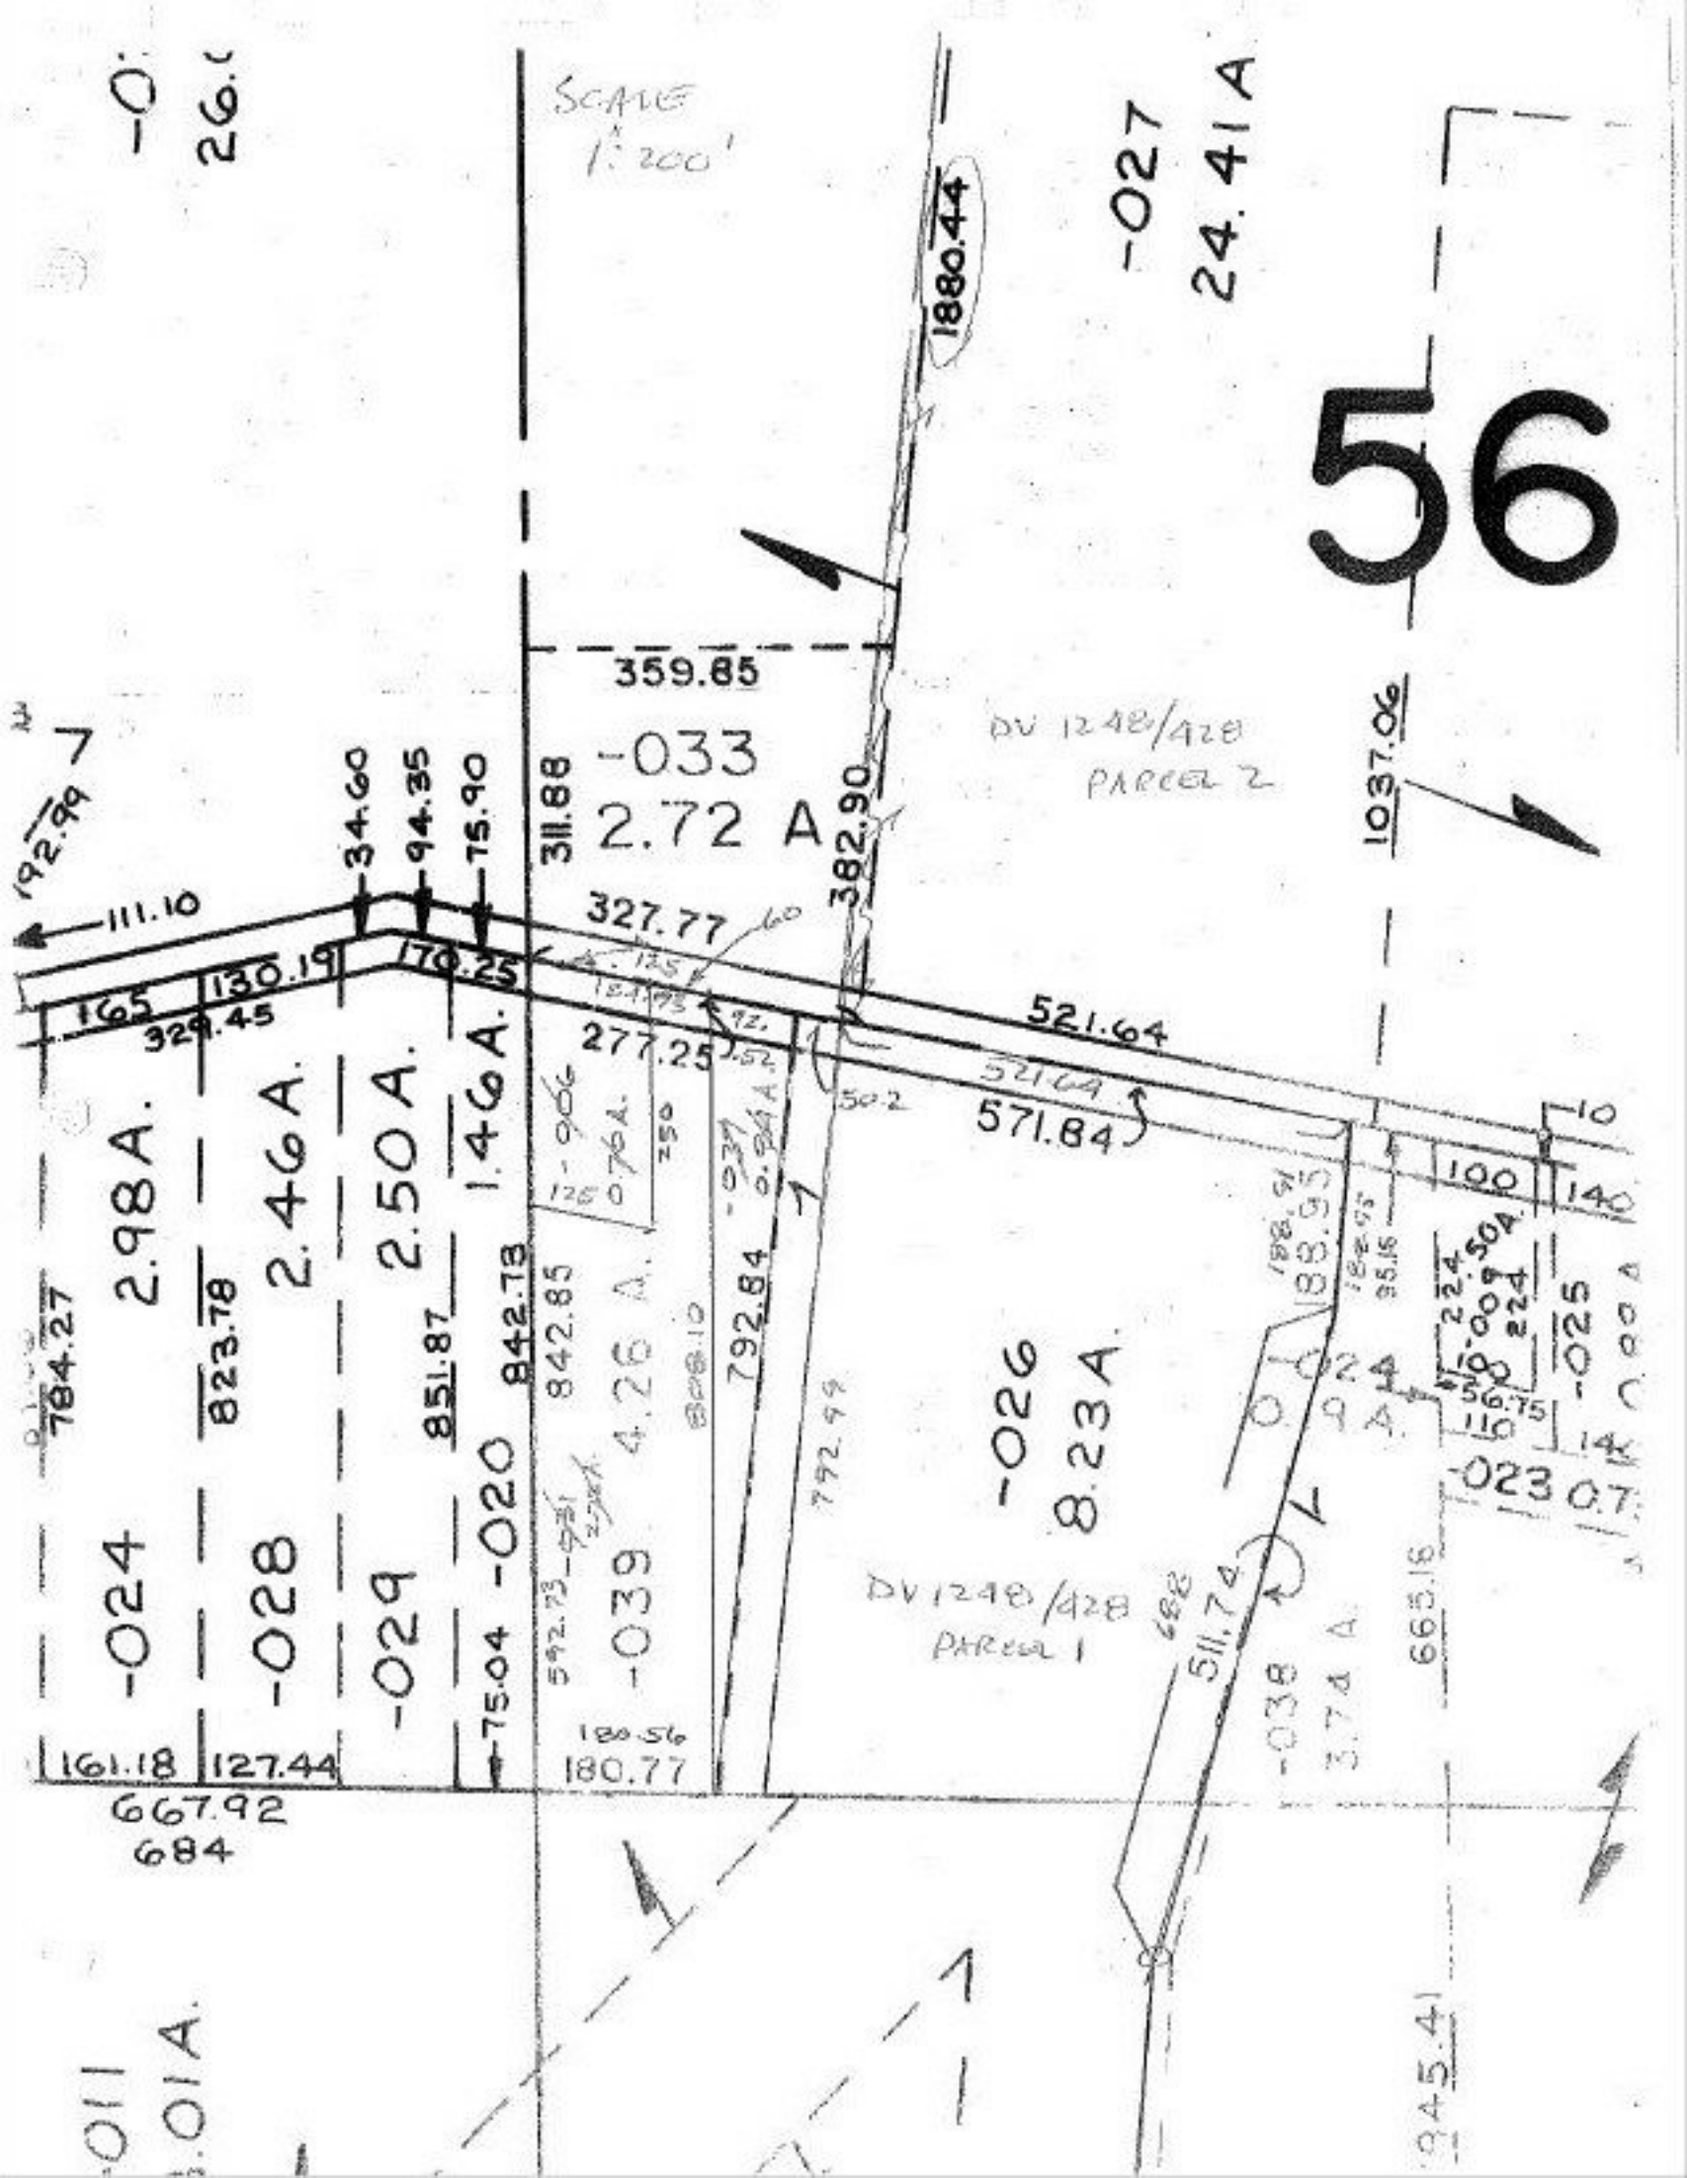

SCALE 1:200'
56
-027
24.41 A
1880.44
359.85
-033
2.72 A
311.88
382.90
DV 1248/428
PARCEL 2
1037.06
192.99
111.10
34.60
94.35
75.90
327.77
165
130.19
170.25
329.45
277.25
521.64
571.84
2.98 A.
2.46 A.
2.50 A.
1.46 A.
784.27
823.78
851.87
842.73
842.85
4.26 A.
792.84
792.99
-026
8.23 A.
-024
-028
-029
-020
-039
DV 1248/428
PARCEL 1
511.74
-038
3.74 A.
665.16
-023
-025
100
140
161.18
127.44
75.04
180.56
180.77
667.92
684
945.41