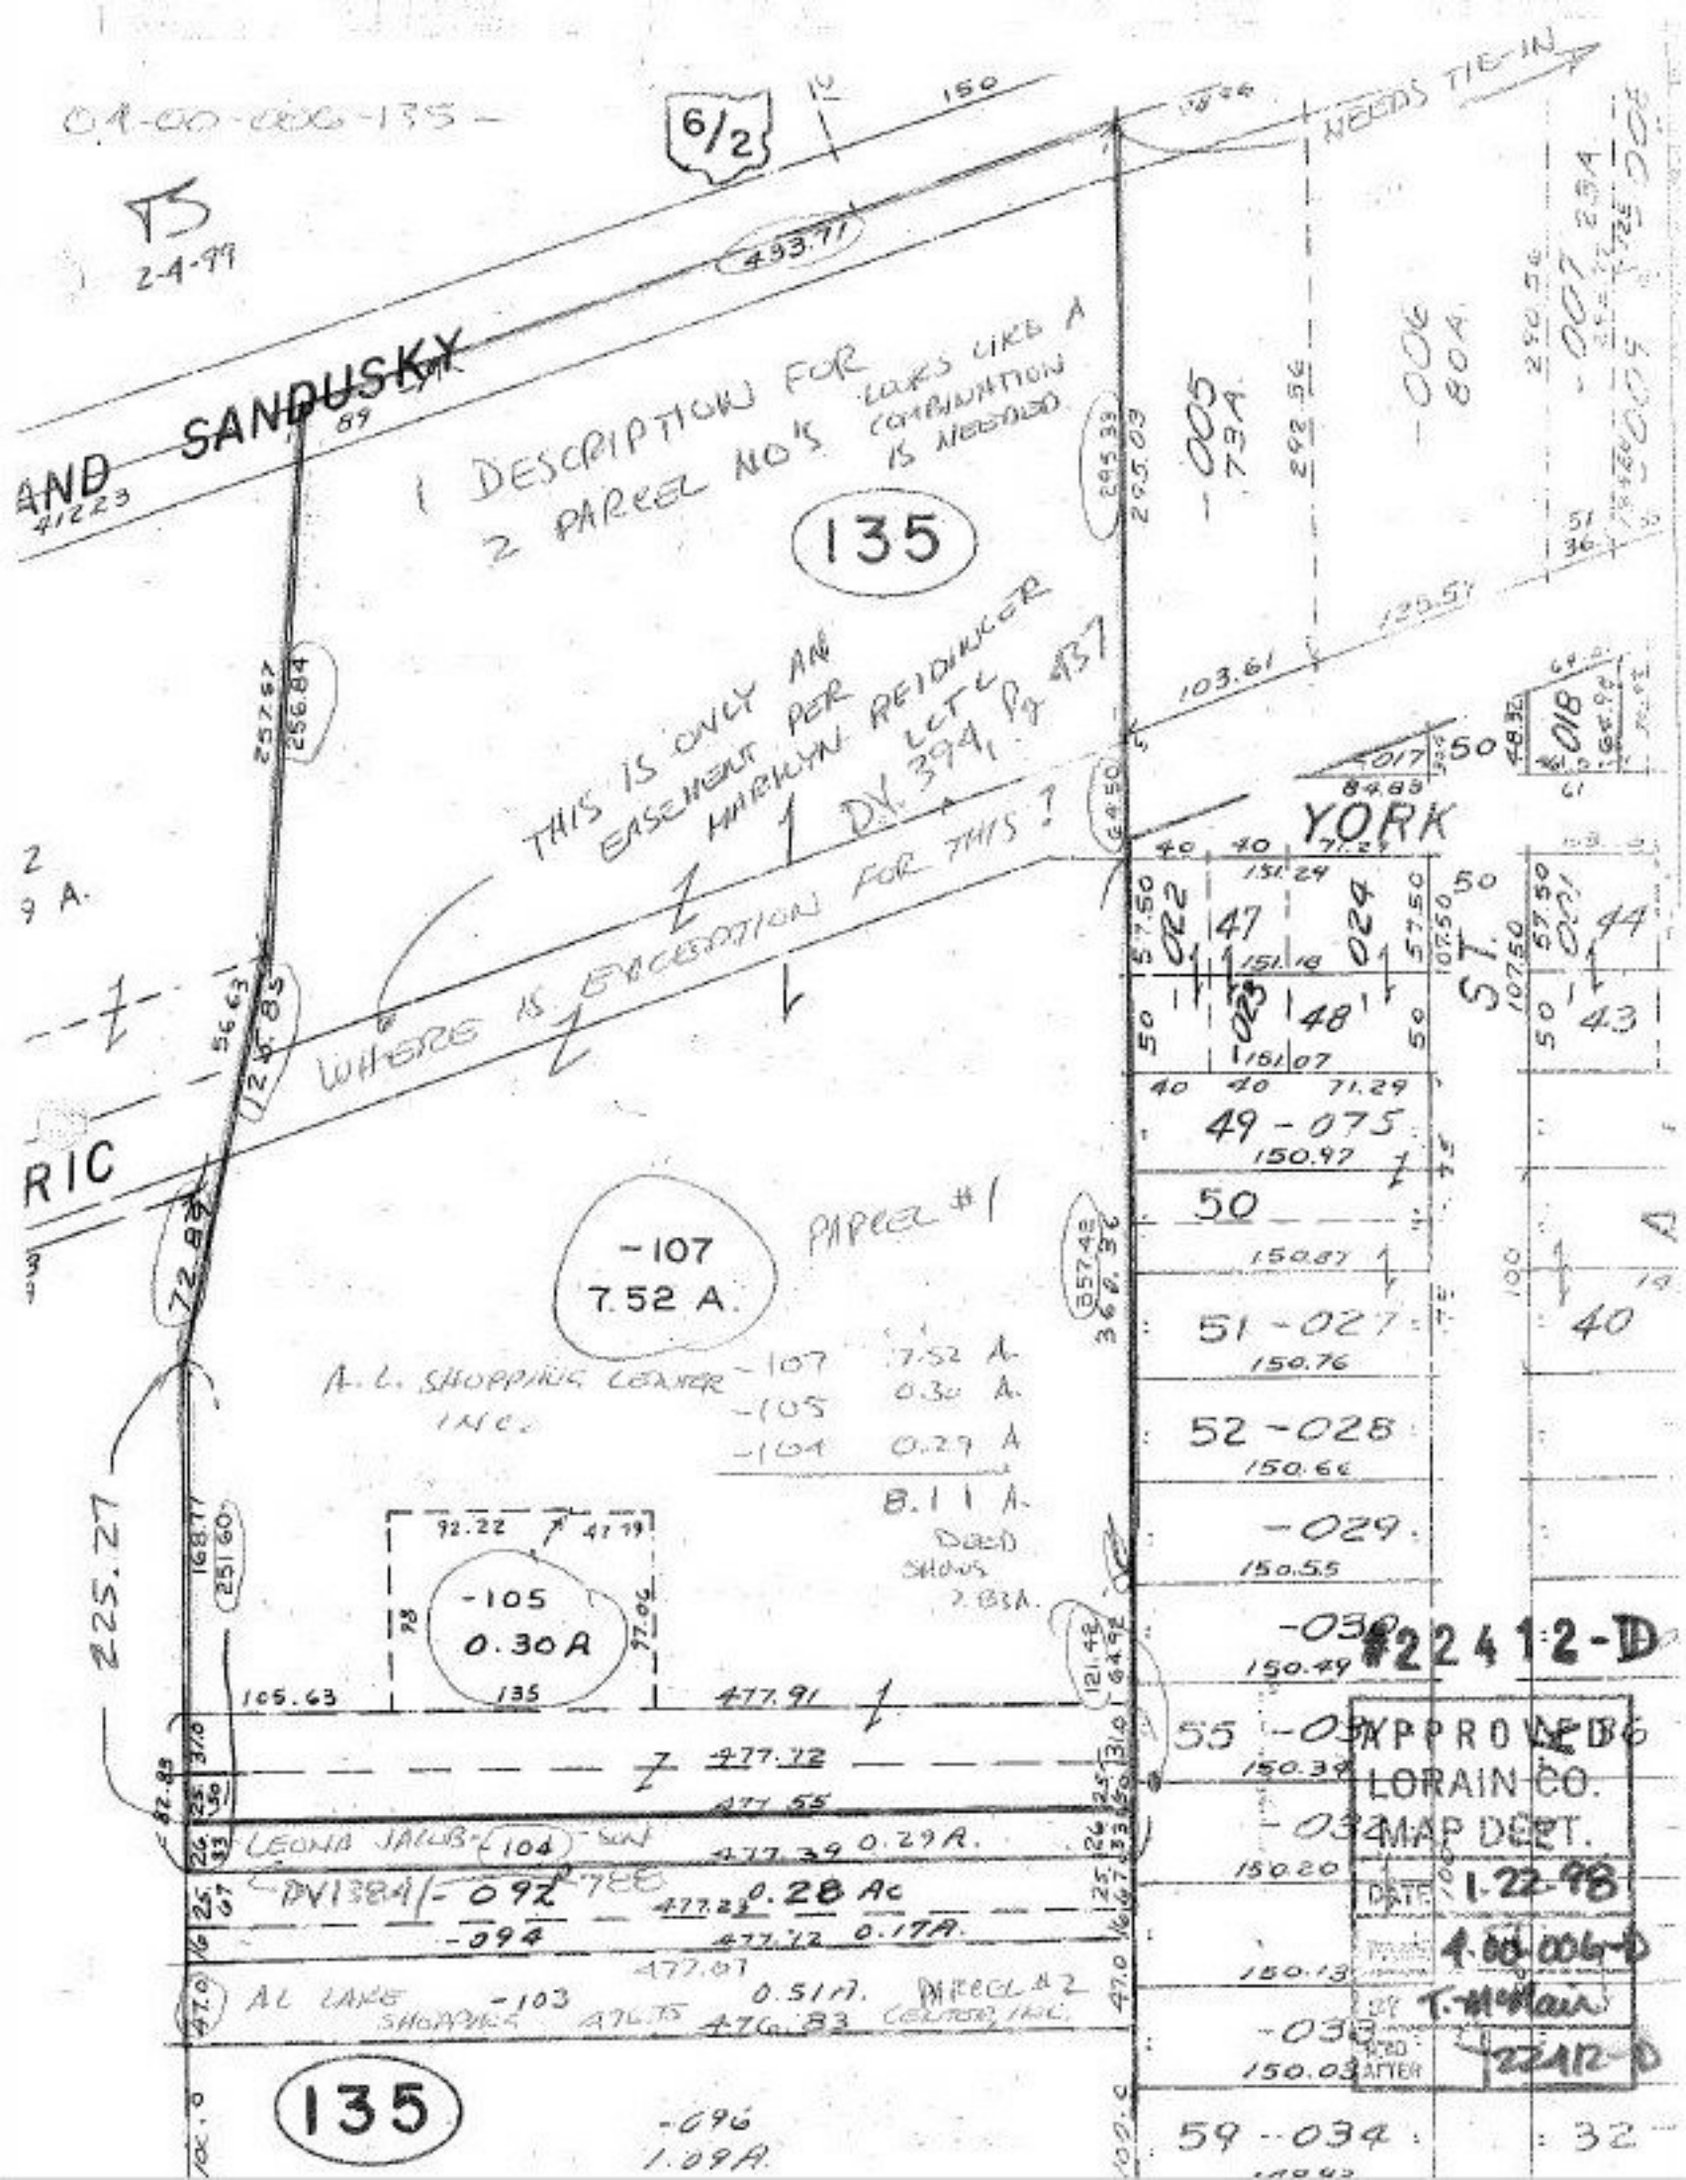
01-00-000-135
6/2
TS
2-4-99
NEEDS TIE-IN
493.71
AND SANDUSKY
1 DESCRIPTION FOR
2 PARCEL NO'S
LOOKS LIKE A
COMBINATION
IS NEEDED
135
-005
7.94 A.
-006
8.04 A.
-007
2.94 A.
-008
THIS IS ONLY AN
EASEMENT PER
MARILYN REIDINGER
1 DY. LCT L
394, Pg 437
WHERE IS EXCEPTION FOR THIS?
YORK
ST.
RIC
-107
7.52 A.
PARCEL #1
A. L. SHOPPING CENTER
INC.
-107 7.52 A.
-105 0.30 A.
-104 0.29 A.
8.11 A.
Deed
shows
2.83A.
-105
0.30A
92.22
41.79
225.27
168.77
251.60
105.63
135
477.91
477.72
477.55
LEONA JAUB
-104
477.39 0.29A.
DV1384/-092
477.23 0.28 Ac
-094
477.12 0.17A.
477.07
0.51A.
PARCEL #2
AL LANE SHOPPING CENTERS INC.
-103
476.83
135
-096
1.09A.
49-075
150.97
50
150.87
51-027
150.76
52-028
150.66
-029
150.55
-030
150.49
55-031
150.38
-032
150.20
-033
150.13
-034
150.03
59-034
#2212-D
APPROVED
LORAIN CO.
MAP DEPT.
DATE 1-22-98
4-00-006-D
BY T. McMain
ADD AFTER
2212-D