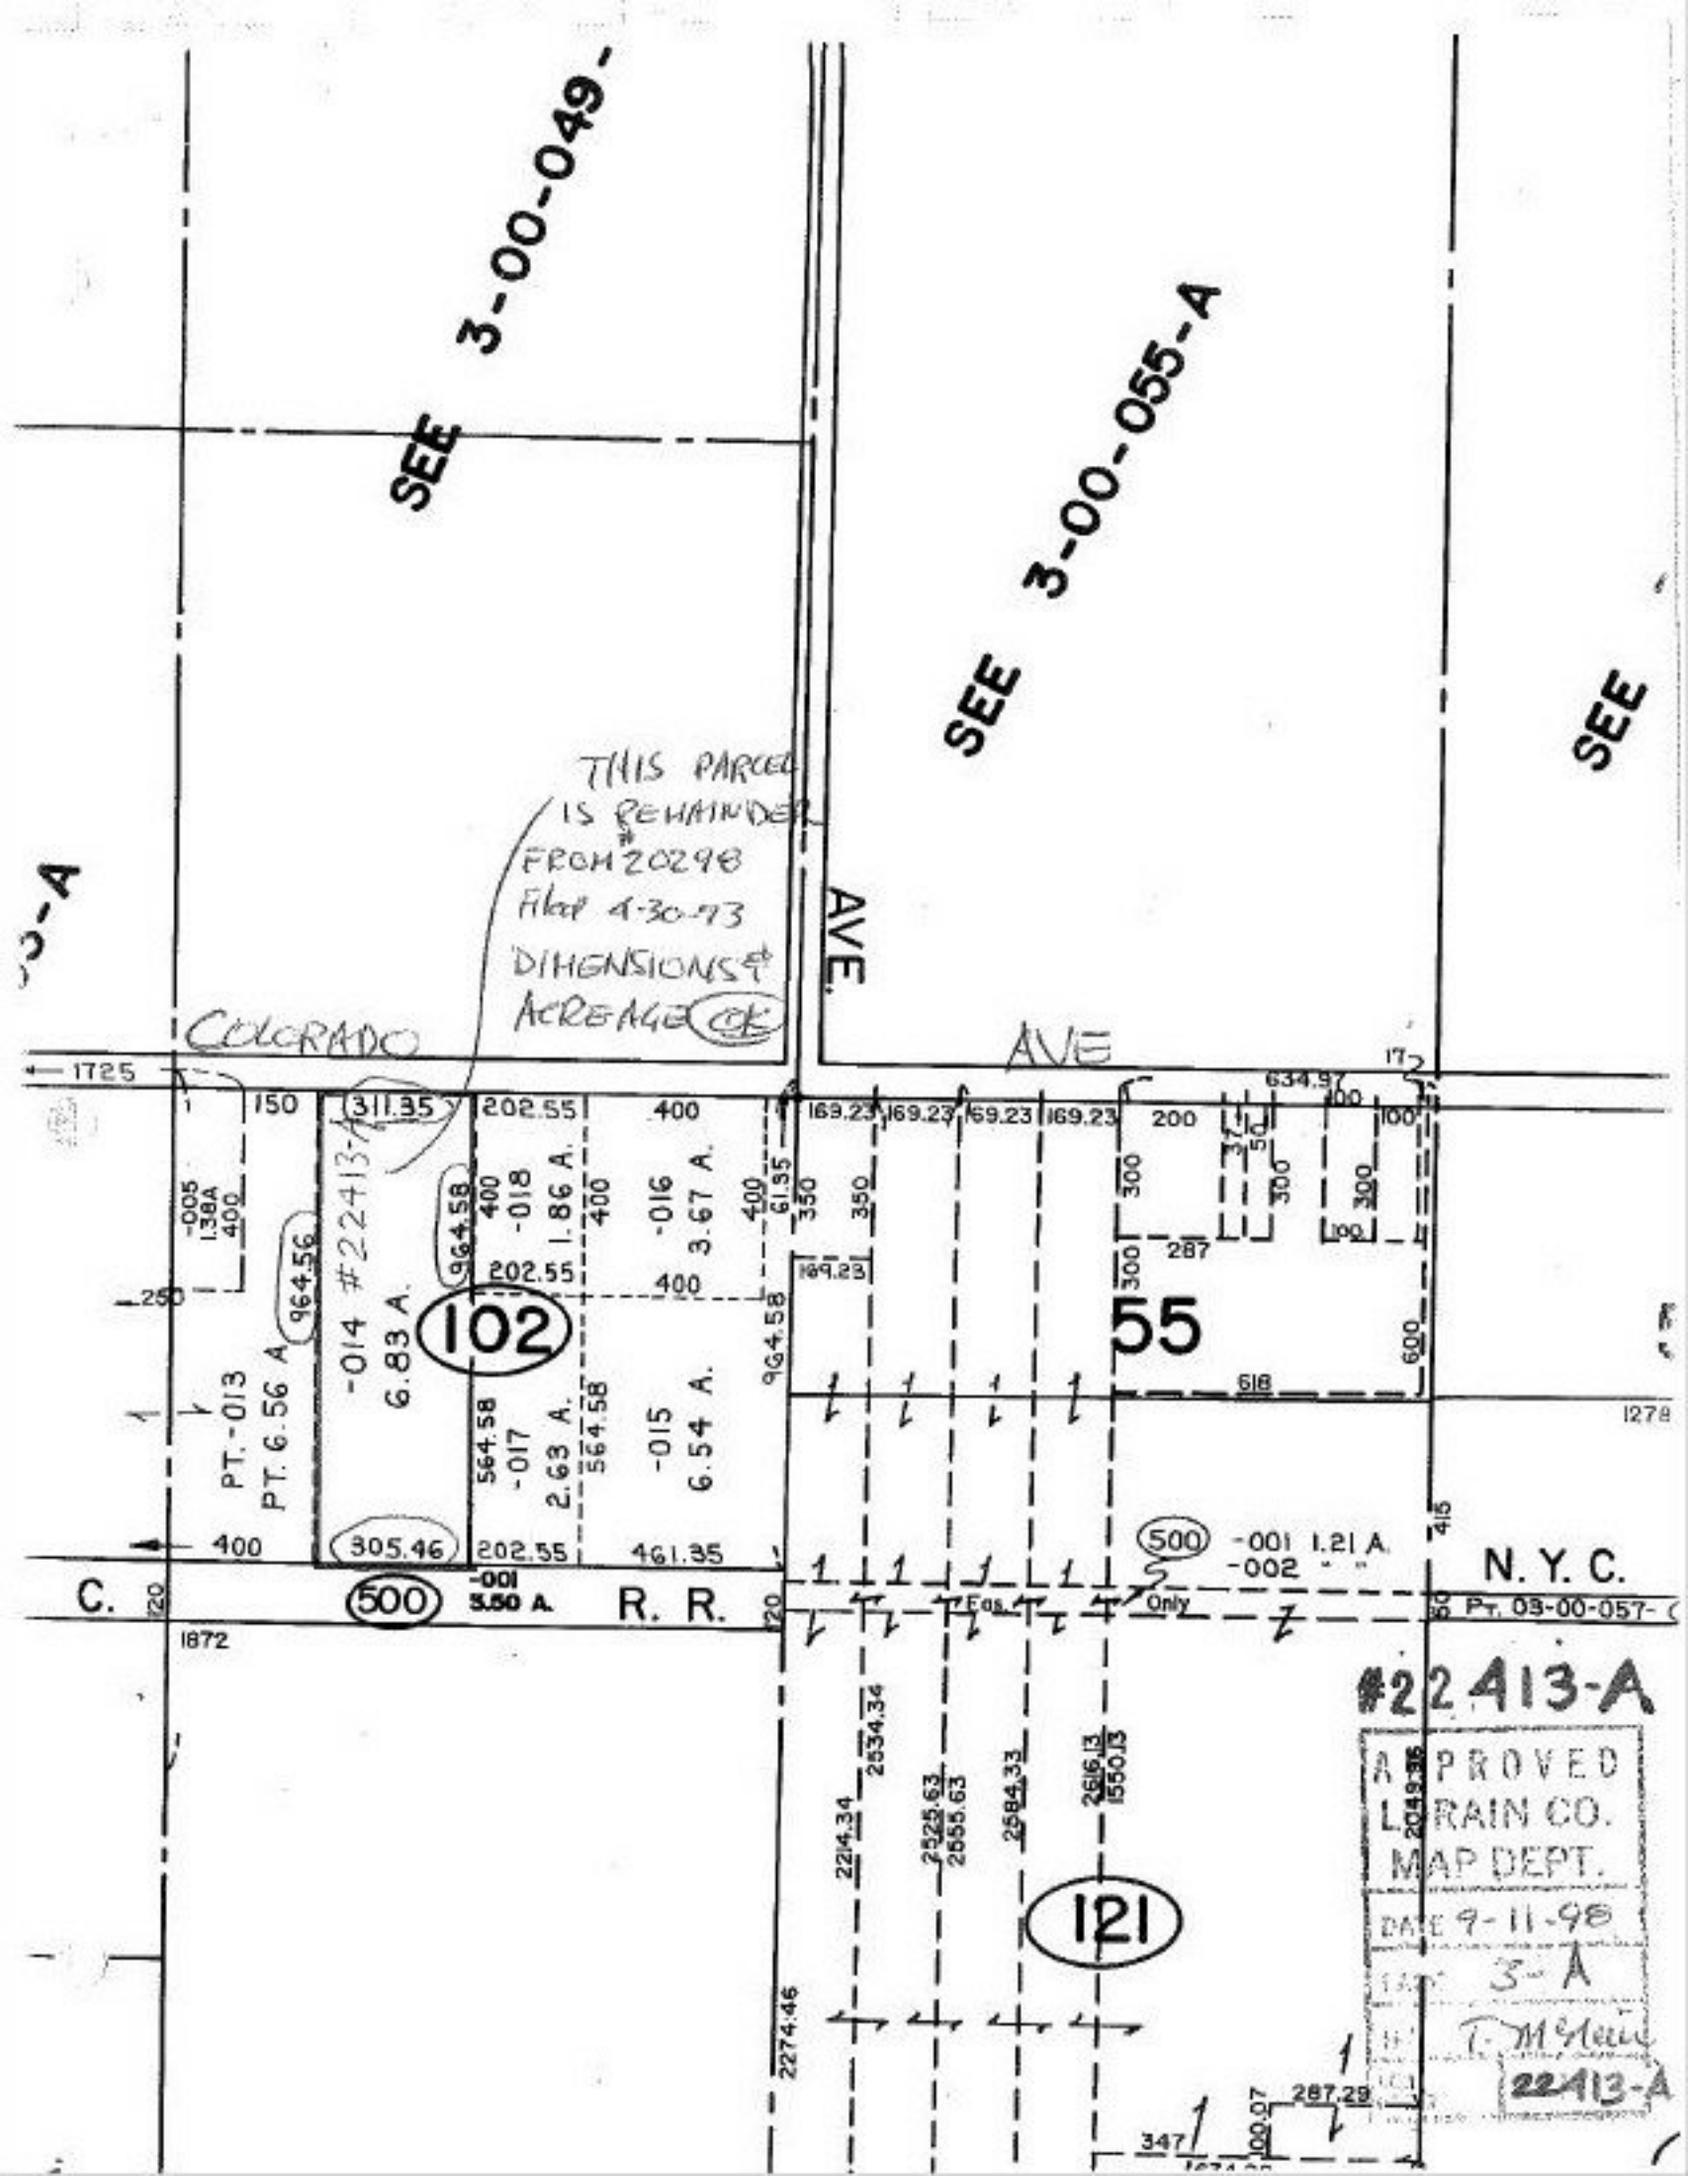
SEE 3-00-049-
SEE 3-00-055-A
SEE
THIS PARCEL IS REMAINDER FROM #20298 Filed 4-30-93 DIMENSIONS & ACREAGE OK
COLORADO AVE
AVE.
102
55
121
-014 #22413-A
6.83 A.
-018 1.86 A.
-016 3.67 A.
-017 2.63 A.
-015 6.54 A.
PT. -013 PT. 6.56 A
-001 1.21 A.
-002
-001 3.50 A.
C. R. R.
N. Y. C.
Pt. 03-00-057-
Only
#22413-A
APPROVED
LORAIN CO.
MAP DEPT.
DATE 9-11-98
3-A
22413-A