PARENT PARCEL: 07-00-009-113-003

CHILD PARCEL: 07-00-009-113-074, 075

STARTING POINT: w. line of Jefferson Ave. & s. line of Adams Ave.

NO. 22415

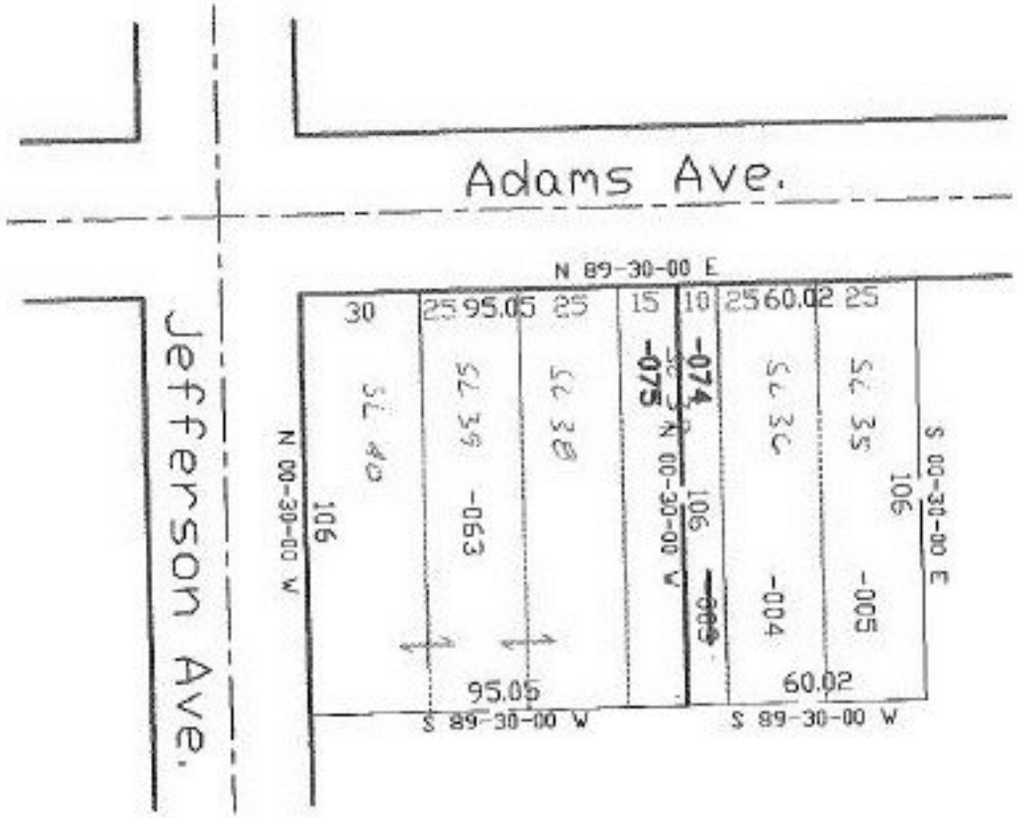

DEED 1 - COMB. OF -074, -004, -005 → AS SHOWN ON DEED ONLY

DEED 2 - COMB. OF -075, -063

SPLITS/DEEDS PROCESSED

LORAIN COUNTY TAX MAP DEPARTMENT

226 MIDDLE AVE. ELYRIA, OHIO

SURVEYED BY: Timothy J. Feller McSteen & Assoc

CLOSURE: 0.00:10,000

MAP PAGE(S): 7-00-009-B

APPROVED BY: kac DATE: 1/26/98

SCALE: 1" = 50' PRIOR INSTRUMENT: #970477596