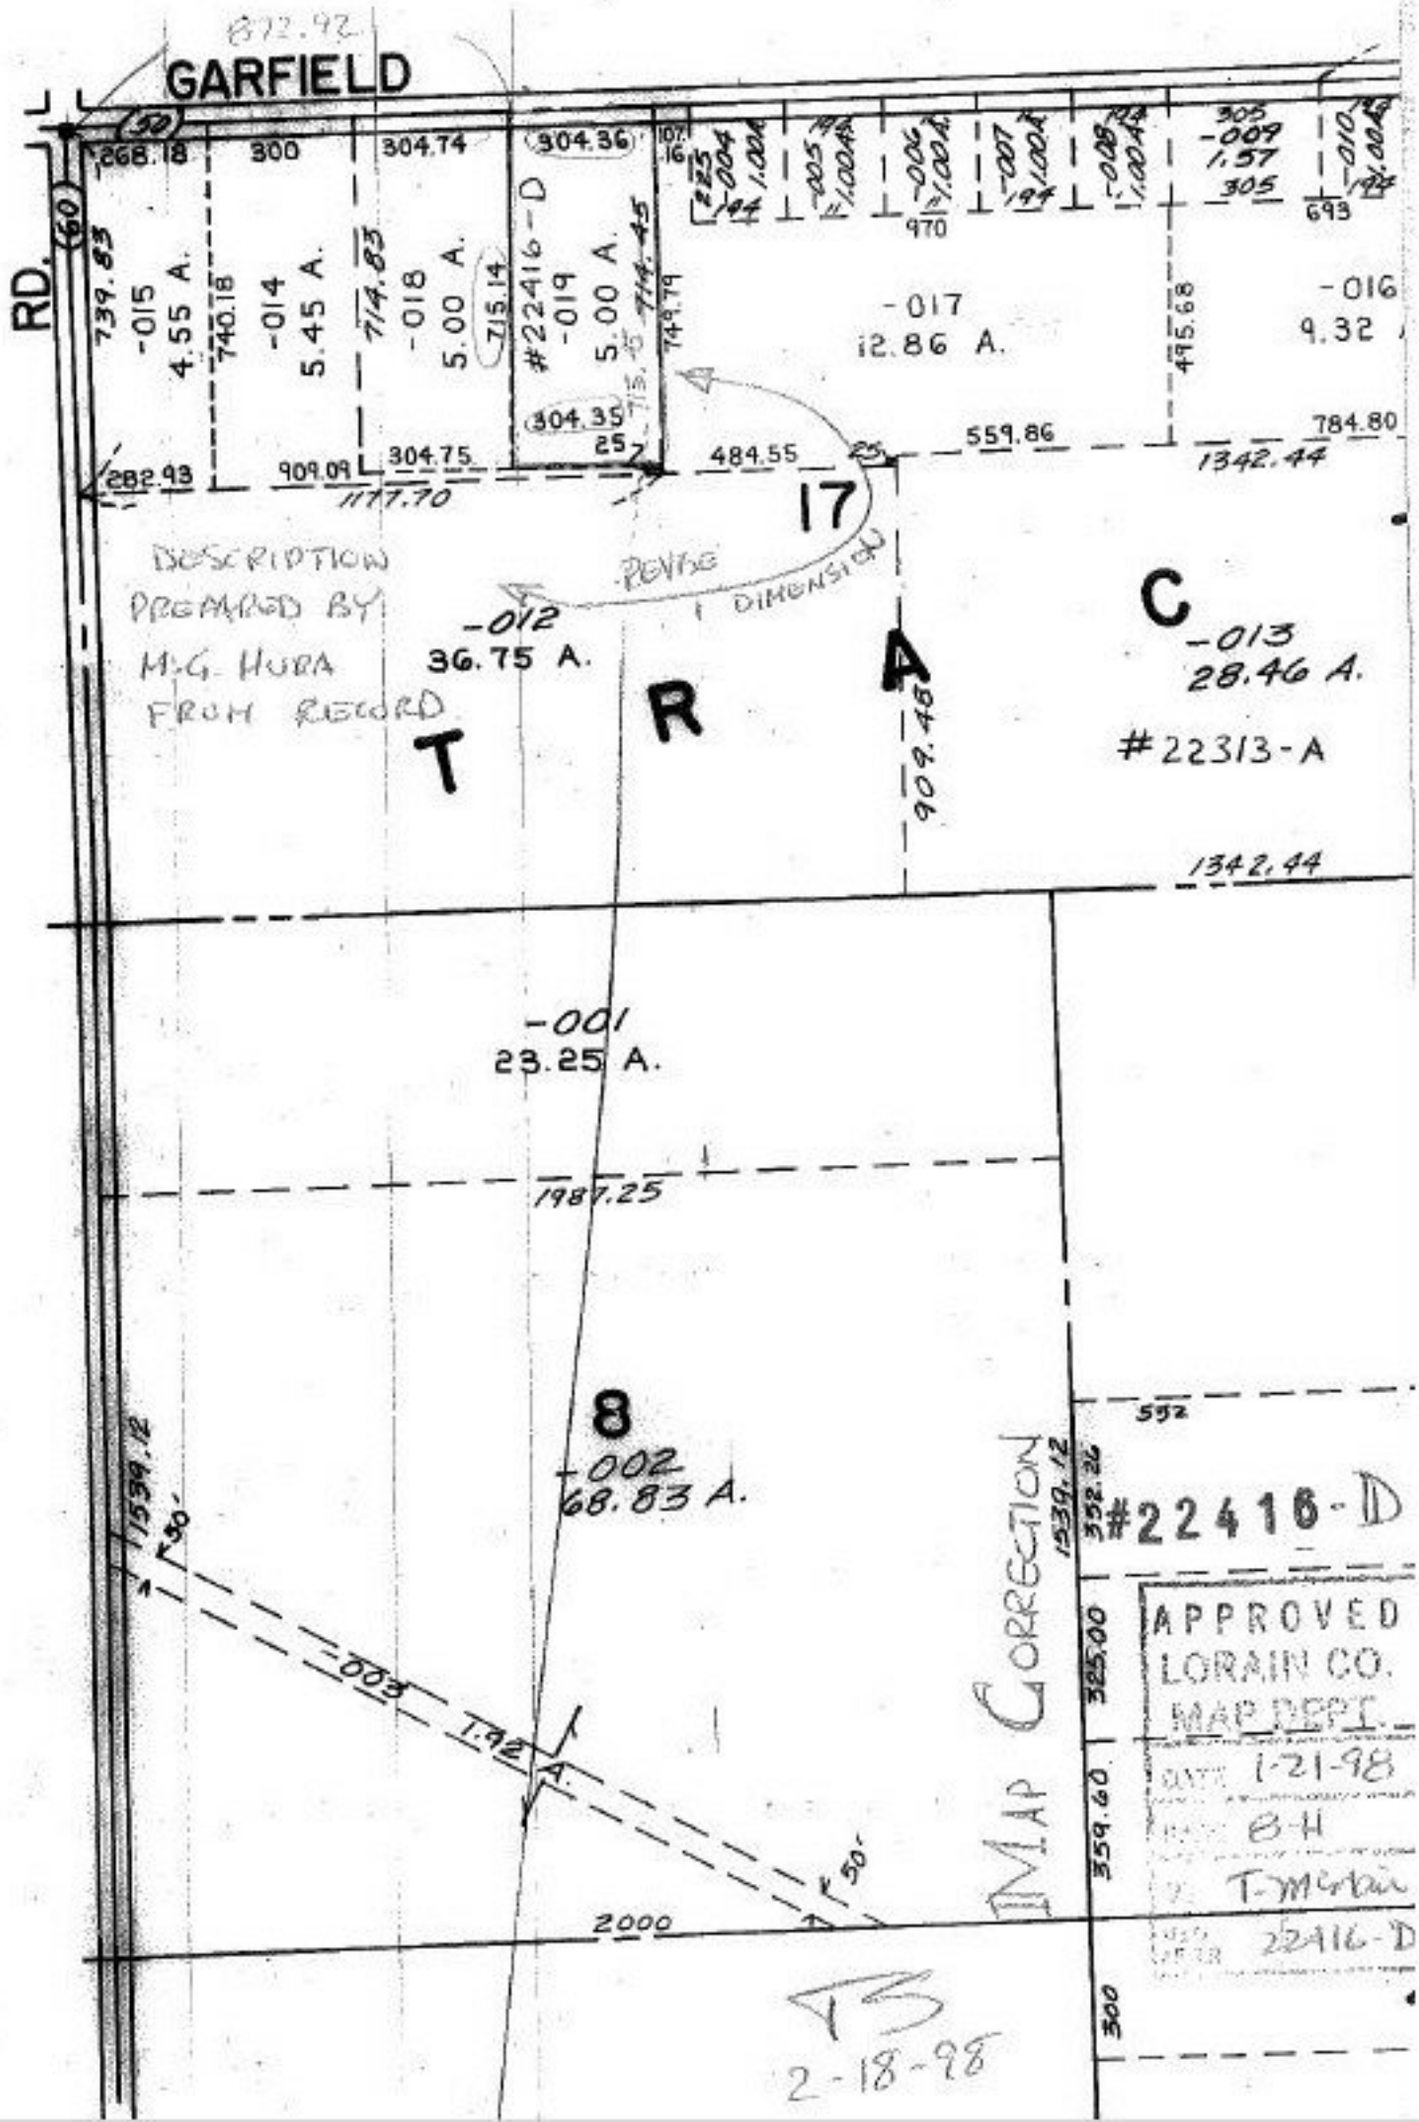

872.92
GARFIELD
RD.
268.18
300
304.74
304.36
107.16
-015
4.55 A.
-014
5.45 A.
-018
5.00 A.
#22416-D
-019
5.00 A.
-017
12.86 A.
-016
9.32
739.83
740.18
714.83
715.14
714.45
749.79
495.68
970
693
304.35
25
282.93
909.09
304.75
484.55
559.86
784.80
1342.44
1177.70
17
DESCRIPTION PREPARED BY M.G. HURA FROM RECORD
REVISE DIMENSION
-012
36.75 A.
T R A C
-013
28.46 A.
#22313-A
909.48
1342.44
-001
23.25 A.
1987.25
8
-002
68.83 A.
1539.12
50'
-003
1.92 A.
50'
2000
MAP CORRECTION
552
352.26
325.00
359.60
300
#22416-D
APPROVED
LORAIN CO.
MAP DEPT.
DATE 1-21-98
8-H
T-McGrain
22416-D
8-H
2-18-98