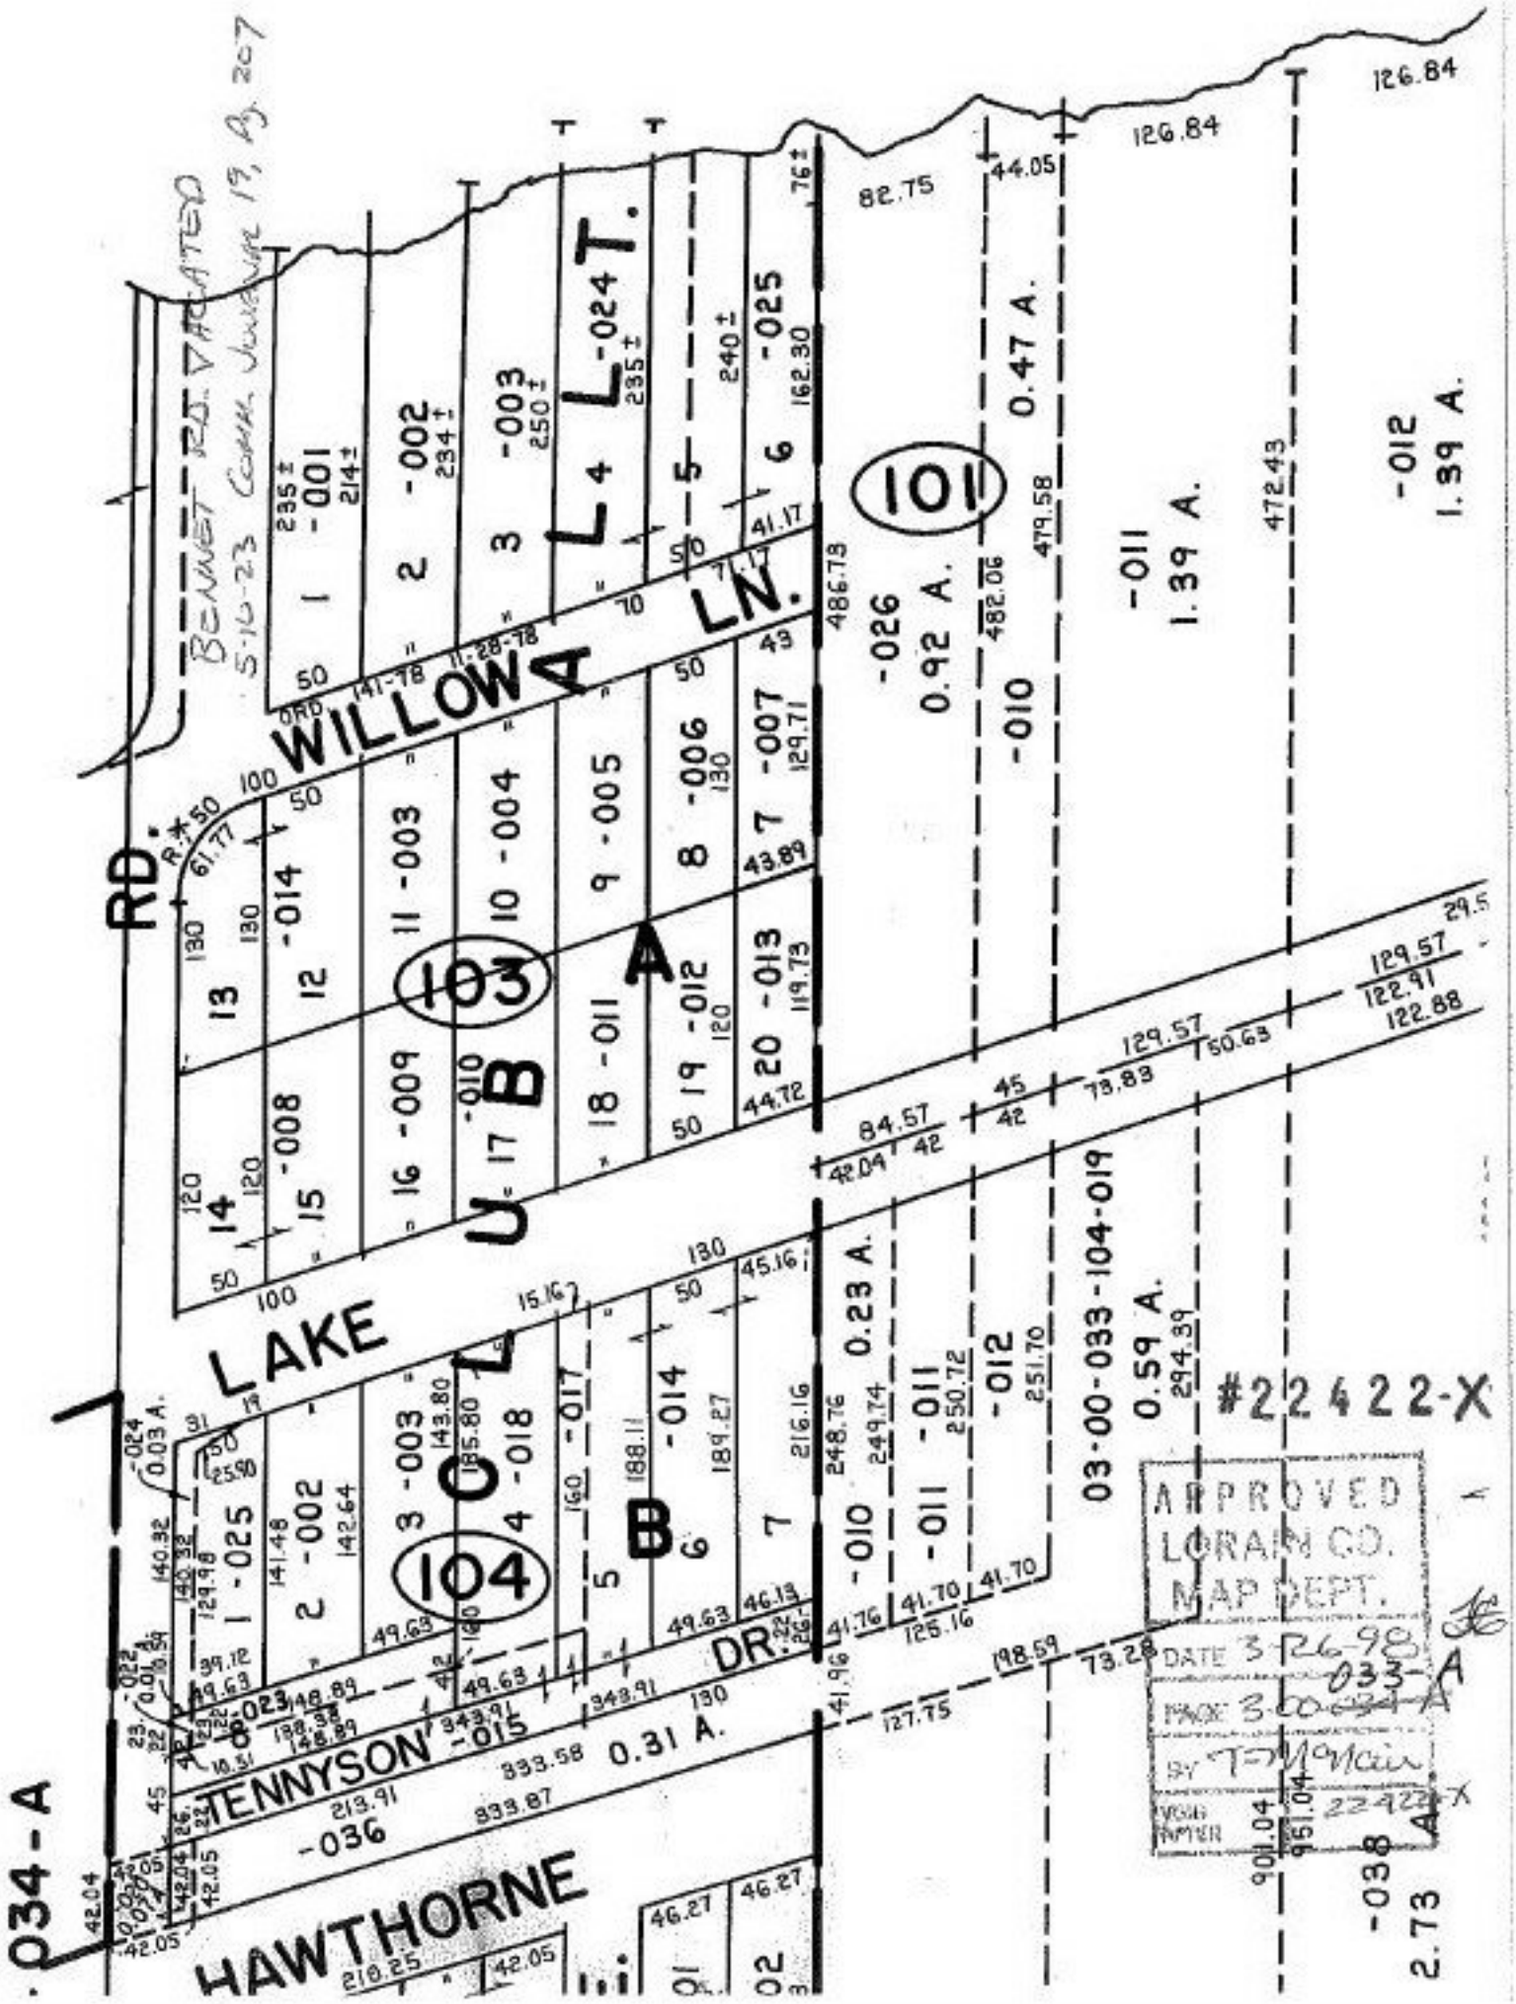

BENNET RD. VACATED
5-16-23 COMM. JOURNAL 19, Pg. 207
WILLOW LN.
LAKE RD.
TENNYSON DR.
HAWTHORNE
LUB LT.
A
B
101
103
104
#22422-X
APPROVED
LORAIN CO.
MAP DEPT.
DATE 3-26-98
PAGE 3-00-033-A
BY T. McNair
VOID PAPER 22422-X