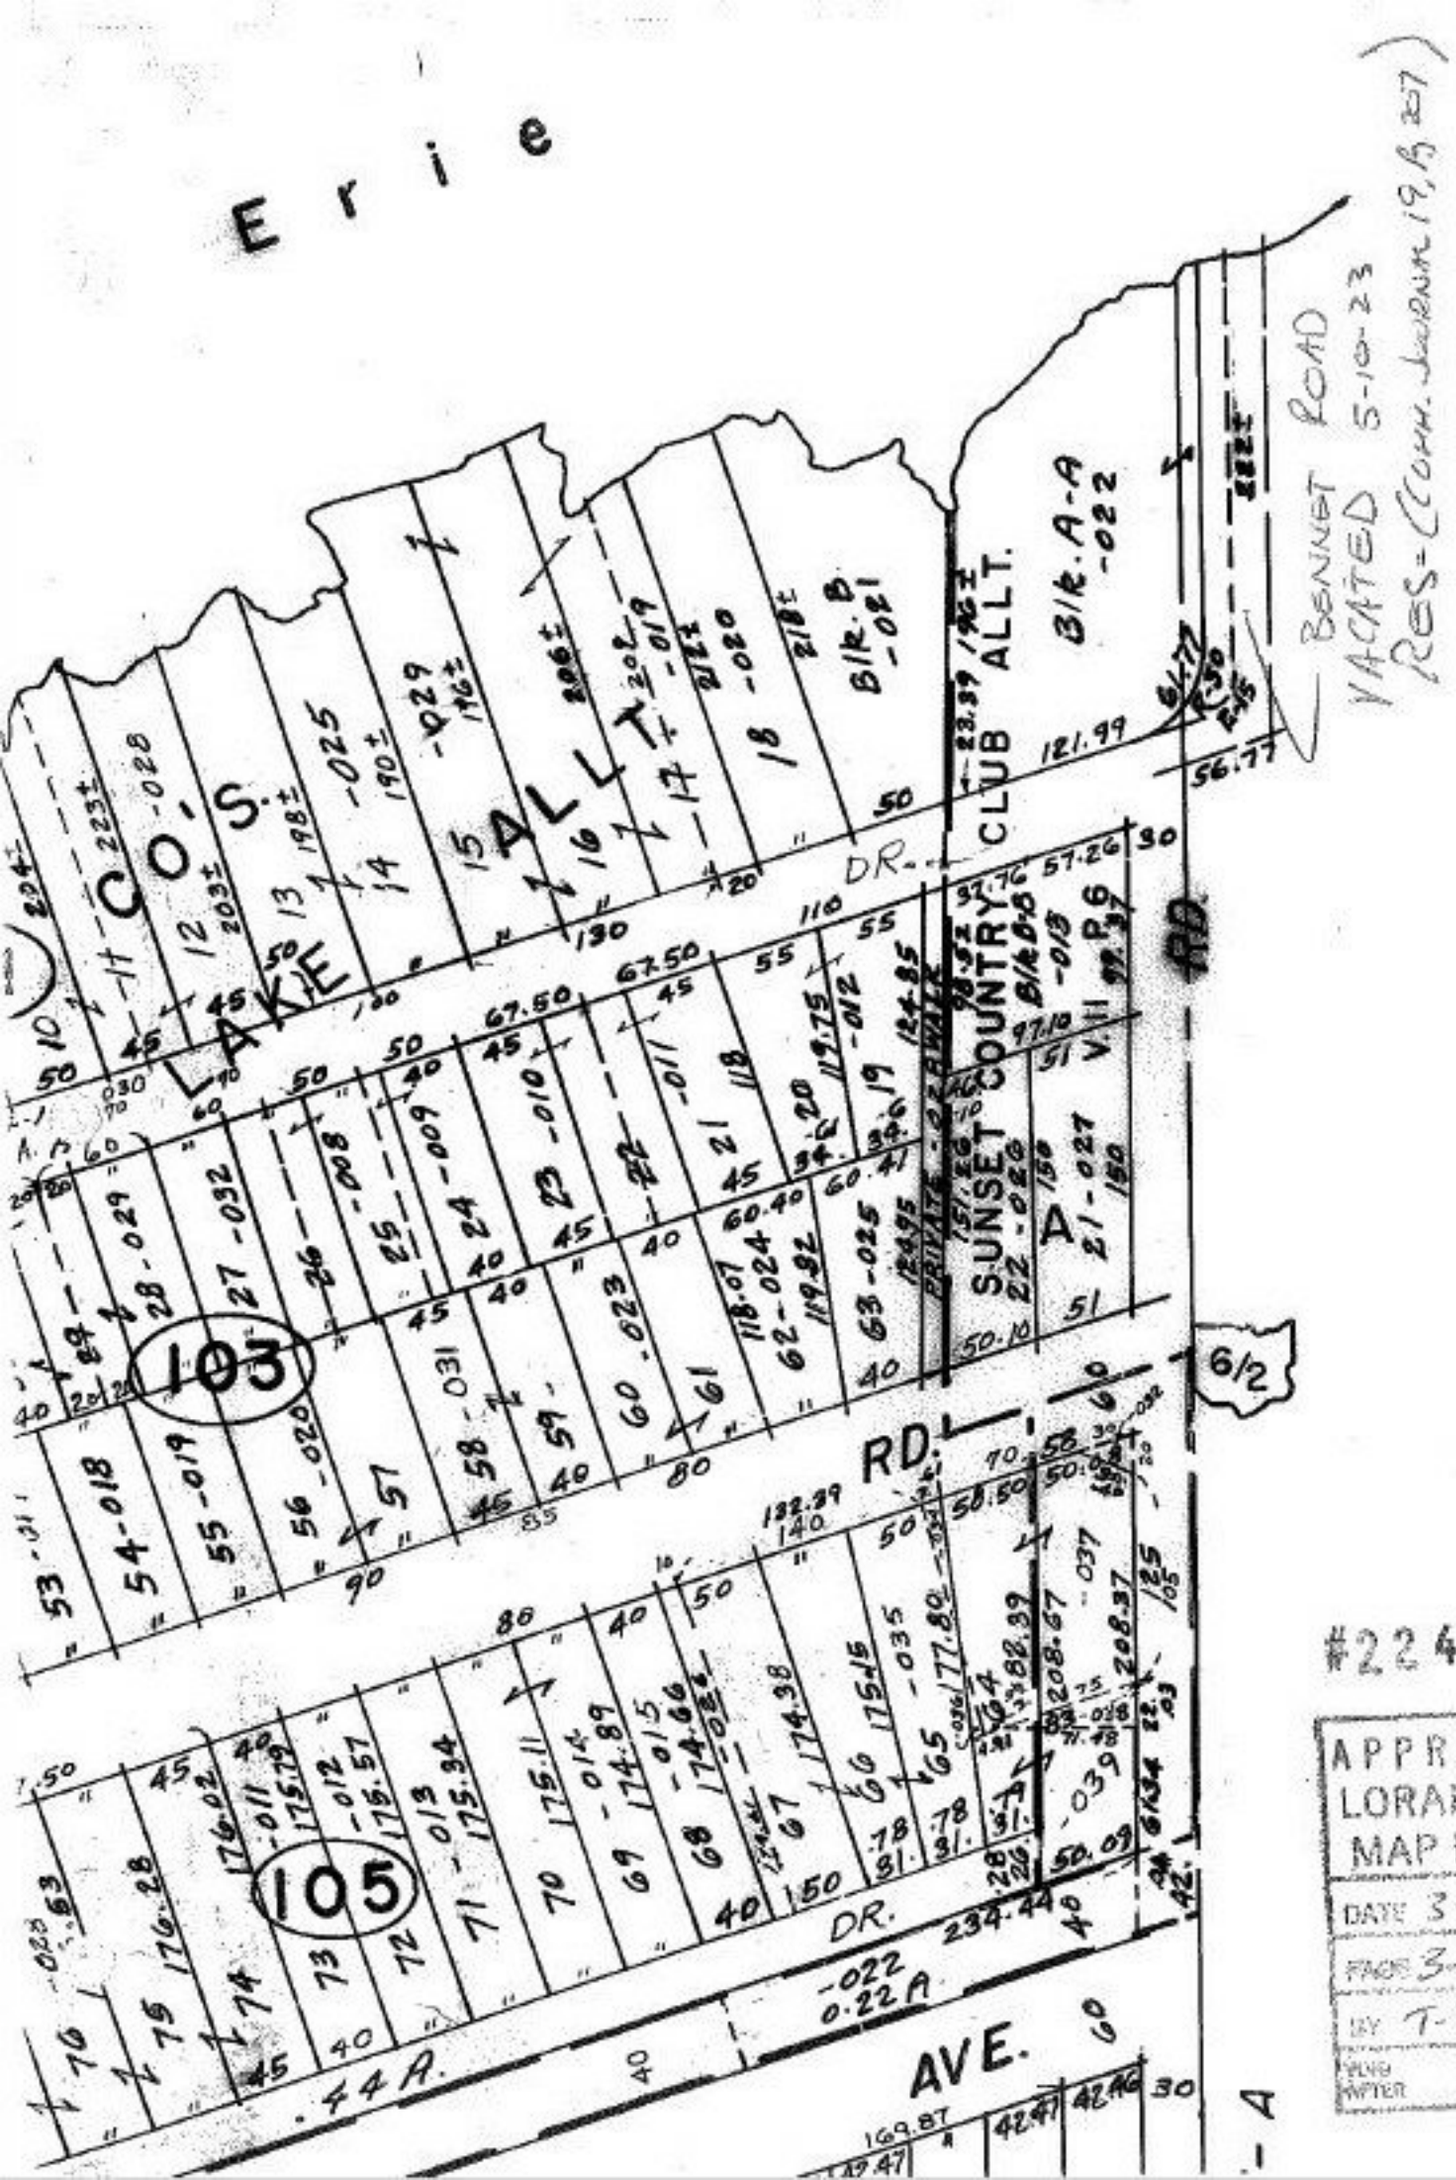

#22422-X

APPROVED
LORAIN CO.
MAP DEPT.
DATE 3-26-98
PAGE 3-00-034-A
BY T. McNair
VOID AFTER 22422-X