PARENT PARCEL: 07-00-033-000-003, 07-00-034-000-004, 005

CHILD PARCEL: 07-00-033-000-031,032 7-00-034-000-124,125

STARTING POINT: cL of Evergreen Blvd. & cL of Center Ridge Rd.

NO. 22428

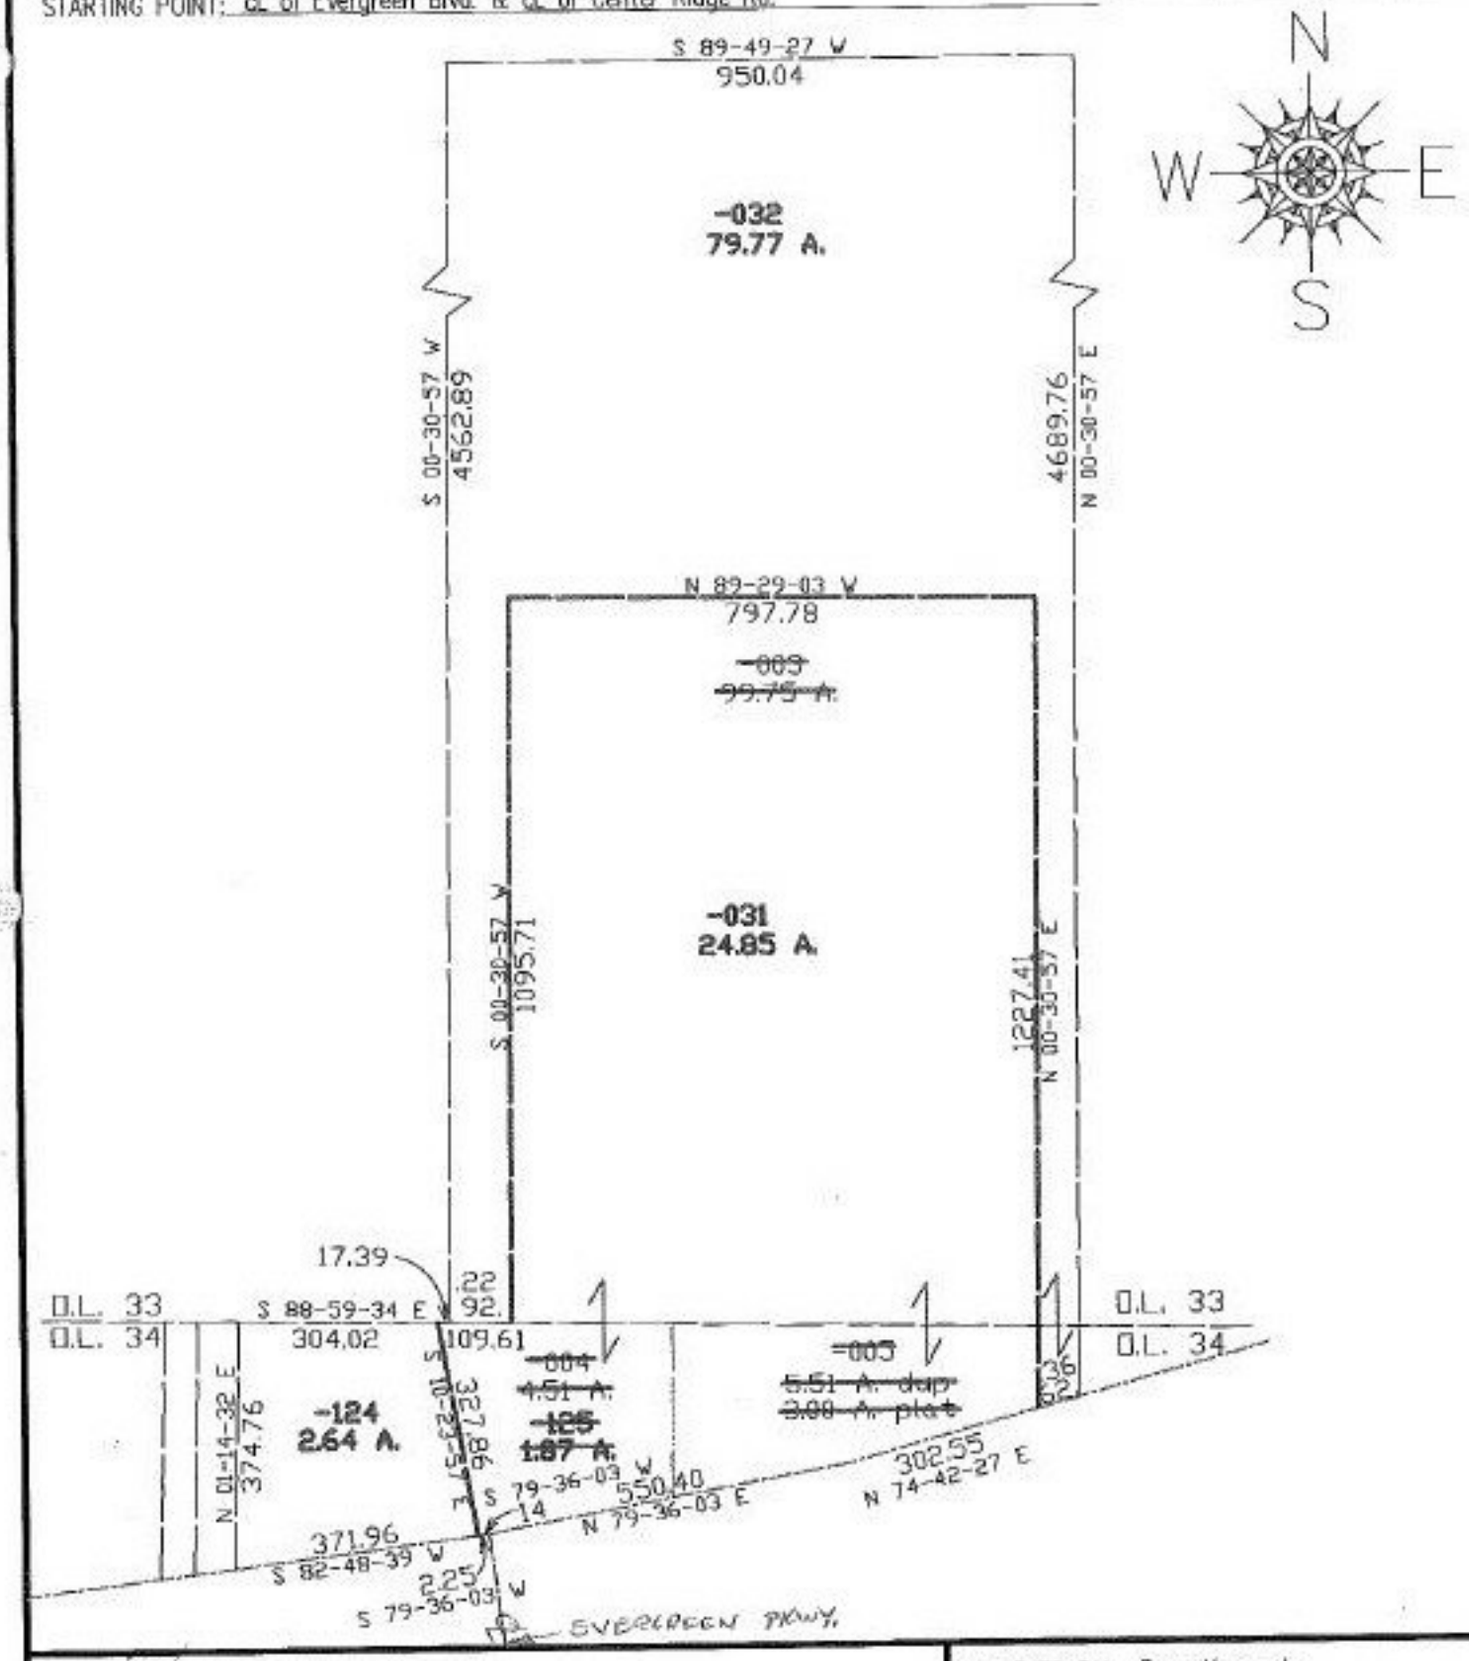

SPLITS/DEEDS PROCESSED

LORAIN COUNTY TAX MAP DEPARTMENT

226 MIDDLE AVE. ELYRIA, OHIO

SURVEYED BY: Dane Hapanek

CLOSURE: 0.77:10,000

MAP PAGE(S): 7-B, 7-00-034-A

APPROVED BY: kac DATE: 2/4/98

SCALE: 1" = 300 PRIOR INSTRUMENT: OR 287/242