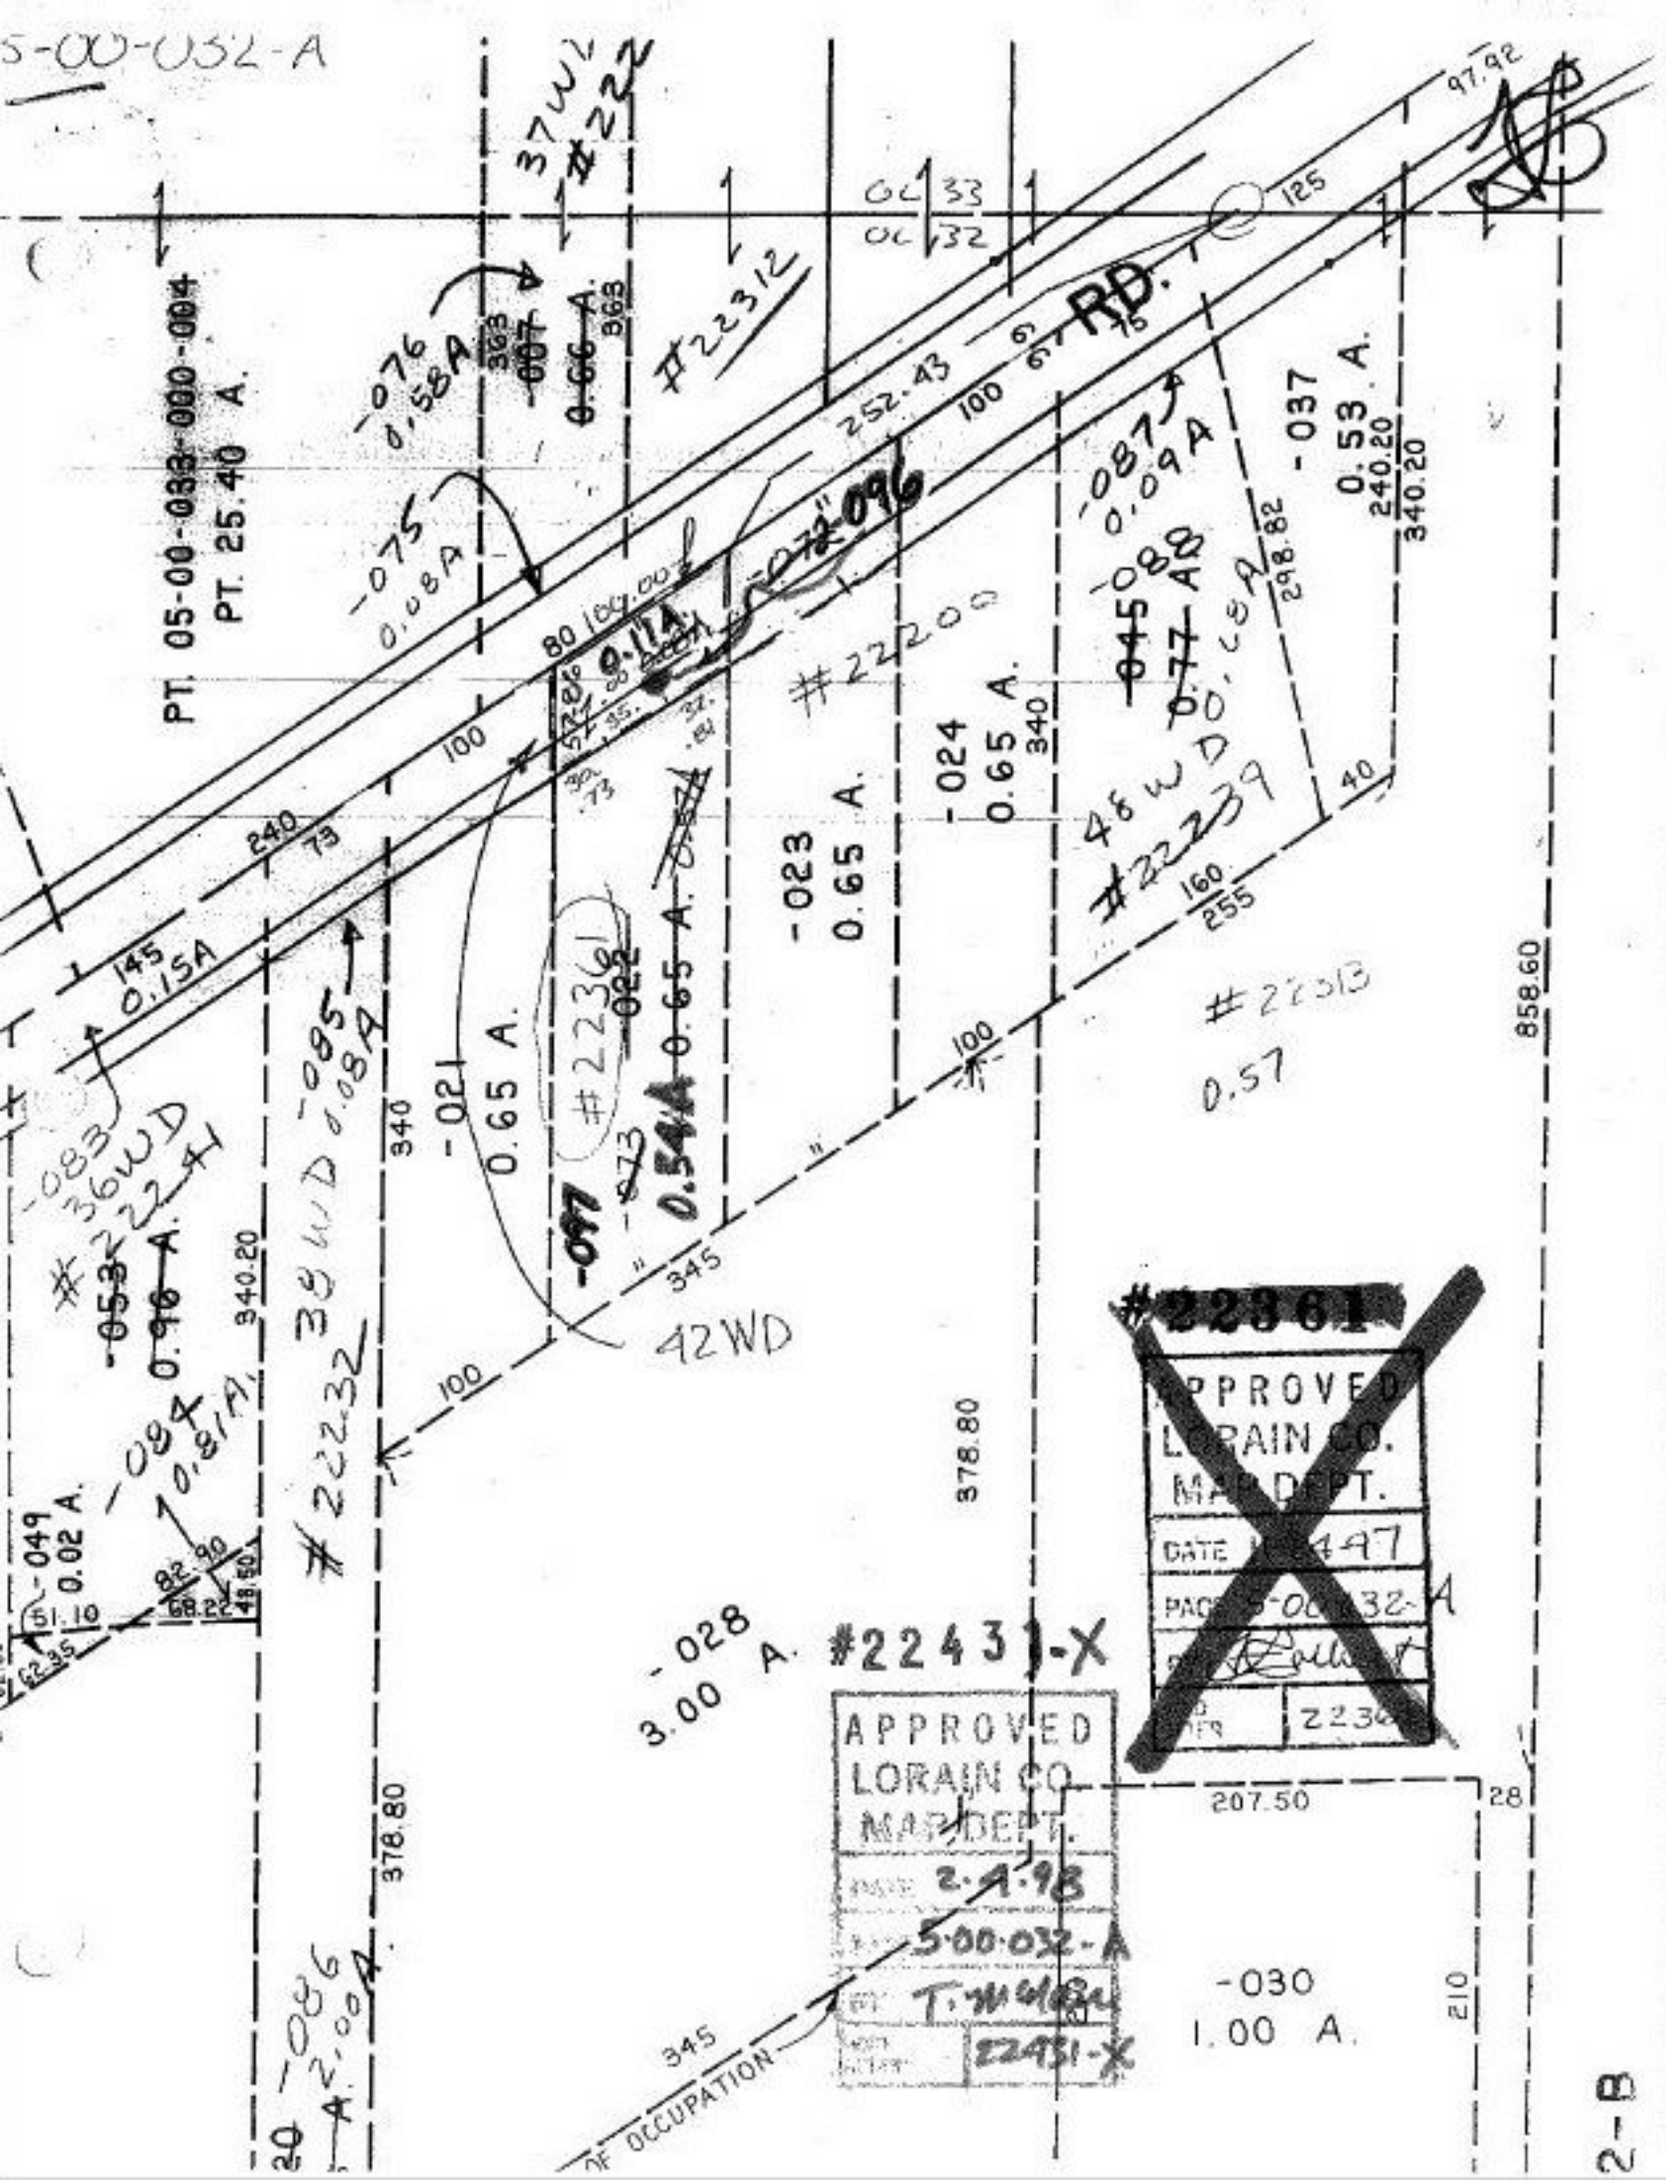
5-00-032-A
PT. 05-00-033-000-004
PT. 25.40 A.
37WD
#222
#22312
OL 33
OL 32
RD.
-076
0.58A
-007
0.66 A.
-075
0.08A
-072
-096
0.11A
#22200
-087
0.09A
-045
0.77 A
-088
0.08A
-037
0.53 A.
-024
0.65 A.
-023
0.65 A.
48WD
#22239
#22313
0.57
-021
0.65 A.
#22361
-022
0.65 A.
-073
0.54A
-097
42WD
-085
0.08A
38WD
#22232
-083
36WD
#22241
-053
0.96 A.
-084
0.81A
-049
0.02 A.
-028
3.00 A.
#22431-X
-030
1.00 A.
-086
2.00A
OF OCCUPATION
#22361
APPROVED
LORAIN CO.
MAP DEPT.
DATE
PAGE 5-00-032-A
APPROVED
LORAIN CO.
MAP DEPT.
DATE 2-4-98
5-00-032-A
22431-X
2-B