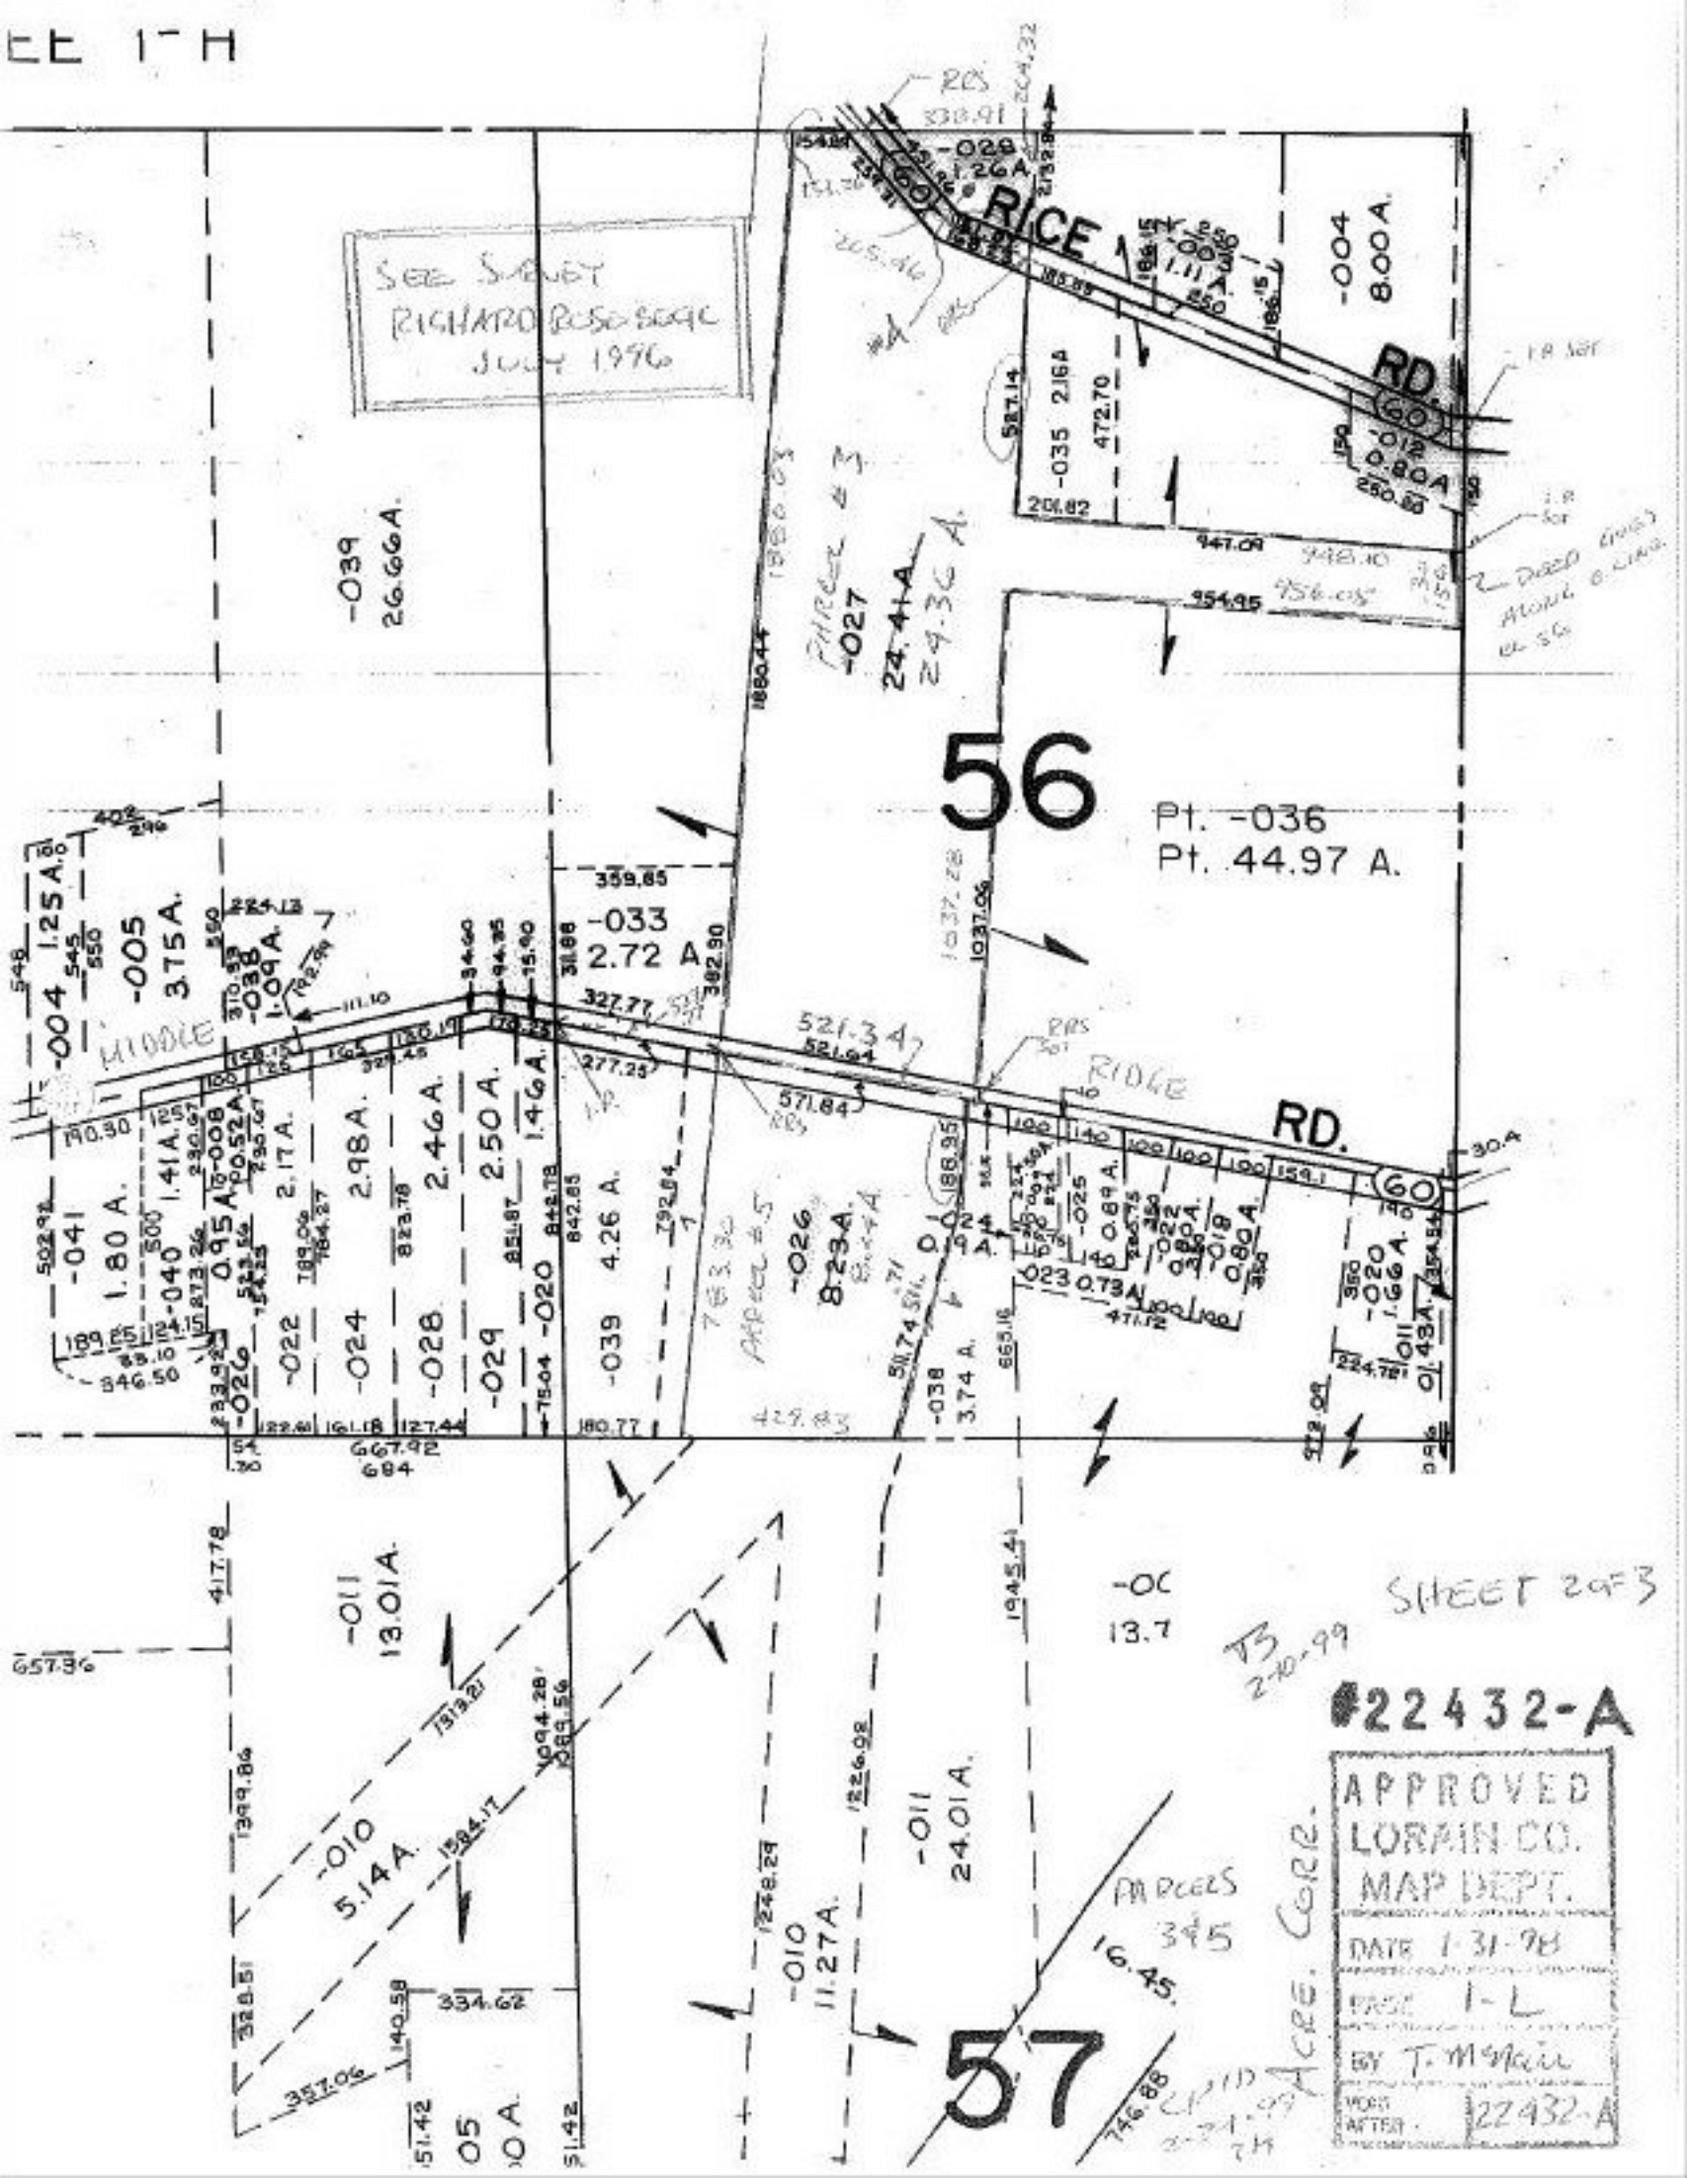
SEE SHEET
RIGHARD ROSE SURVEY
JULY 1996
RICE
RD.
RIDGE
RD.
MIDDLE
56
Pt. -036
Pt. 44.97 A.
57
-039
26.66A.
-027
24.41A.
29.36 A.
-033
2.72 A
-004 1.25A.
-005 3.75A.
-038 1.09A.
-041 1.80 A.
-040 1.41A.
-008 0.52A.
-022 2.17 A.
-024 2.98A.
-028 2.46 A.
-029 2.50 A.
-020 1.46A.
-039 4.26 A.
-026 8.34A.
-025 0.89A.
-023 0.73A.
-020 1.66A.
-011 0.43A.
-004 8.00A.
-035 2.16A.
-012 0.80A.
-011 13.01A.
-010 5.14A.
-010 11.27A.
-011 24.01A.
-0C 13.7
PARCEL #3
PARCEL #5
PARCELS 345
16.45 ACRES
SHEET 2 OF 3
#22432-A
APPROVED
LORAIN CO.
MAP DEPT.
DATE 1-31-98
PAGE 1-L
BY T. McNeil
WORK AFTER 22432-A