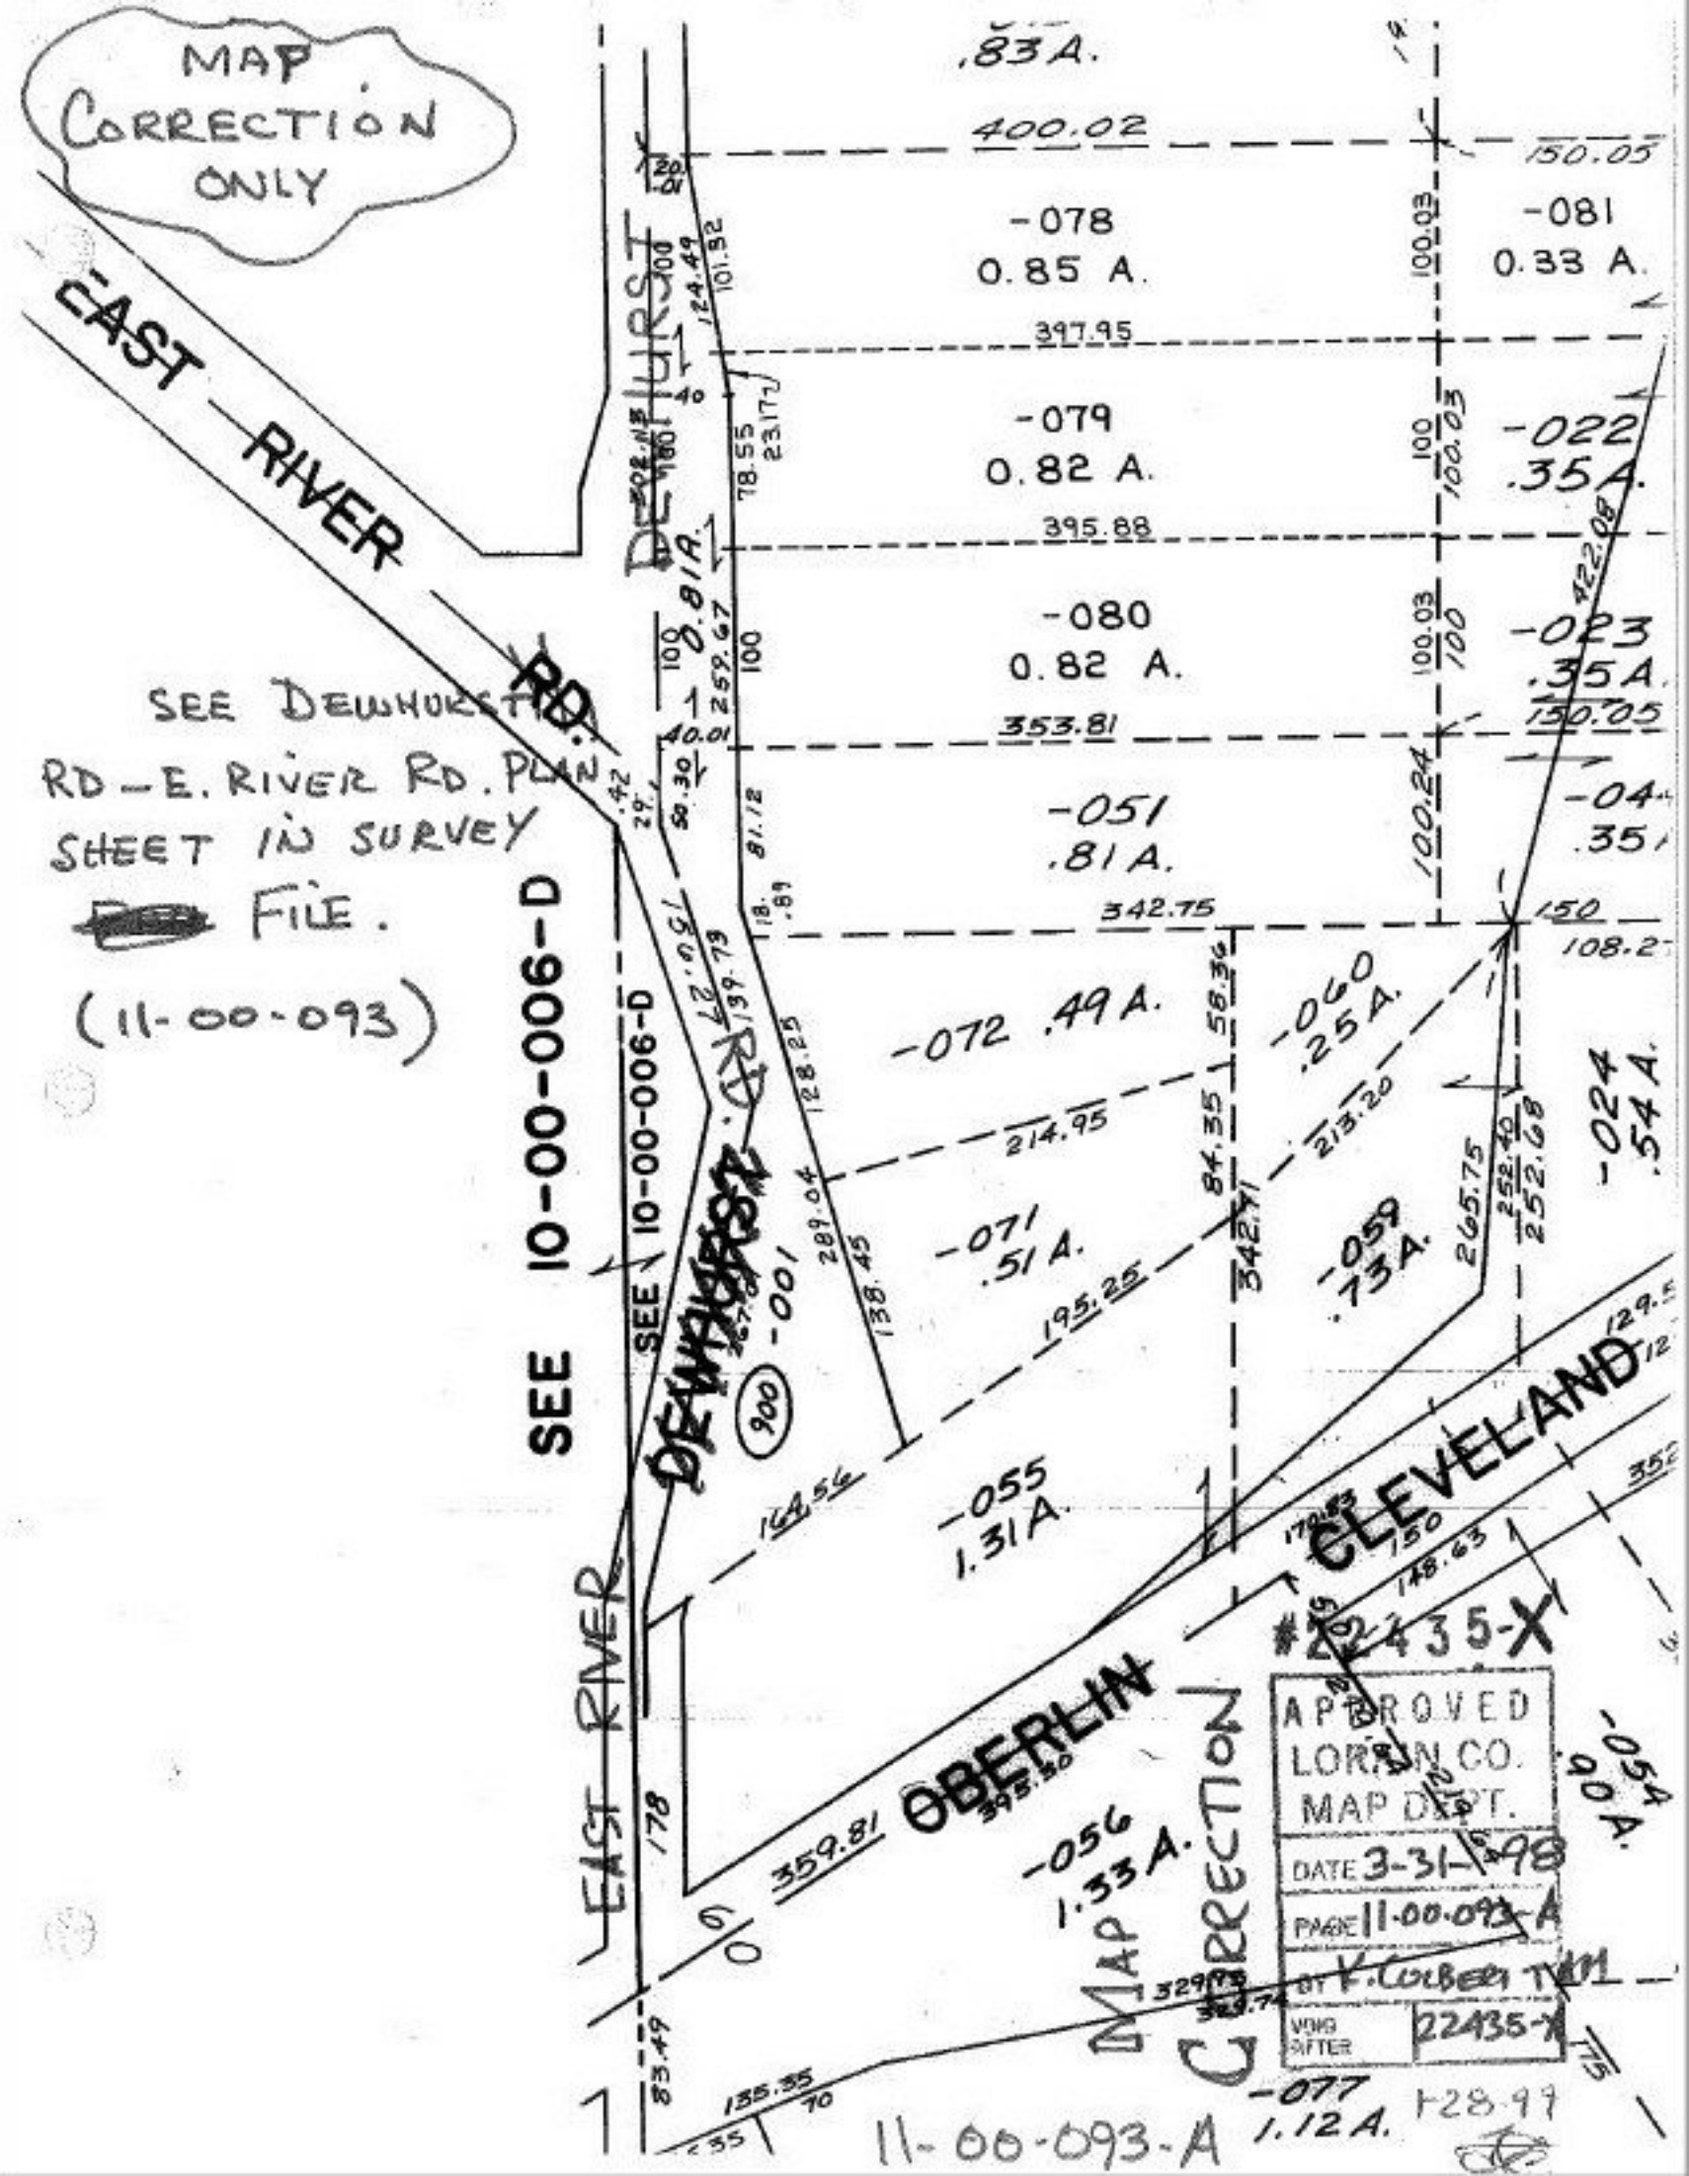
MAP CORRECTION ONLY
EAST RIVER RD.
DEWHURST
SEE 10-00-006-D
SEE DEWHURST RD - E. RIVER RD. PLAN SHEET IN SURVEY FILE.
(11-00-093)
.83 A.
400.02
150.05
-078
0.85 A.
-081
0.33 A.
397.95
-079
0.82 A.
-022
.35 A.
395.88
-080
0.82 A.
-023
.35 A.
353.81
150.05
-051
.81 A.
342.75
-072 .49 A.
-060
.25 A.
214.95
-071
.51 A.
-059
.73 A.
-024
.54 A.
195.25
-055
1.31 A.
OBERLIN
CLEVELAND
359.81
-056
1.33 A.
-054
.90 A.
-077
1.12 A.
11-00-093-A
MAP CORRECTION
#22435-X
APPROVED
LORAIN CO.
MAP DEPT.
DATE 3-31-98
PAGE 11-00-093-A
BY K. Colbert TWP
VOID AFTER 22435-X
1-28-99