PARENT PARCEL: 07-00-009-102-006

CHILD PARCEL: 07-00-009-102-040, 041

STARTING POINT: cl. of Monroe Ln. & cl. of Washington Blvd.

NO. 22436

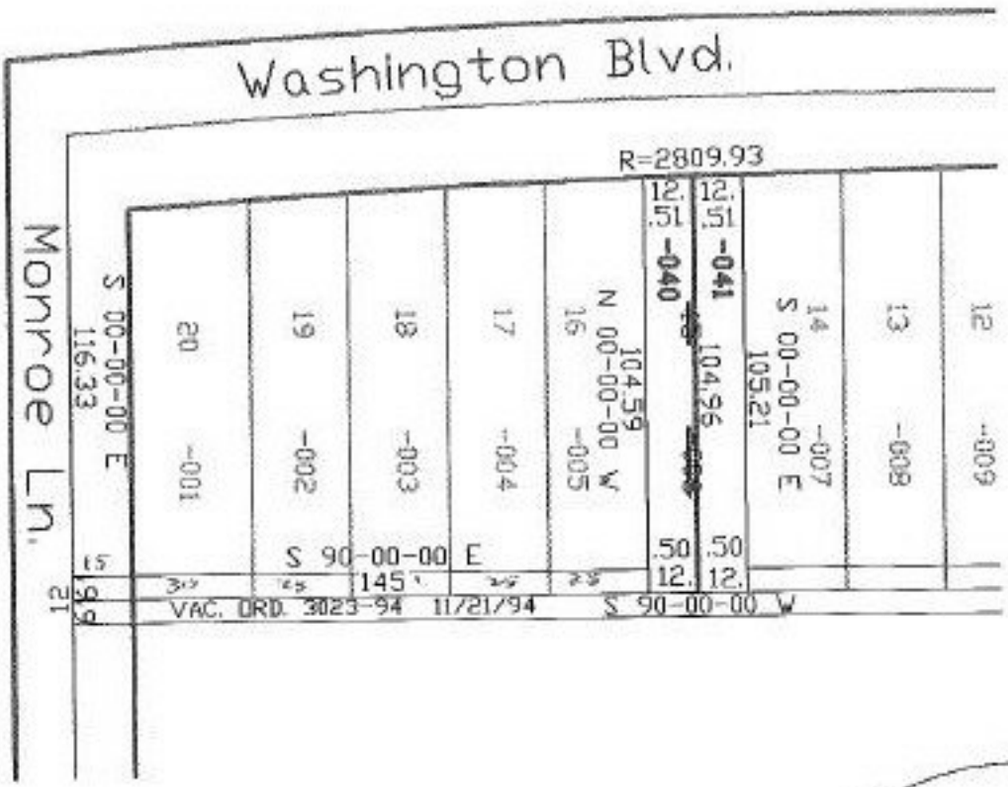

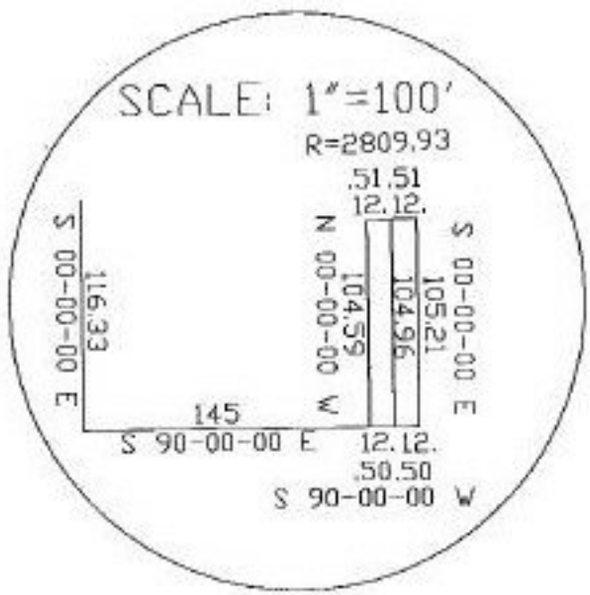

SPLITS/DEEDS PROCESSED

LORAIN COUNTY TAX MAP DEPARTMENT

226 MIDDLE AVE. ELYRIA, OHIO

SURVEYED BY: Dane Hapanek

CLOSURE: 0.02:10,000

MAP PAGE(S): 07-00-009-A

APPROVED BY: kac DATE: 3/19/98

SCALE: 1"= 50 PRIOR INSTRUMENT: 1748/198