PARENT PARCEL: 10-00-003-120-042, 043

CHILD PARCEL: 10-00-003-120-049

STARTING POINT: S. line of Maple St. & W. line of Middle Ave.

NO. 22445

① 20.07 ✓
R=1090.92

② 89.28 ✓
N 60-39-33 E

③ 40 ✓
N 54-13-41 E

④ 76.49 ✓
N 42-55-06 E

⑤ 39.85
N 80-13-47 E

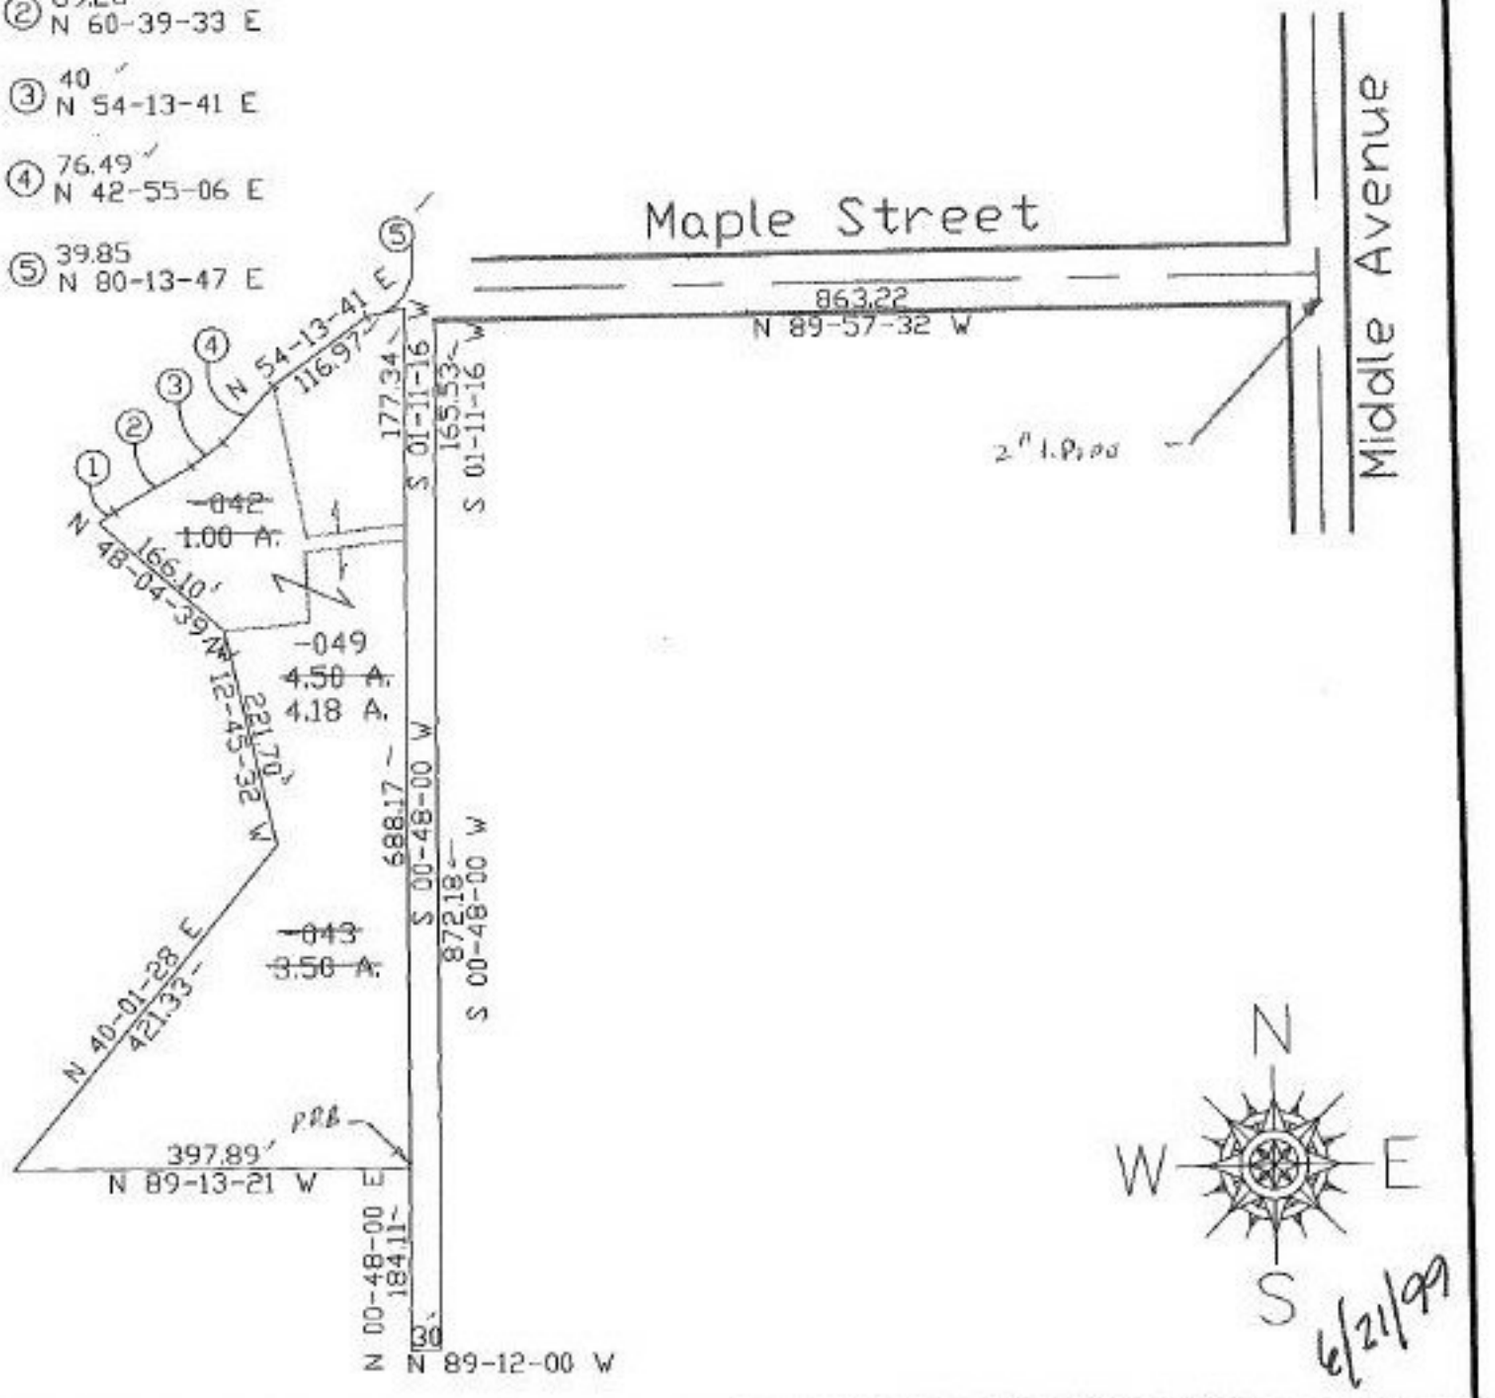

6/21/99

SPLITS/DEEDS PROCESSED

LORAIN COUNTY TAX MAP DEPARTMENT
226 MIDDLE AVE. ELYRIA, OHIO

SURVEYED BY: Robert A. Danner

CLOSURE: 0.02:10,000

MAP PAGE(S): 10-00-003-0

APPROVED BY: kac DATE: 03/04/98

SCALE: 1" = 200 PRIOR INSTRUMENT: OR 441/547