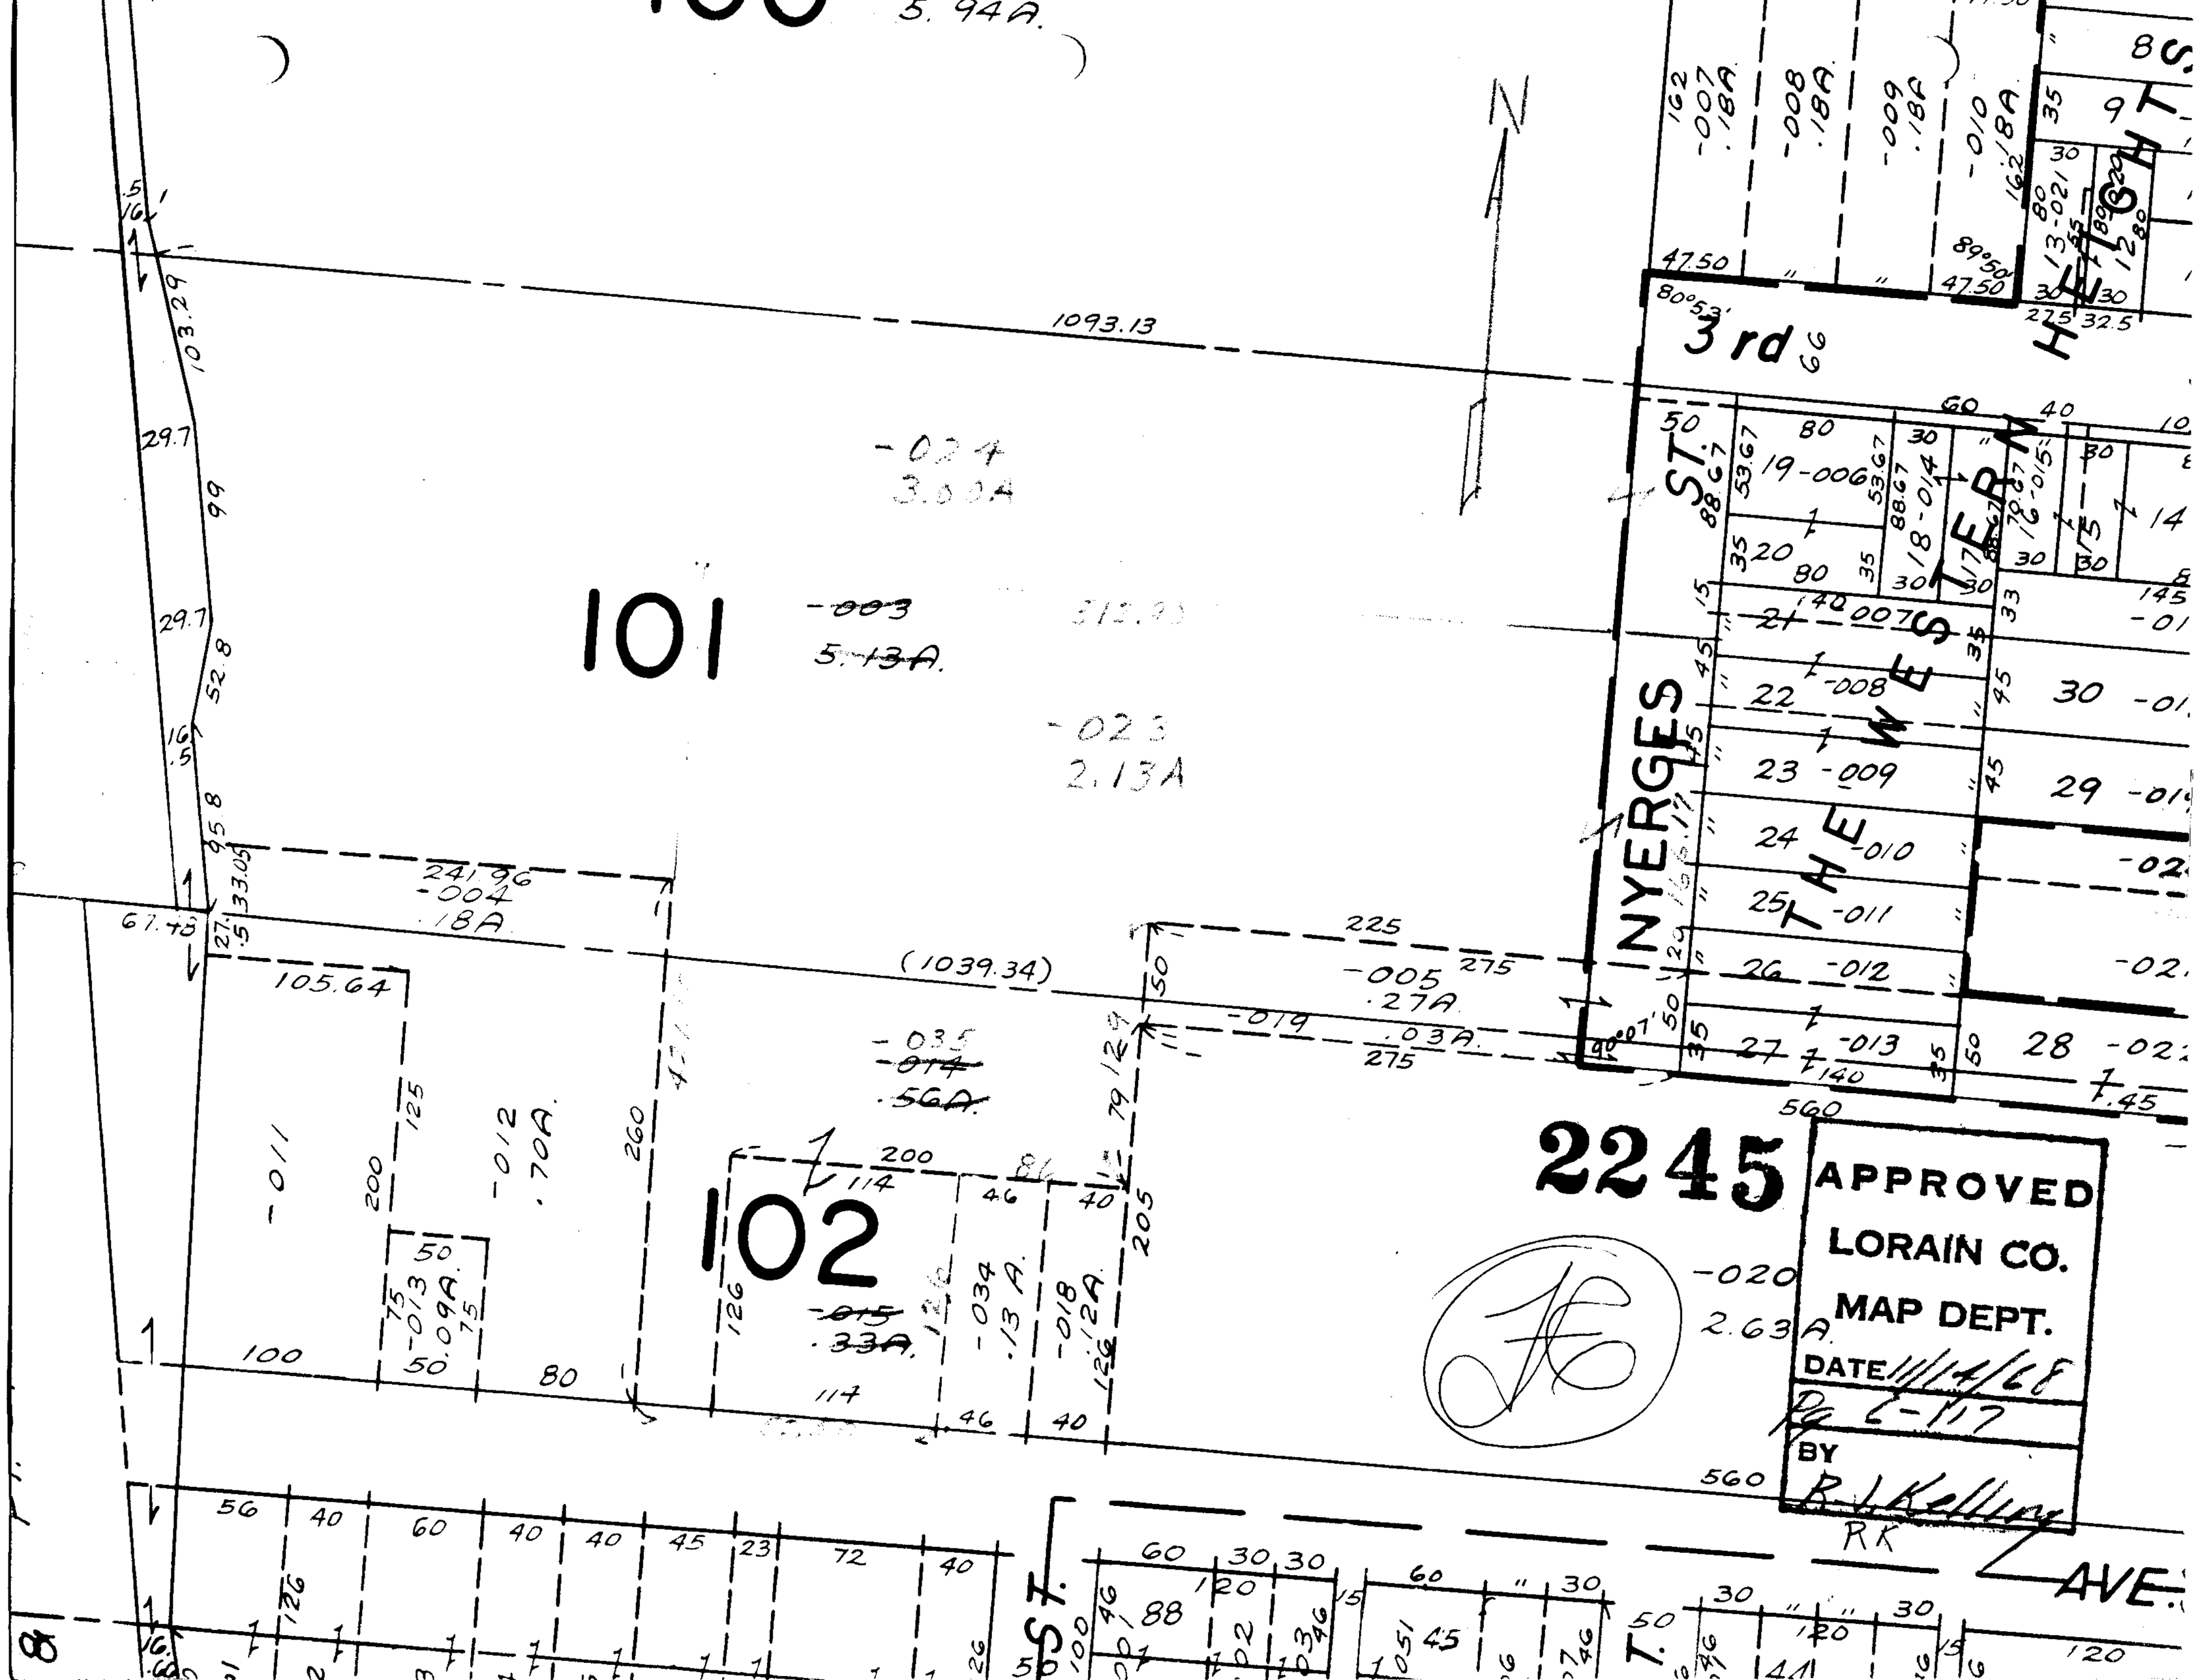

100
5.94A.
101
102
1093.13
(1039.34)
3rd
NYERGES ST.
THE WESTERN HEIGHTS
2245
APPROVED
LORAIN CO.
MAP DEPT.
DATE 11/14/68
Pg 6-117
BY
R.J. Kelling
RK
AVE.