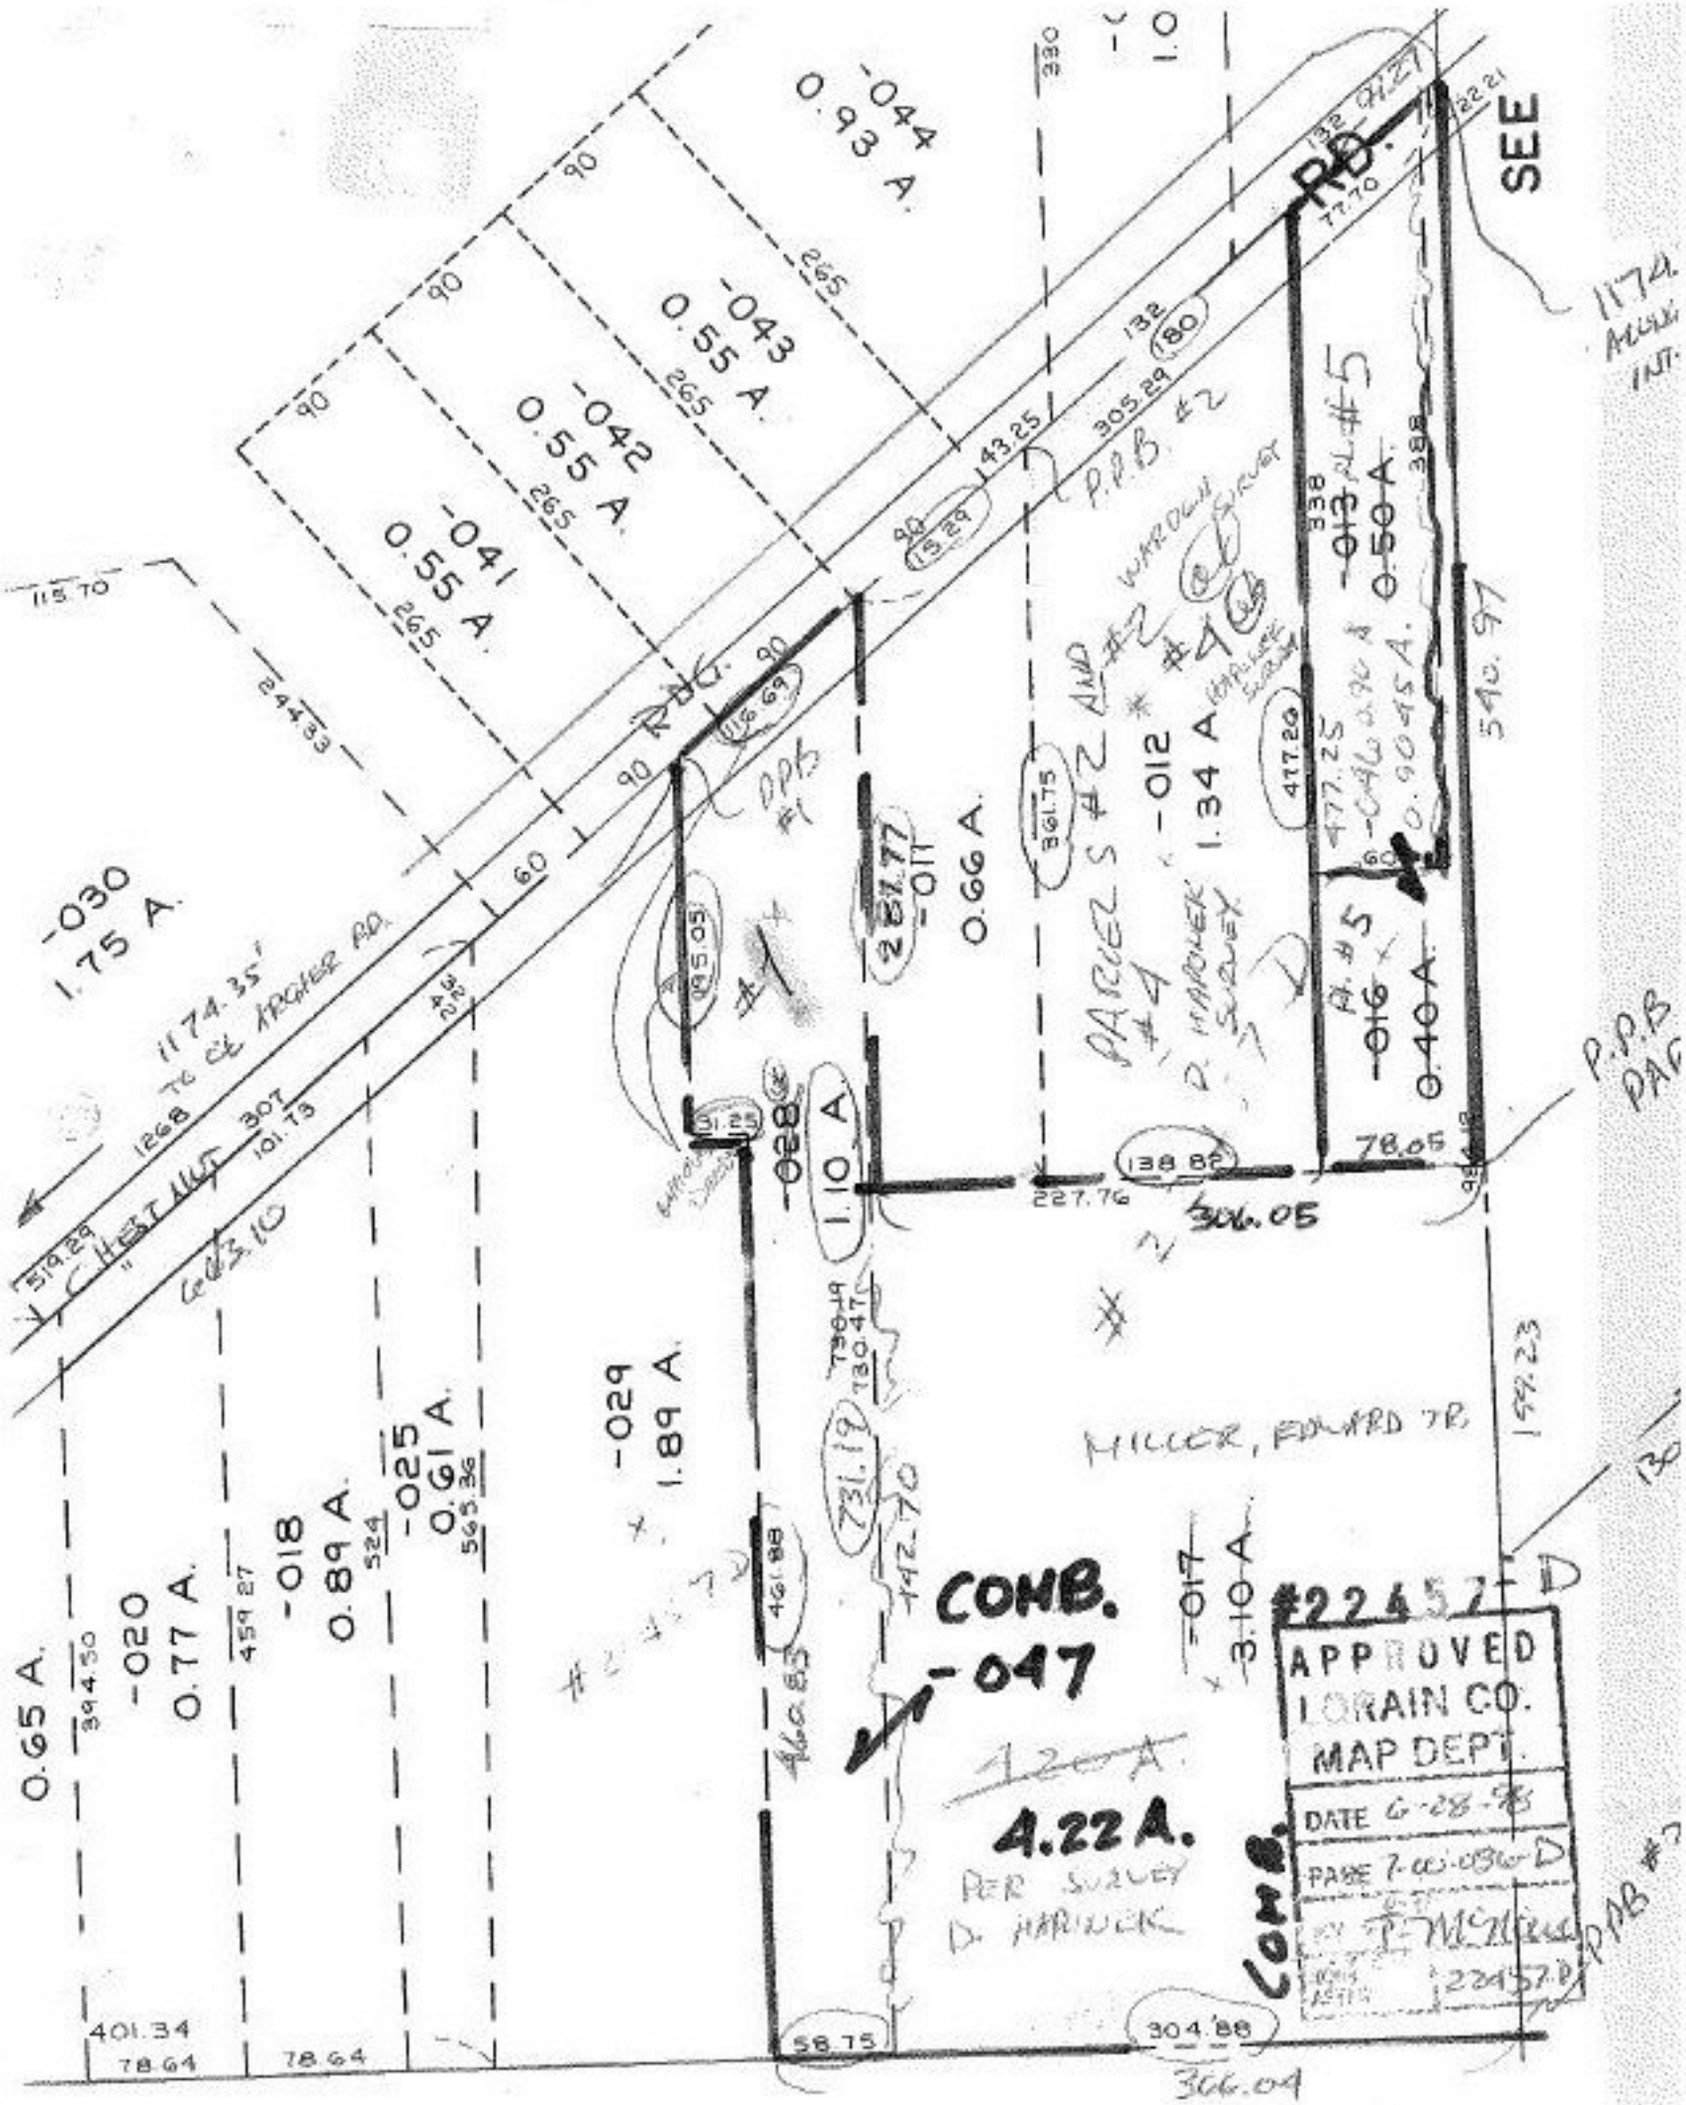

-044
0.93 A.
-043
0.55 A.
-042
0.55 A.
-041
0.55 A.
-030
1.75 A.
-029
1.89 A.
-025
0.61 A.
-018
0.89 A.
-020
0.77 A.
0.65 A.
-011
0.66 A.
-012
1.34 A.
-013
0.50 A.
-016
0.40 A.
-028
1.10 A.
-017
3.10 A.
RD.
SEE
1174.35' TO CL ARCHER RD.
CHESTNUT
P.P.B. #2
P.P.B. #1
PARCEL S #2 AND #2 #4
D. HAPONEK SURVEY
MILLER, EDWARD TR.
COMB.
-047
4.22 A.
PER SURVEY
D. HAPONEK
#22457-D
APPROVED
LORAIN CO.
MAP DEPT.
DATE 6-28-98
PAGE 7-00-036-D
COMB.
22457-D