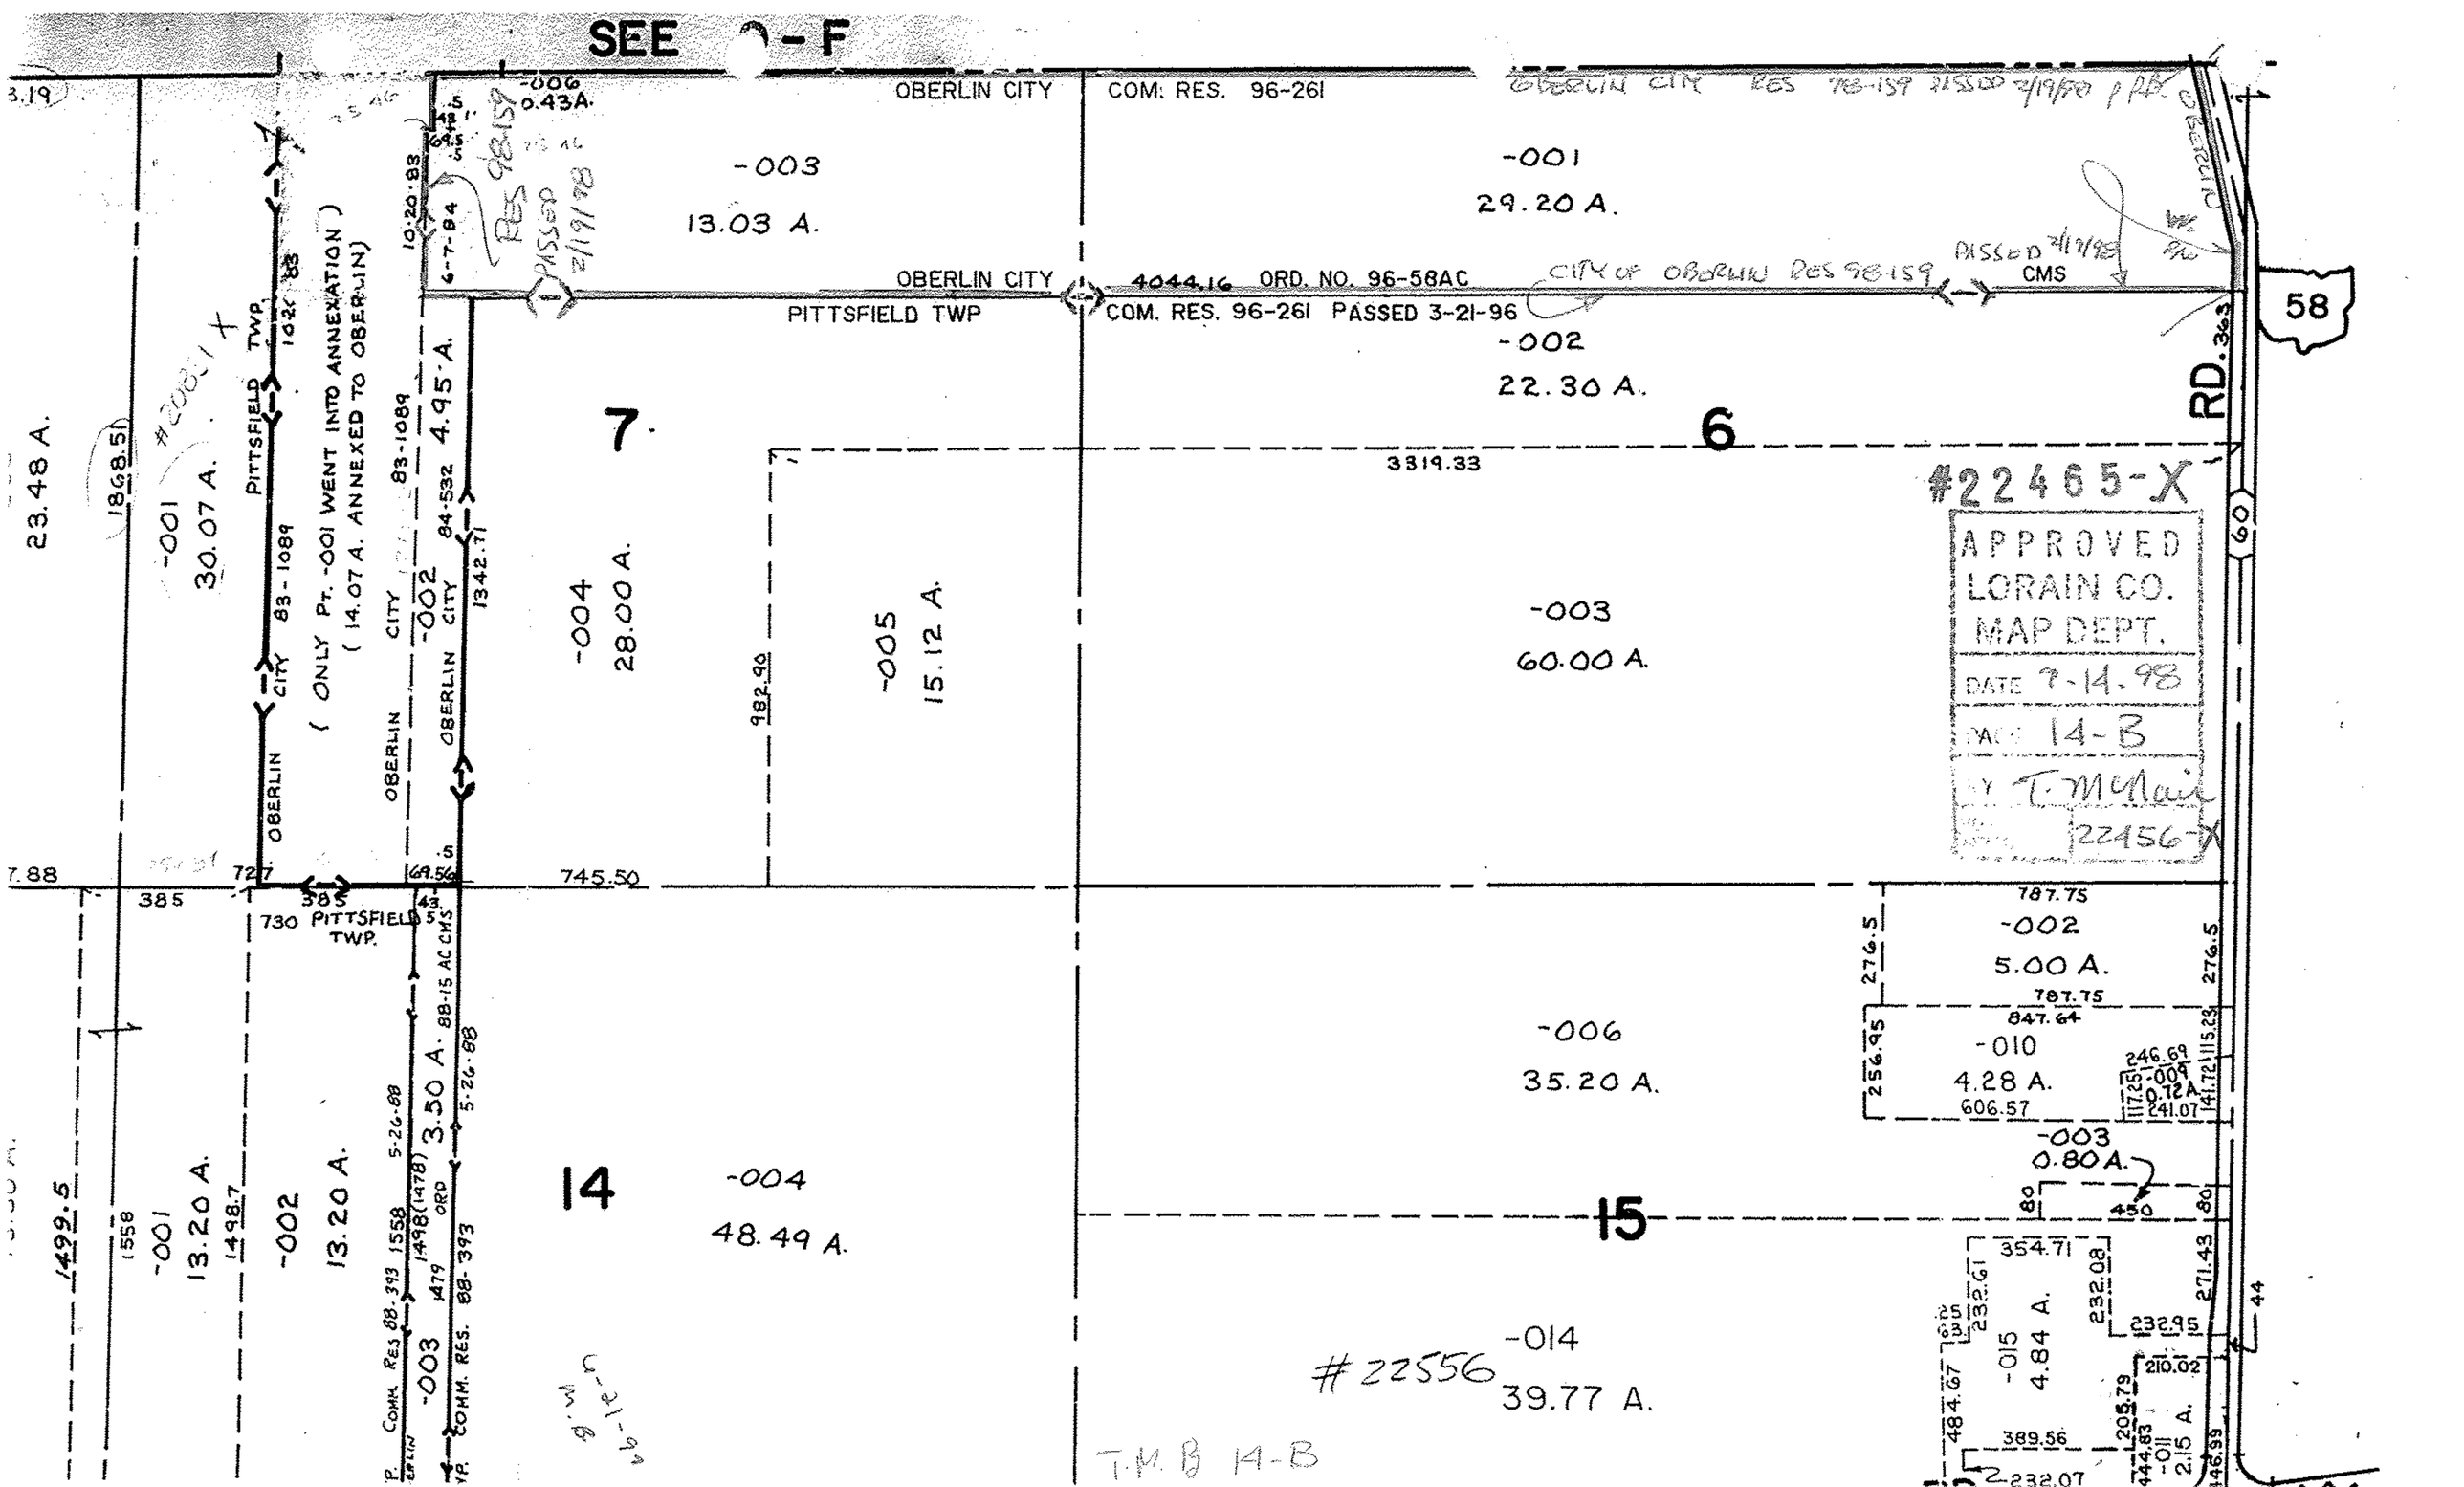
SEE -F
OBERLIN CITY
COM. RES. 96-261
OBERLIN CITY RES 98-159 PASSED 2/19/98
-003
13.03 A.
-001
29.20 A.
OBERLIN CITY
4044.16
ORD. NO. 96-58AC
CITY OF OBERLIN RES 98-159
PASSED 2/19/98
CMS
PITTSFIELD TWP
COM. RES. 96-261 PASSED 3-21-96
-002
22.30 A.
58
RD. 363
7
6
3319.33
#22465-X
APPROVED
LORAIN CO.
MAP DEPT.
DATE 7-14-98
PAGE 14-B
BY T. McNair
22456-X
-001
30.07 A.
23.48 A.
PITTSFIELD TWP.
(ONLY Pt. -001 WENT INTO ANNEXATION)
(14.07 A. ANNEXED TO OBERLIN)
OBERLIN CITY
-002
4.95 A.
-004
28.00 A.
-005
15.12 A.
-003
60.00 A.
982.90
745.50
385
730 PITTSFIELD TWP.
-002
5.00 A.
787.75
847.64
-010
4.28 A.
606.57
-006
35.20 A.
-003
0.80 A.
14
-004
48.49 A.
15
-001
13.20 A.
-002
13.20 A.
-003
3.50 A.
COMM. RES. 88-393
-014
39.77 A.
#22556
-015
4.84 A.
354.71
232.08
232.95
210.02
389.56
232.07
T.M.B 14-B
1499.5
1558
1498.7
1498(1478)
1479
ORD
5-26-88
88-15 AC CMS
1342.71
84-532
83-1089
10-20-83
6-7-84
RES 98-159
PASSED 2/19/98
1868.51
#20851-X
-006
0.43A.
-009
0.72 A.
241.07
246.69
117.25
115.23
276.5
256.95
80
450
271.43
44
60