PARENT PARCEL: 18-00-003-000-024

CHILD PARCEL: 18-00-003-000-025, 026, 027

STARTING POINT: cl. of Medina-Norwalk Rd. & cl. of West Rd.

NO. #22466-A

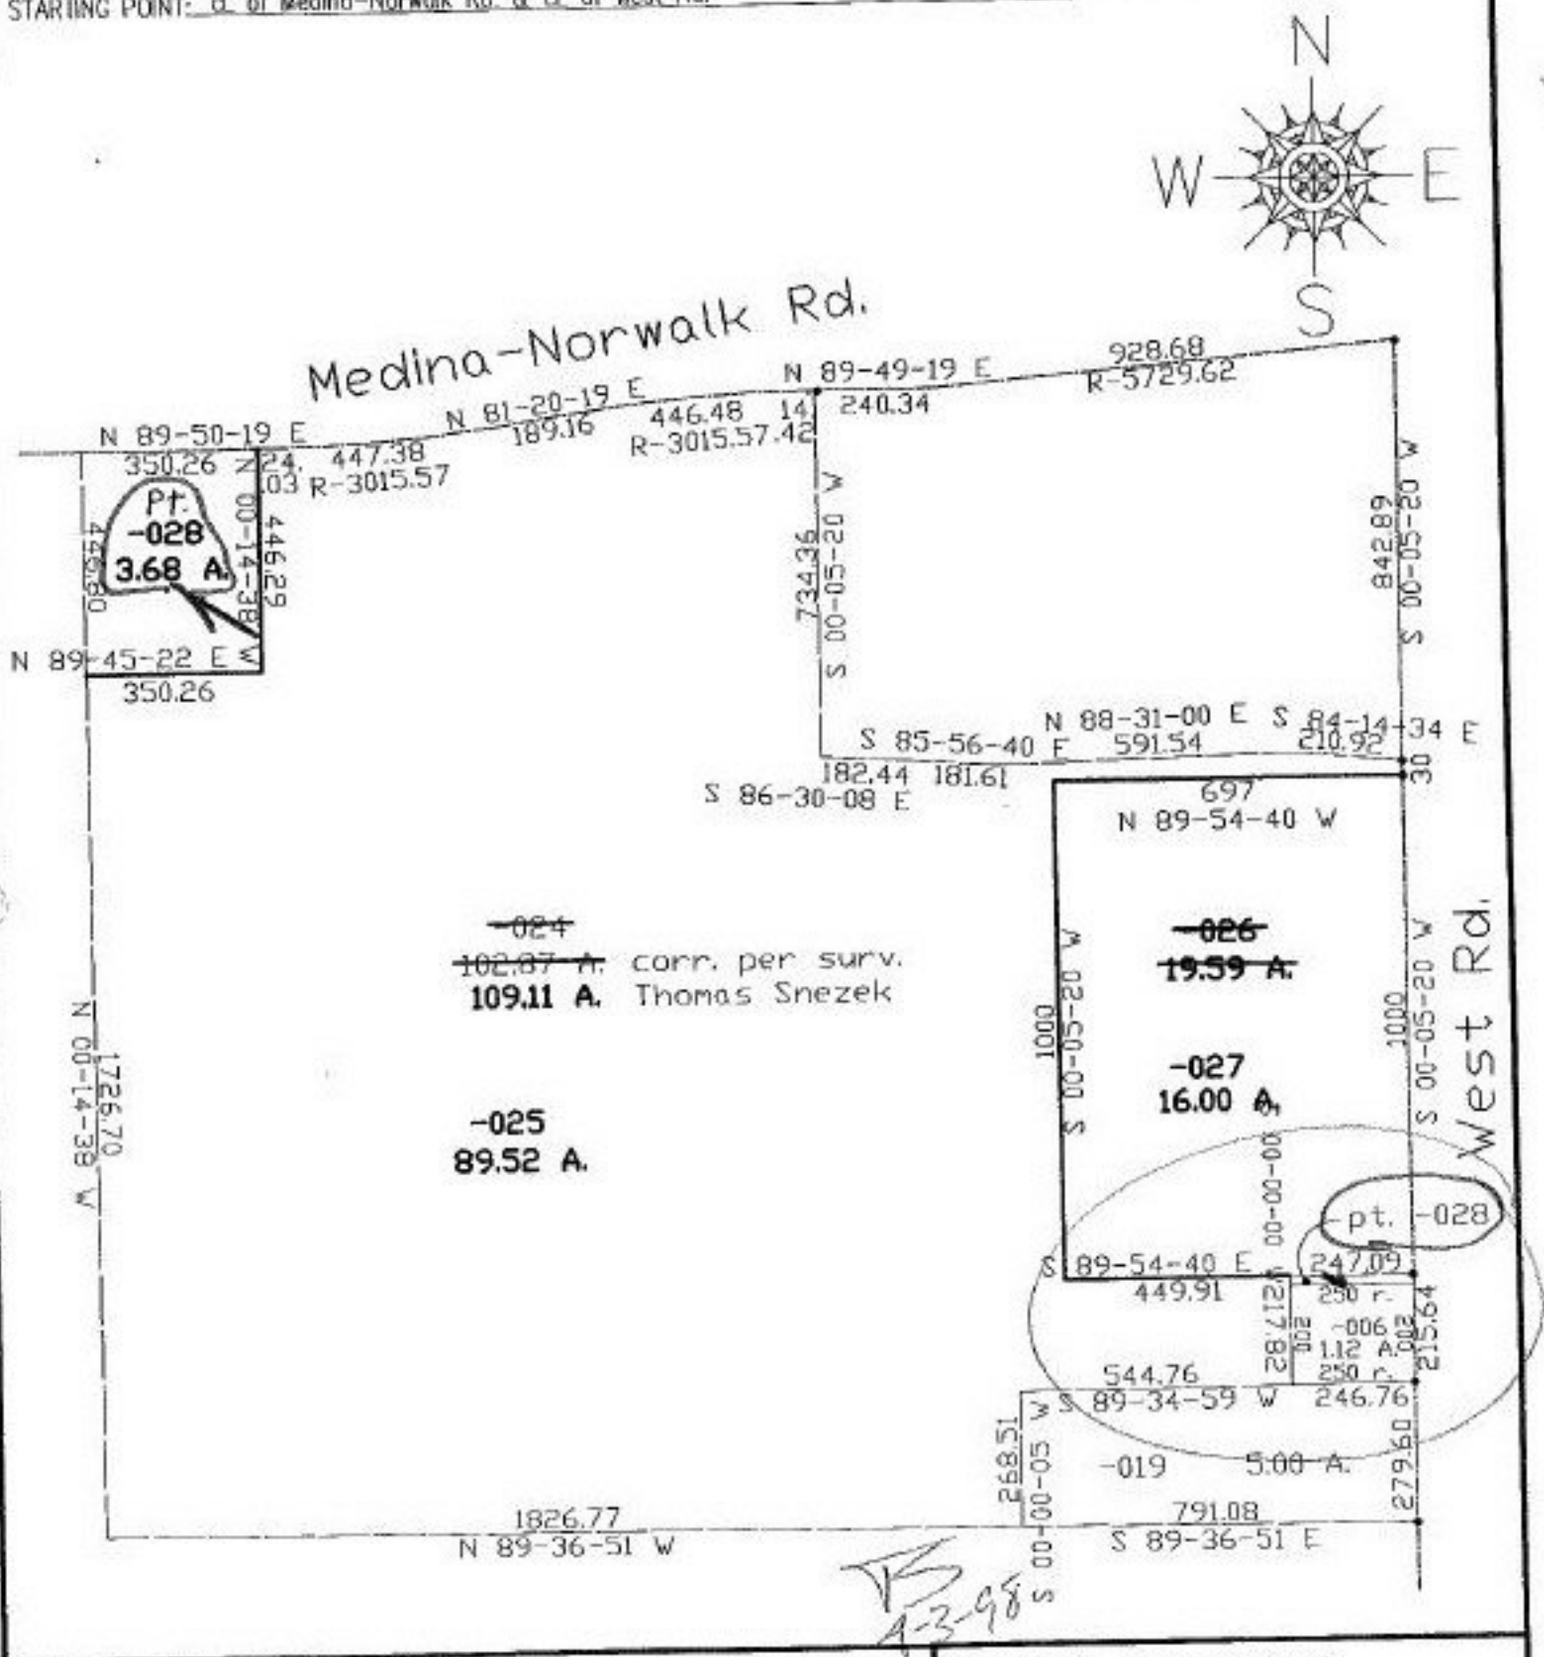

SPLITS/DEEDS PROCESSED

LORAIN COUNTY TAX MAP DEPARTMENT

226 MIDDLE AVE. ELYRIA, OHIO

SURVEYED BY: Thomas M. Snezek

CLOSURE: 0.03:10,000

MAP PAGE(S): 18-H

APPROVED BY: kac DATE: 10/7/97

SCALE: 1"= 400 PRIOR INSTRUMENT: OR 602/144