PARENT PARCEL: 17-08-019-000-007

CHILD PARCEL: 17-08-019-000-013, 014

STARTING POINT: cl. of Gore-Orphanage Rd. & N. line of Brighton Twp.

NO. 22470

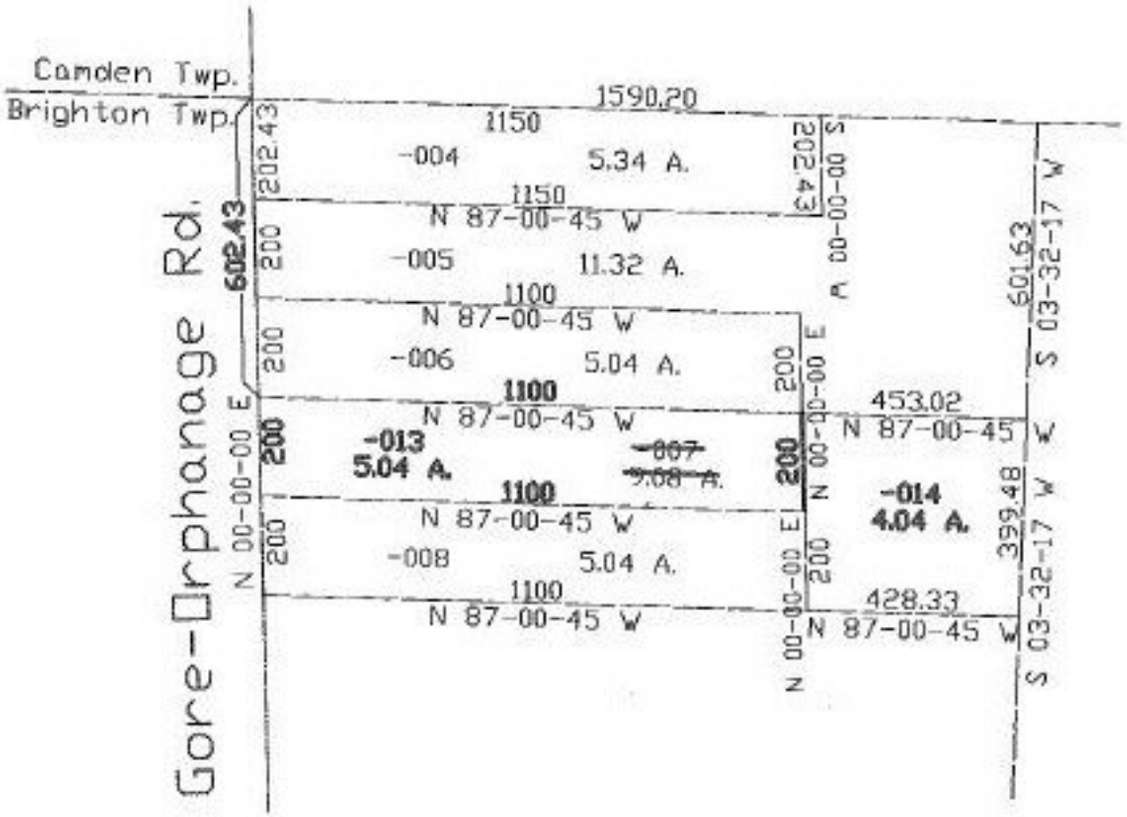

SPLITS/DEEDS PROCESSED

LORAIN COUNTY TAX MAP DEPARTMENT

226 MIDDLE AVE. ELYRIA, OHIO

SURVEYED BY: Thomas A. Sharp

CLOSURE: 0.00:10,000

MAP PAGE(S): 17-A

APPROVED BY: kac DATE: 3/16/98

SCALE: 1"= 400 PRIOR INSTRUMENT: #98511043