PARENT PARCEL: 20-03-012-000-003, 20-03-013-000-001, 002

CHILD PARCEL: 20-03-012-000-004 thru -016, 20-03-013-000-008 thru -018

STARTING POINT: cl. of Ashland Kipton Rd. & S. line of Lorain County

NO. 22471

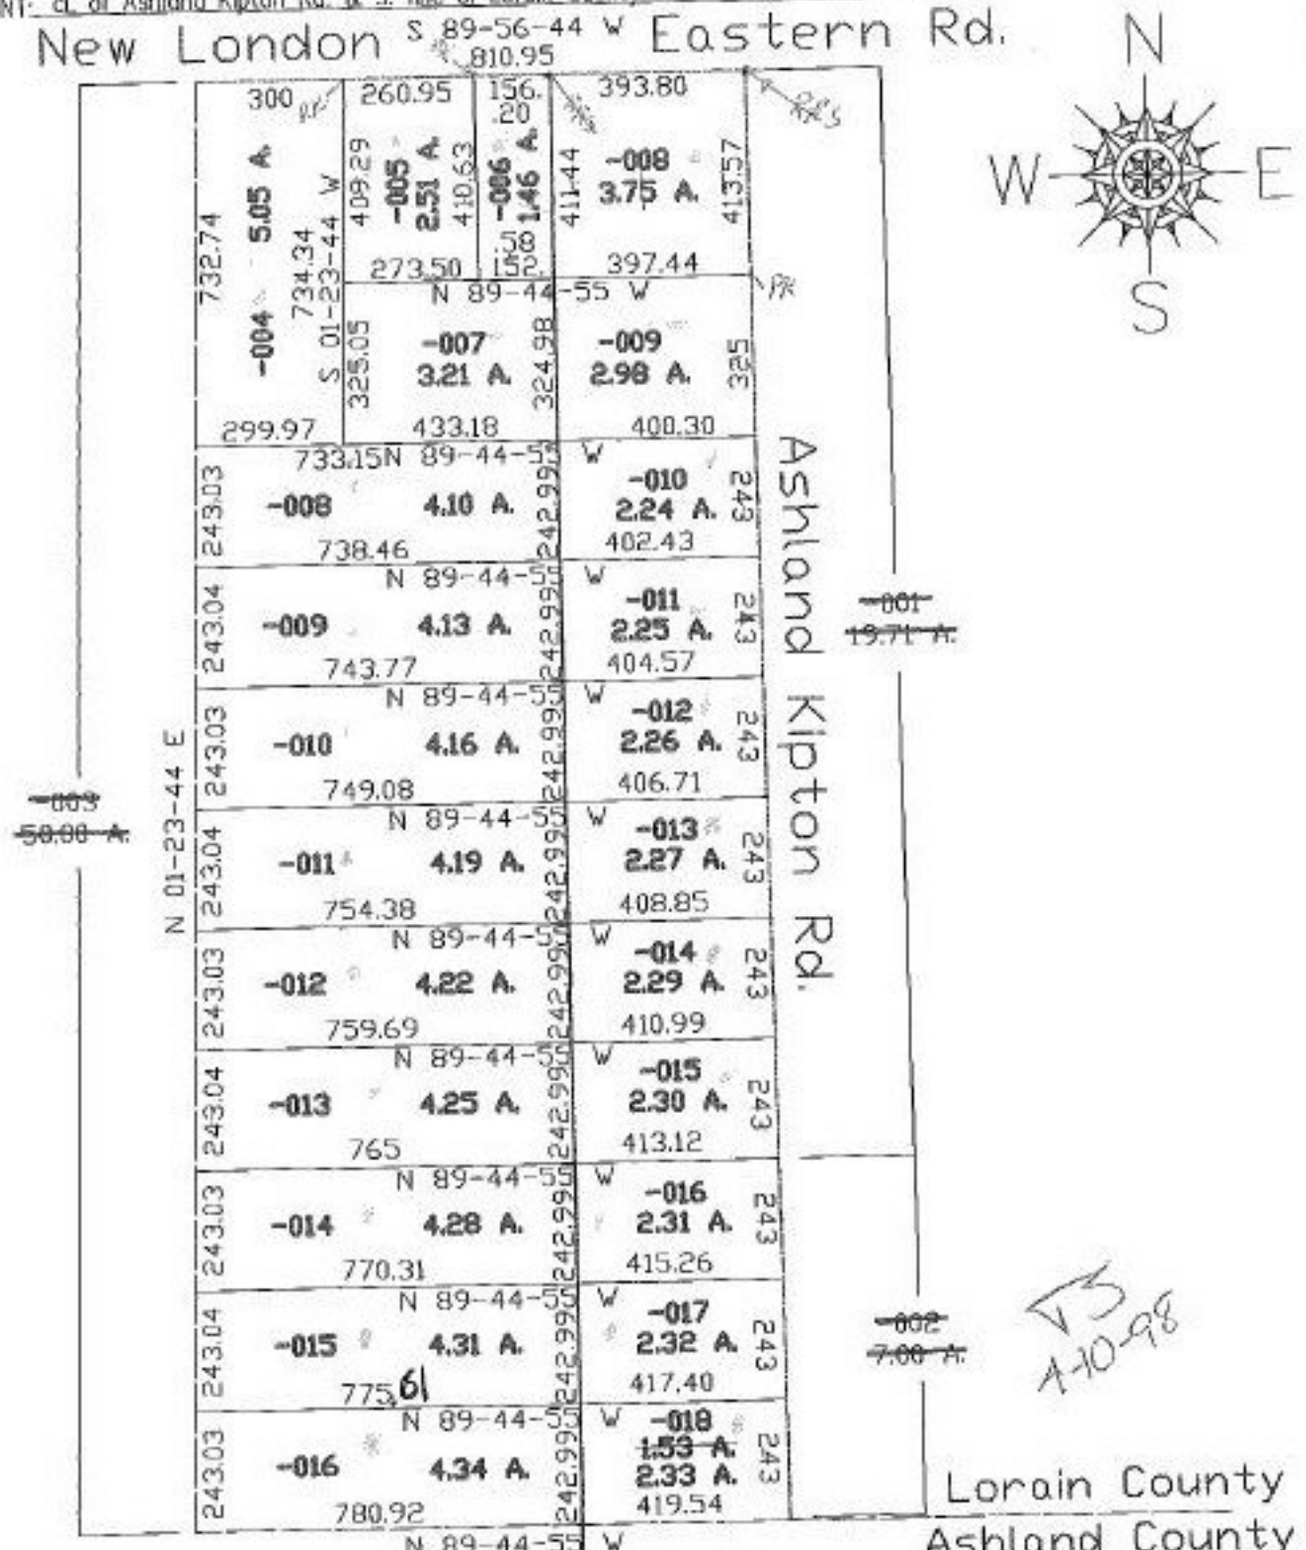

SPLITS/DEEDS PROCESSED

LORAIN COUNTY TAX MAP DEPARTMENT

226 MIDDLE AVE. ELYRIA, OHIO

SURVEYED BY: Thomas A. Sharp

CLOSURE: 0.04:10,000

MAP PAGE(S): 20-G

APPROVED BY: kac DATE: 3/17/98

SCALE: 1"= 400 PRIOR INSTRUMENT: #98512711