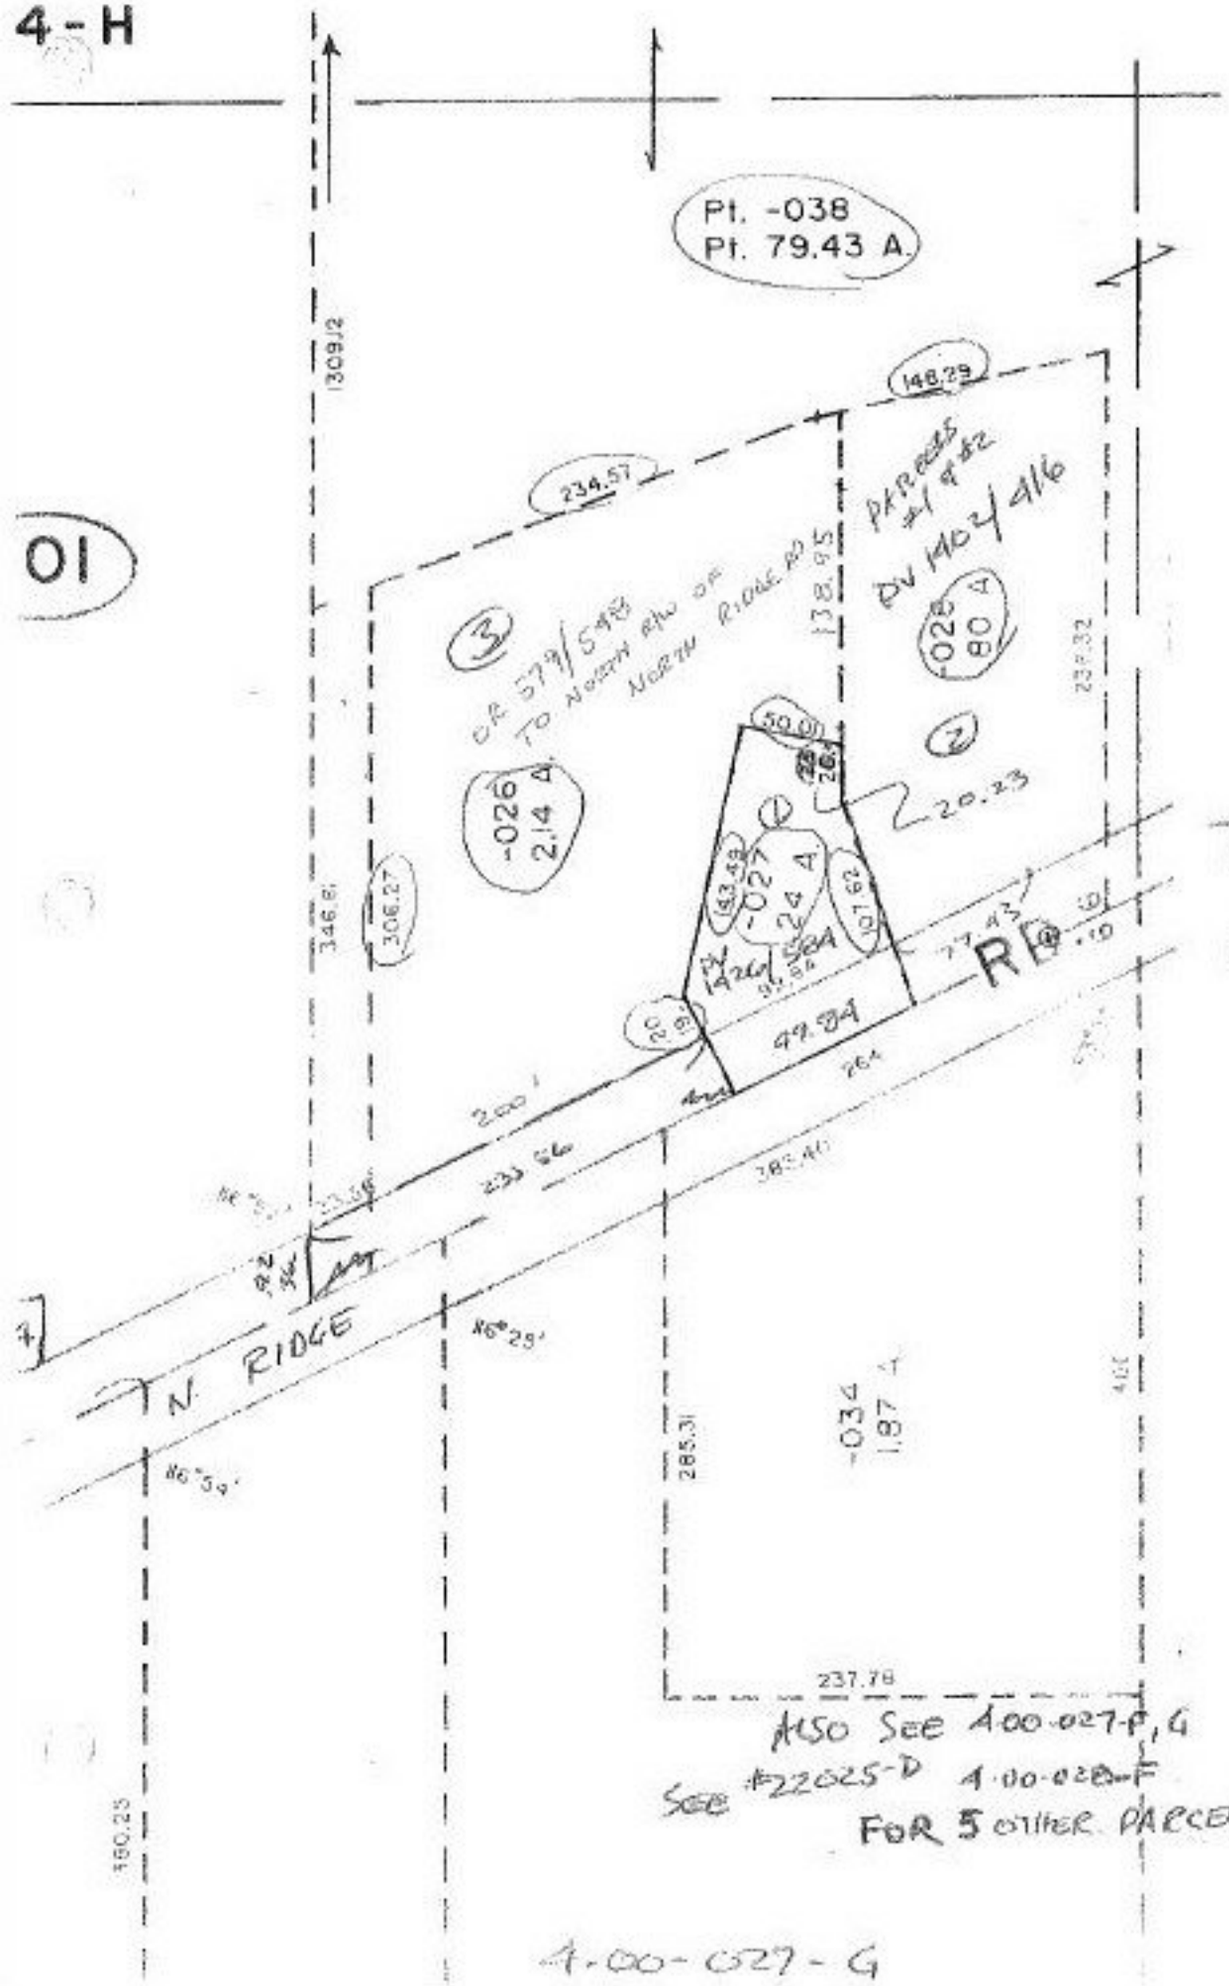

#22474-D

APPROVED
LORAIN CO.
MAP DEPT.
DATE 10-14-98
PAGE 4-H
BY T.M. Mau
22474-D