PARENT PARCEL: 07-00-038-000-094, 124

CHILD PARCEL: 07-00-038-000-126

STARTING POINT: cL of Sugar Ridge Rd. & west line of O.L. 38

NO. 22474

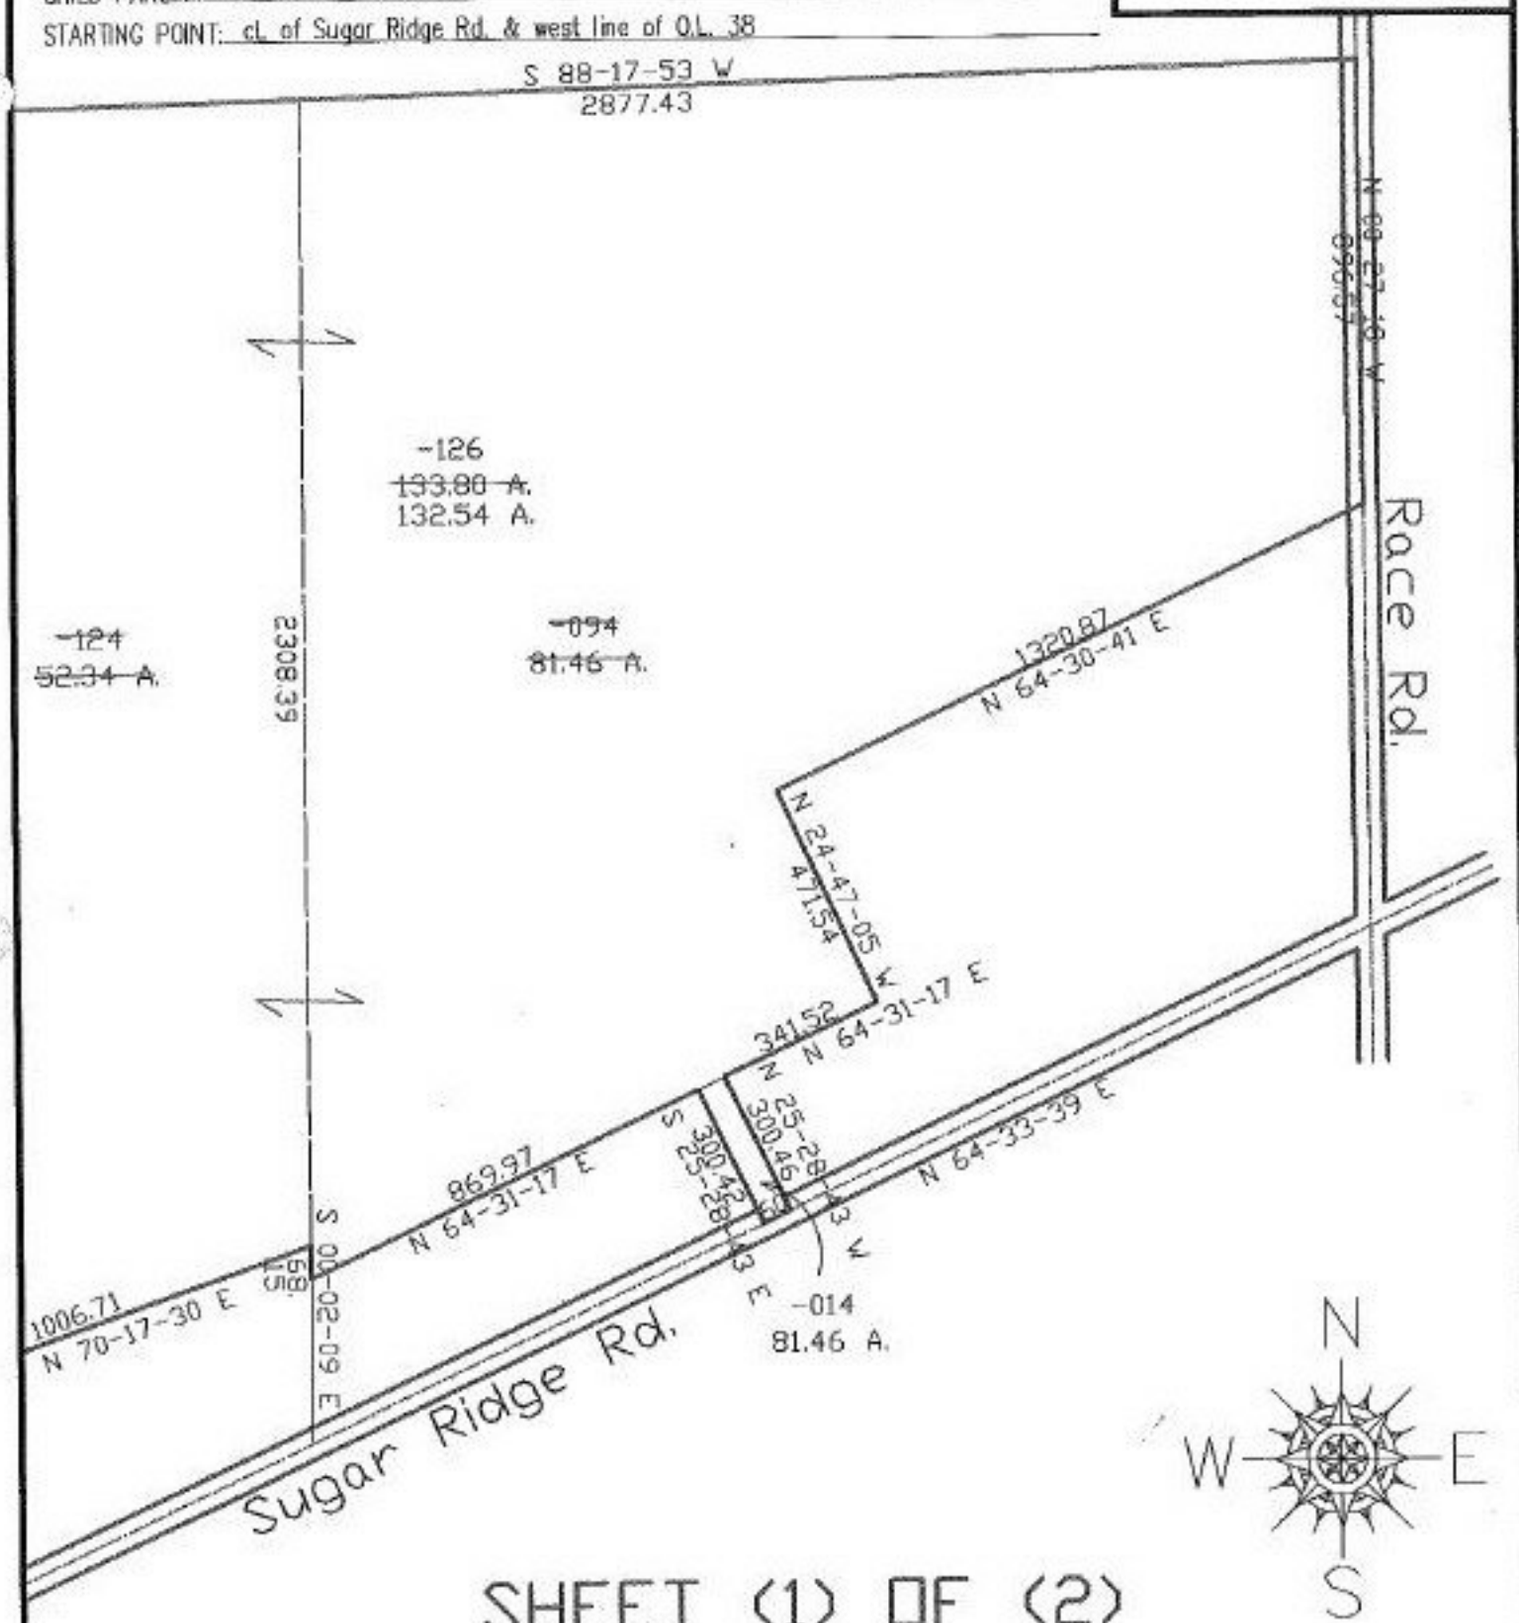

SHEET (1) OF (2)

SPLITS/DEEDS PROCESSED

LORAIN COUNTY TAX MAP DEPARTMENT

226 MIDDLE AVE. ELYRIA, OHIO

SURVEYED BY: Dane A. Hapanek

CLOSURE: 0.01:10,000

MAP PAGE(S): 07-00-038-B, 7-E

APPROVED BY: XXX DATE: 3/18/98

SCALE: 1" = 400 PRIOR INSTRUMENT: DV 1348/560 #970508637