PARENT PARCEL: 15-00-099-101-195

CHILD PARCEL: 15-00-099-101-214 thru -221

STARTING POINT: w. line of Horseshoe Dr. (also e. line of O.L. 99) & SE corner of S/L 530 of Pheasant Run Village Phase 1 Rev. 2 Plat V. 51 P. 35

NO. 22475

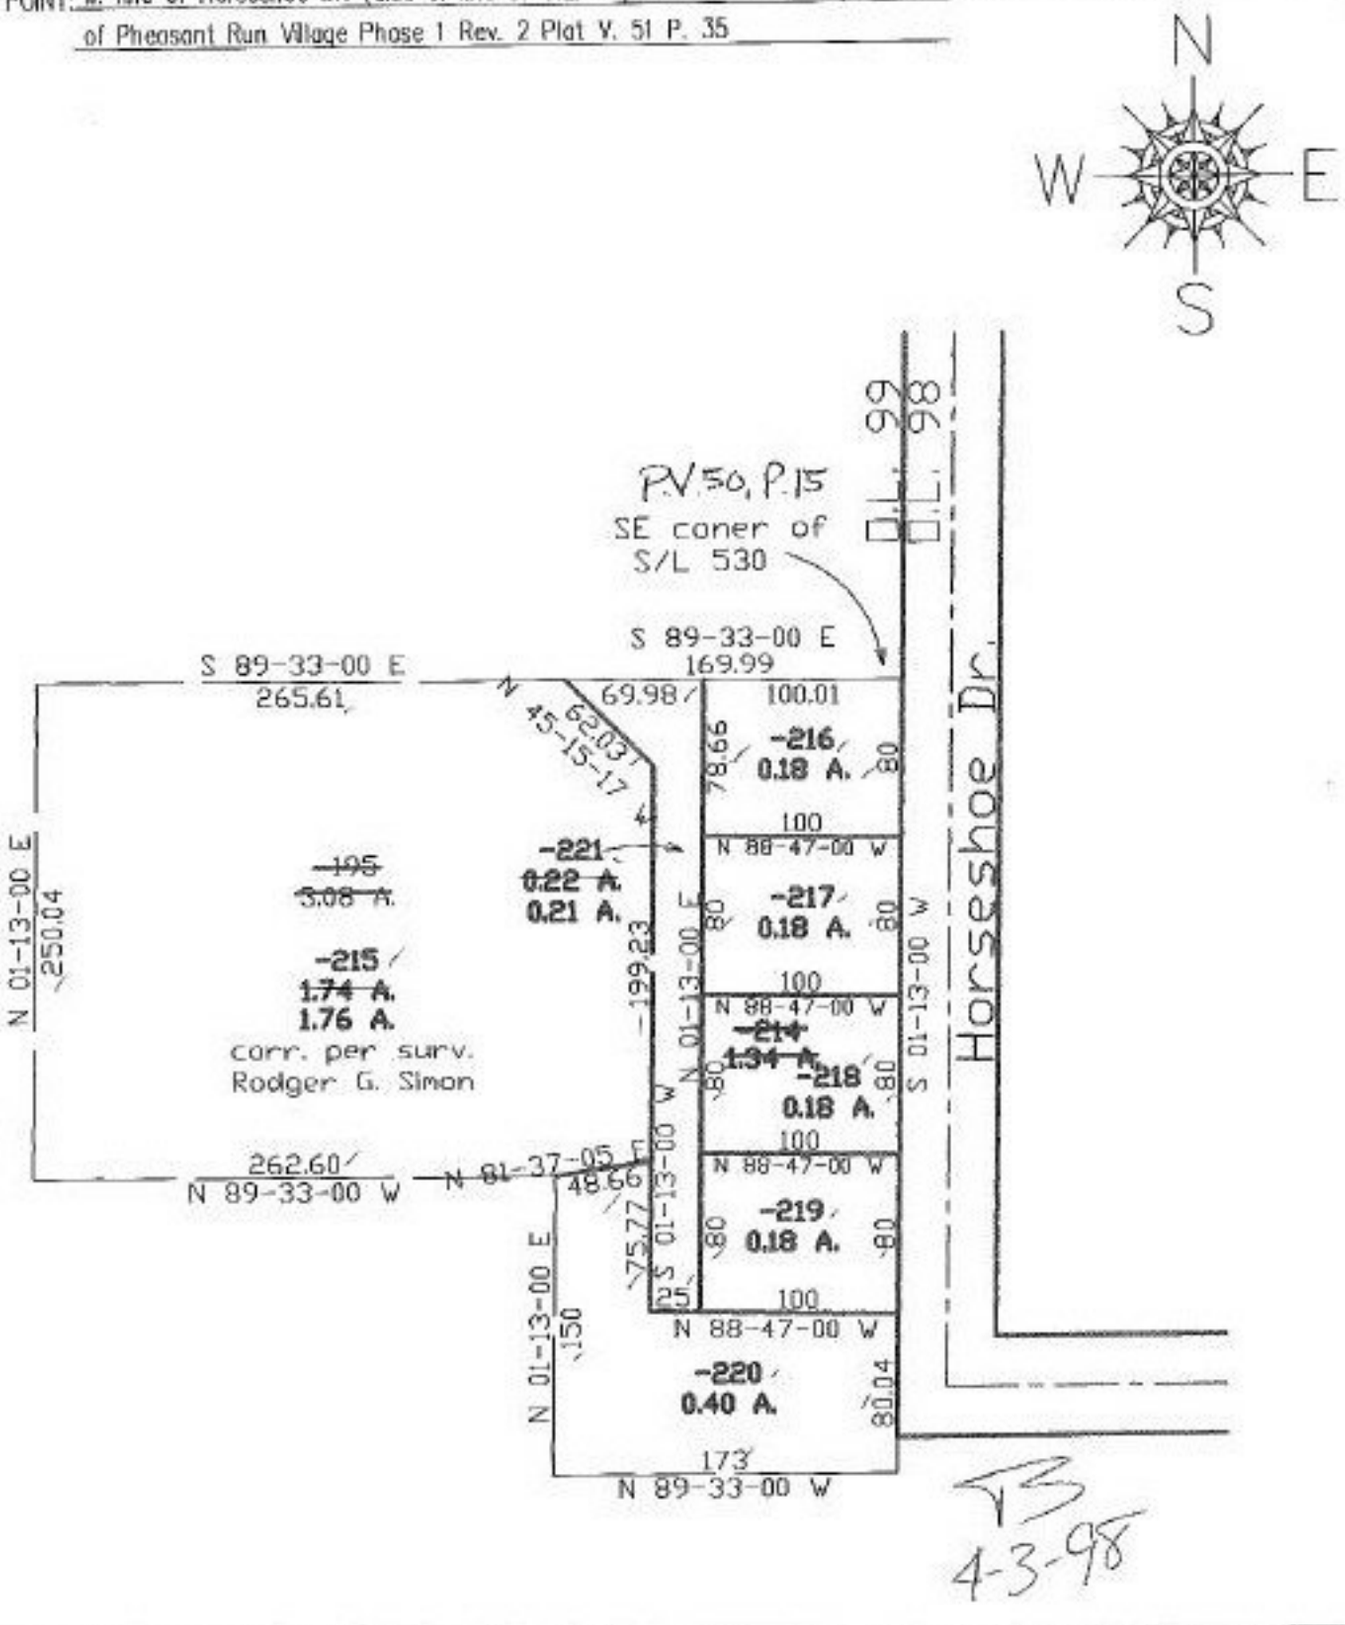

4-3-98

SPLITS/DEEDS PROCESSED

LORAIN COUNTY TAX MAP DEPARTMENT
226 MIDDLE AVE. ELYRIA, OHIO

SURVEYED BY: Rodger G. Simon

CLOSURE: 0.19:10,000

MAP PAGE(S): 15-00-099-8

APPROVED BY: kac DATE: 3/24/98

SCALE: 1" = 100 PRIOR INSTRUMENT: 1071/785