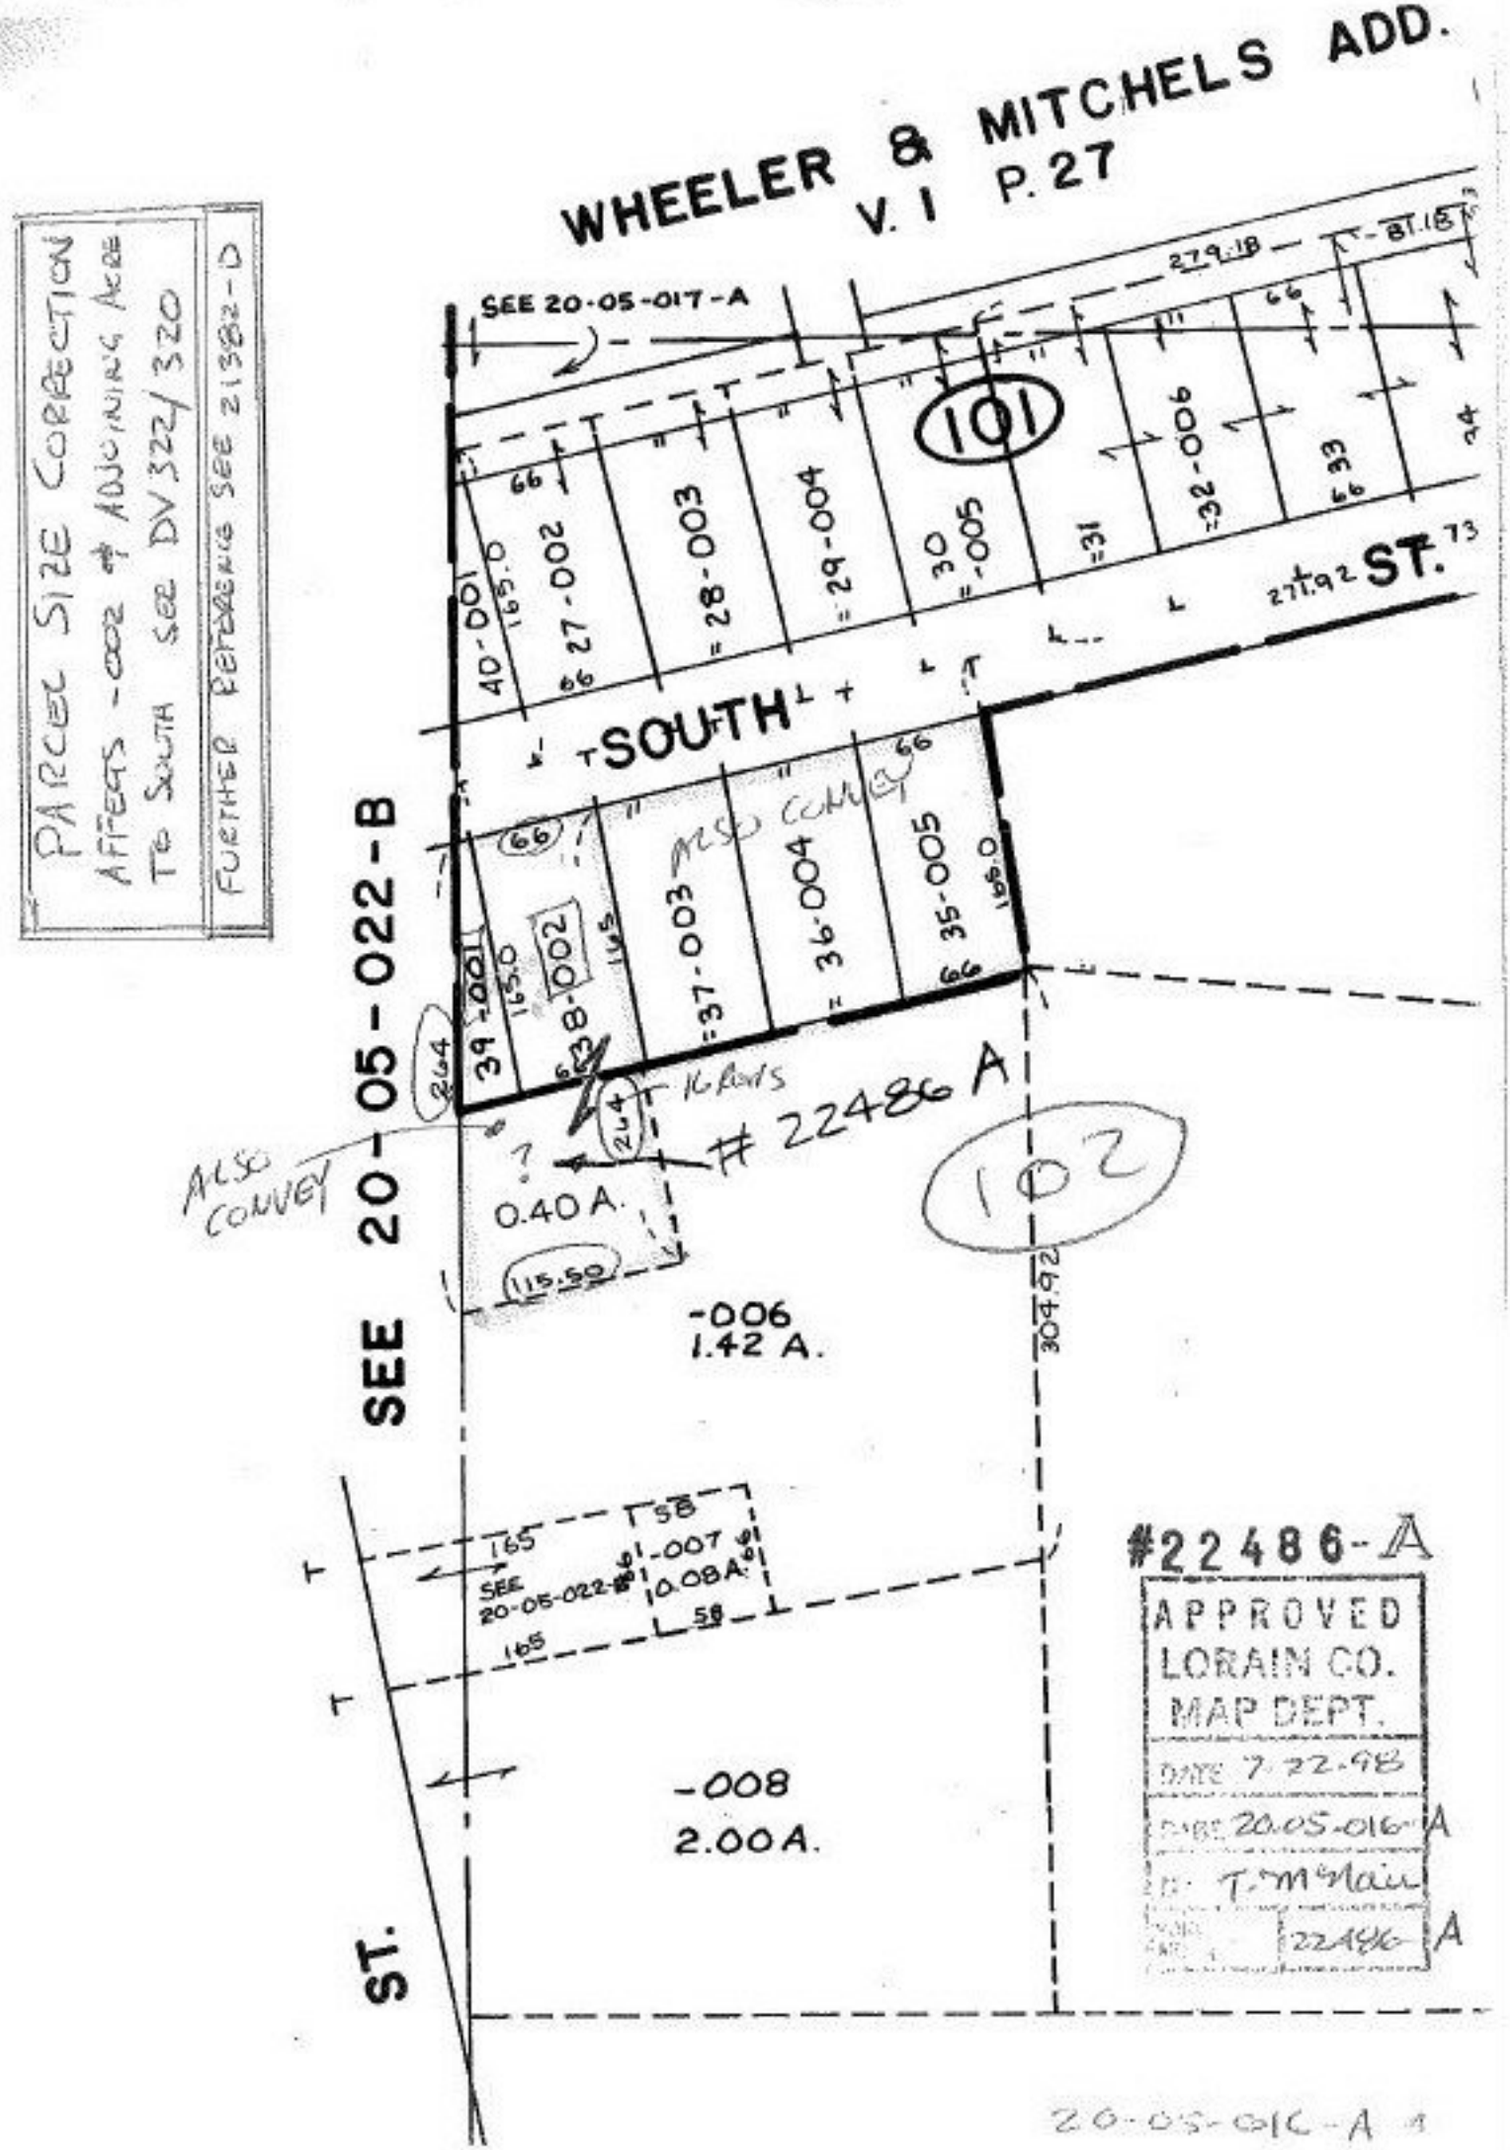
WHEELER & MITCHELS ADD.
V. 1 P. 27
PARCEL SIZE CORRECTION
AFFECTS -002 & ADJOINING ACRE
TO SOUTH SEE DV 322/320
FURTHER REFERENCE SEE 21382-D
SEE 20-05-017-A
279.18
81.18
101
66
40-001
165.0
27-002
28-003
29-004
30-005
31
32-006
33
34
SOUTH
27.92
ST.
73
SEE 20-05-022-B
38-002
37-003
ALSO CONVEY
36-004
35-005
1650
264
16 Rods
22486 A
ALSO CONVEY
0.40 A.
115.50
102
304.92
-006
1.42 A.
SEE 20-05-022-B
165
SB
-007
10.08 A.
58
-008
2.00 A.
ST.
#22486-A
APPROVED
LORAIN CO.
MAP DEPT.
DATE 7-22-98
BY 20-05-016 A
BY T. McNair
22486 A
20-05-016-A