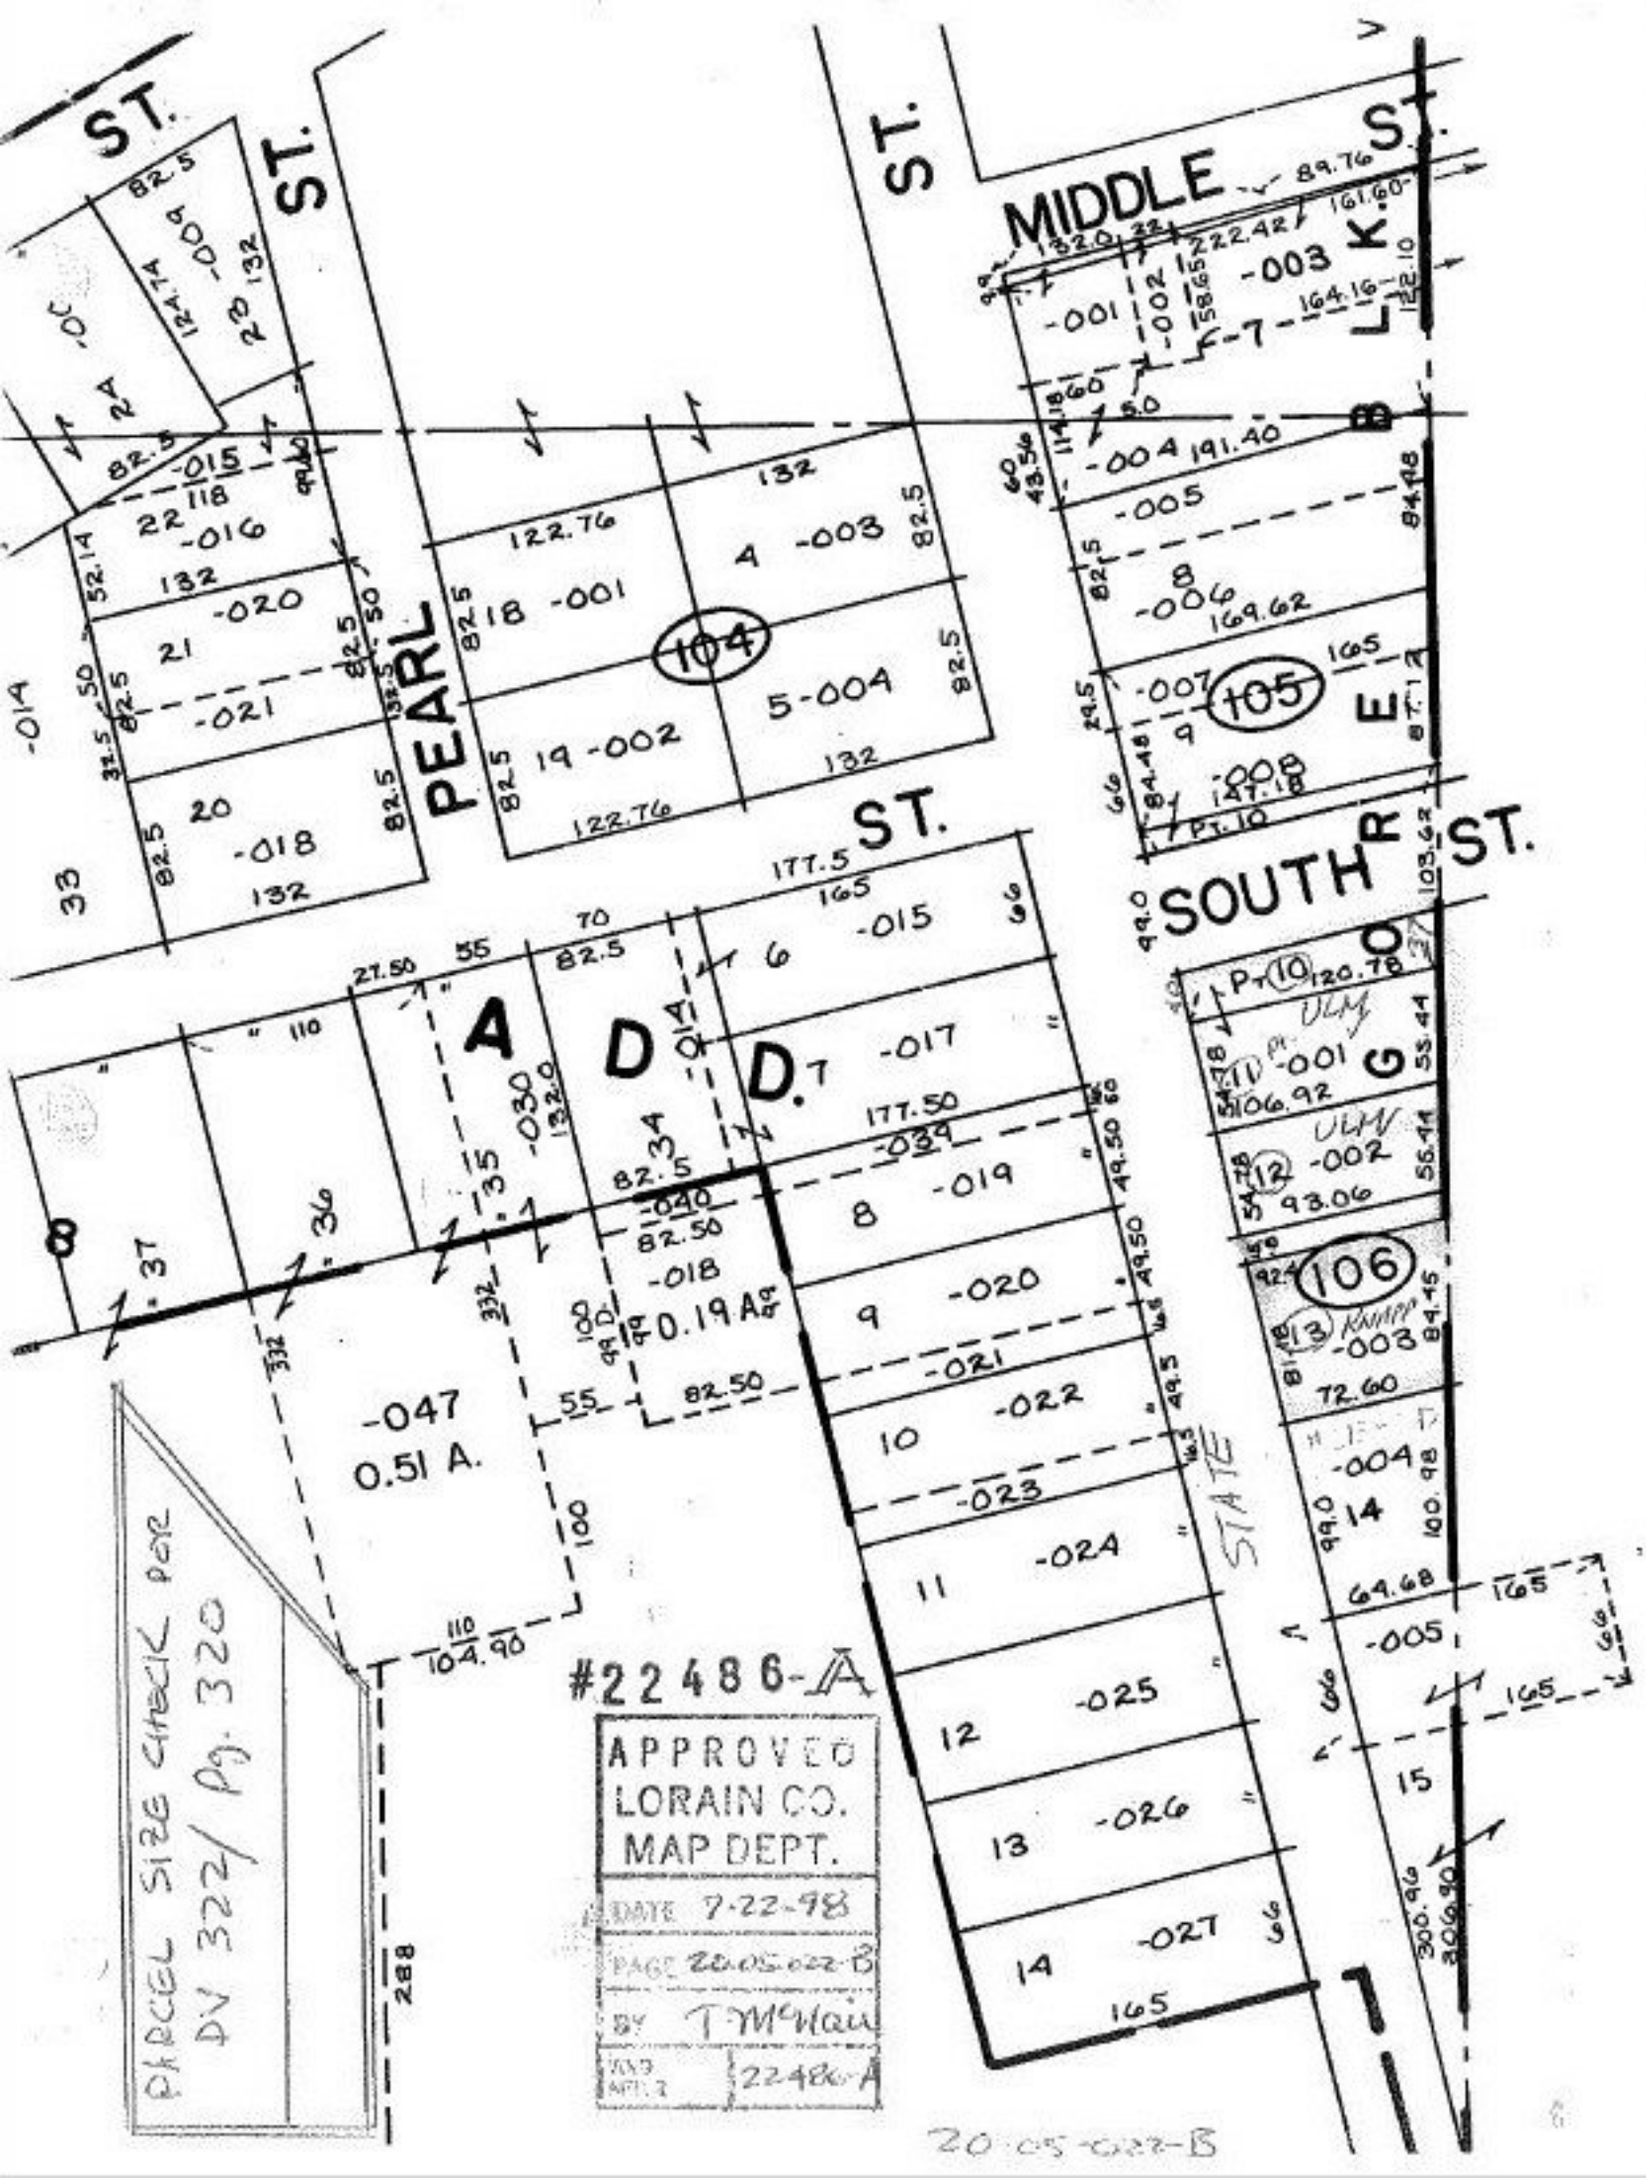
ST.
ST.
ST.
MIDDLE ST.
PEARL ST.
SOUTH ST.
ADD.
104
105
106
-003
-004
-005
-006
-007
-008
-001
-002
-015
-016
-020
-021
-018
-030
-040
-039
-017
-019
-022
-023
-024
-025
-026
-027
-047
0.51 A.
0.19 A
STATE
#22486-A
APPROVED
LORAIN CO.
MAP DEPT.
DATE 7-22-98
PAGE 20-05-022-B
BY T McNair
MAP APP. # 22486-A
PARCEL SIZE CHECK PER DV 322 Pg. 320
20-05-022-B