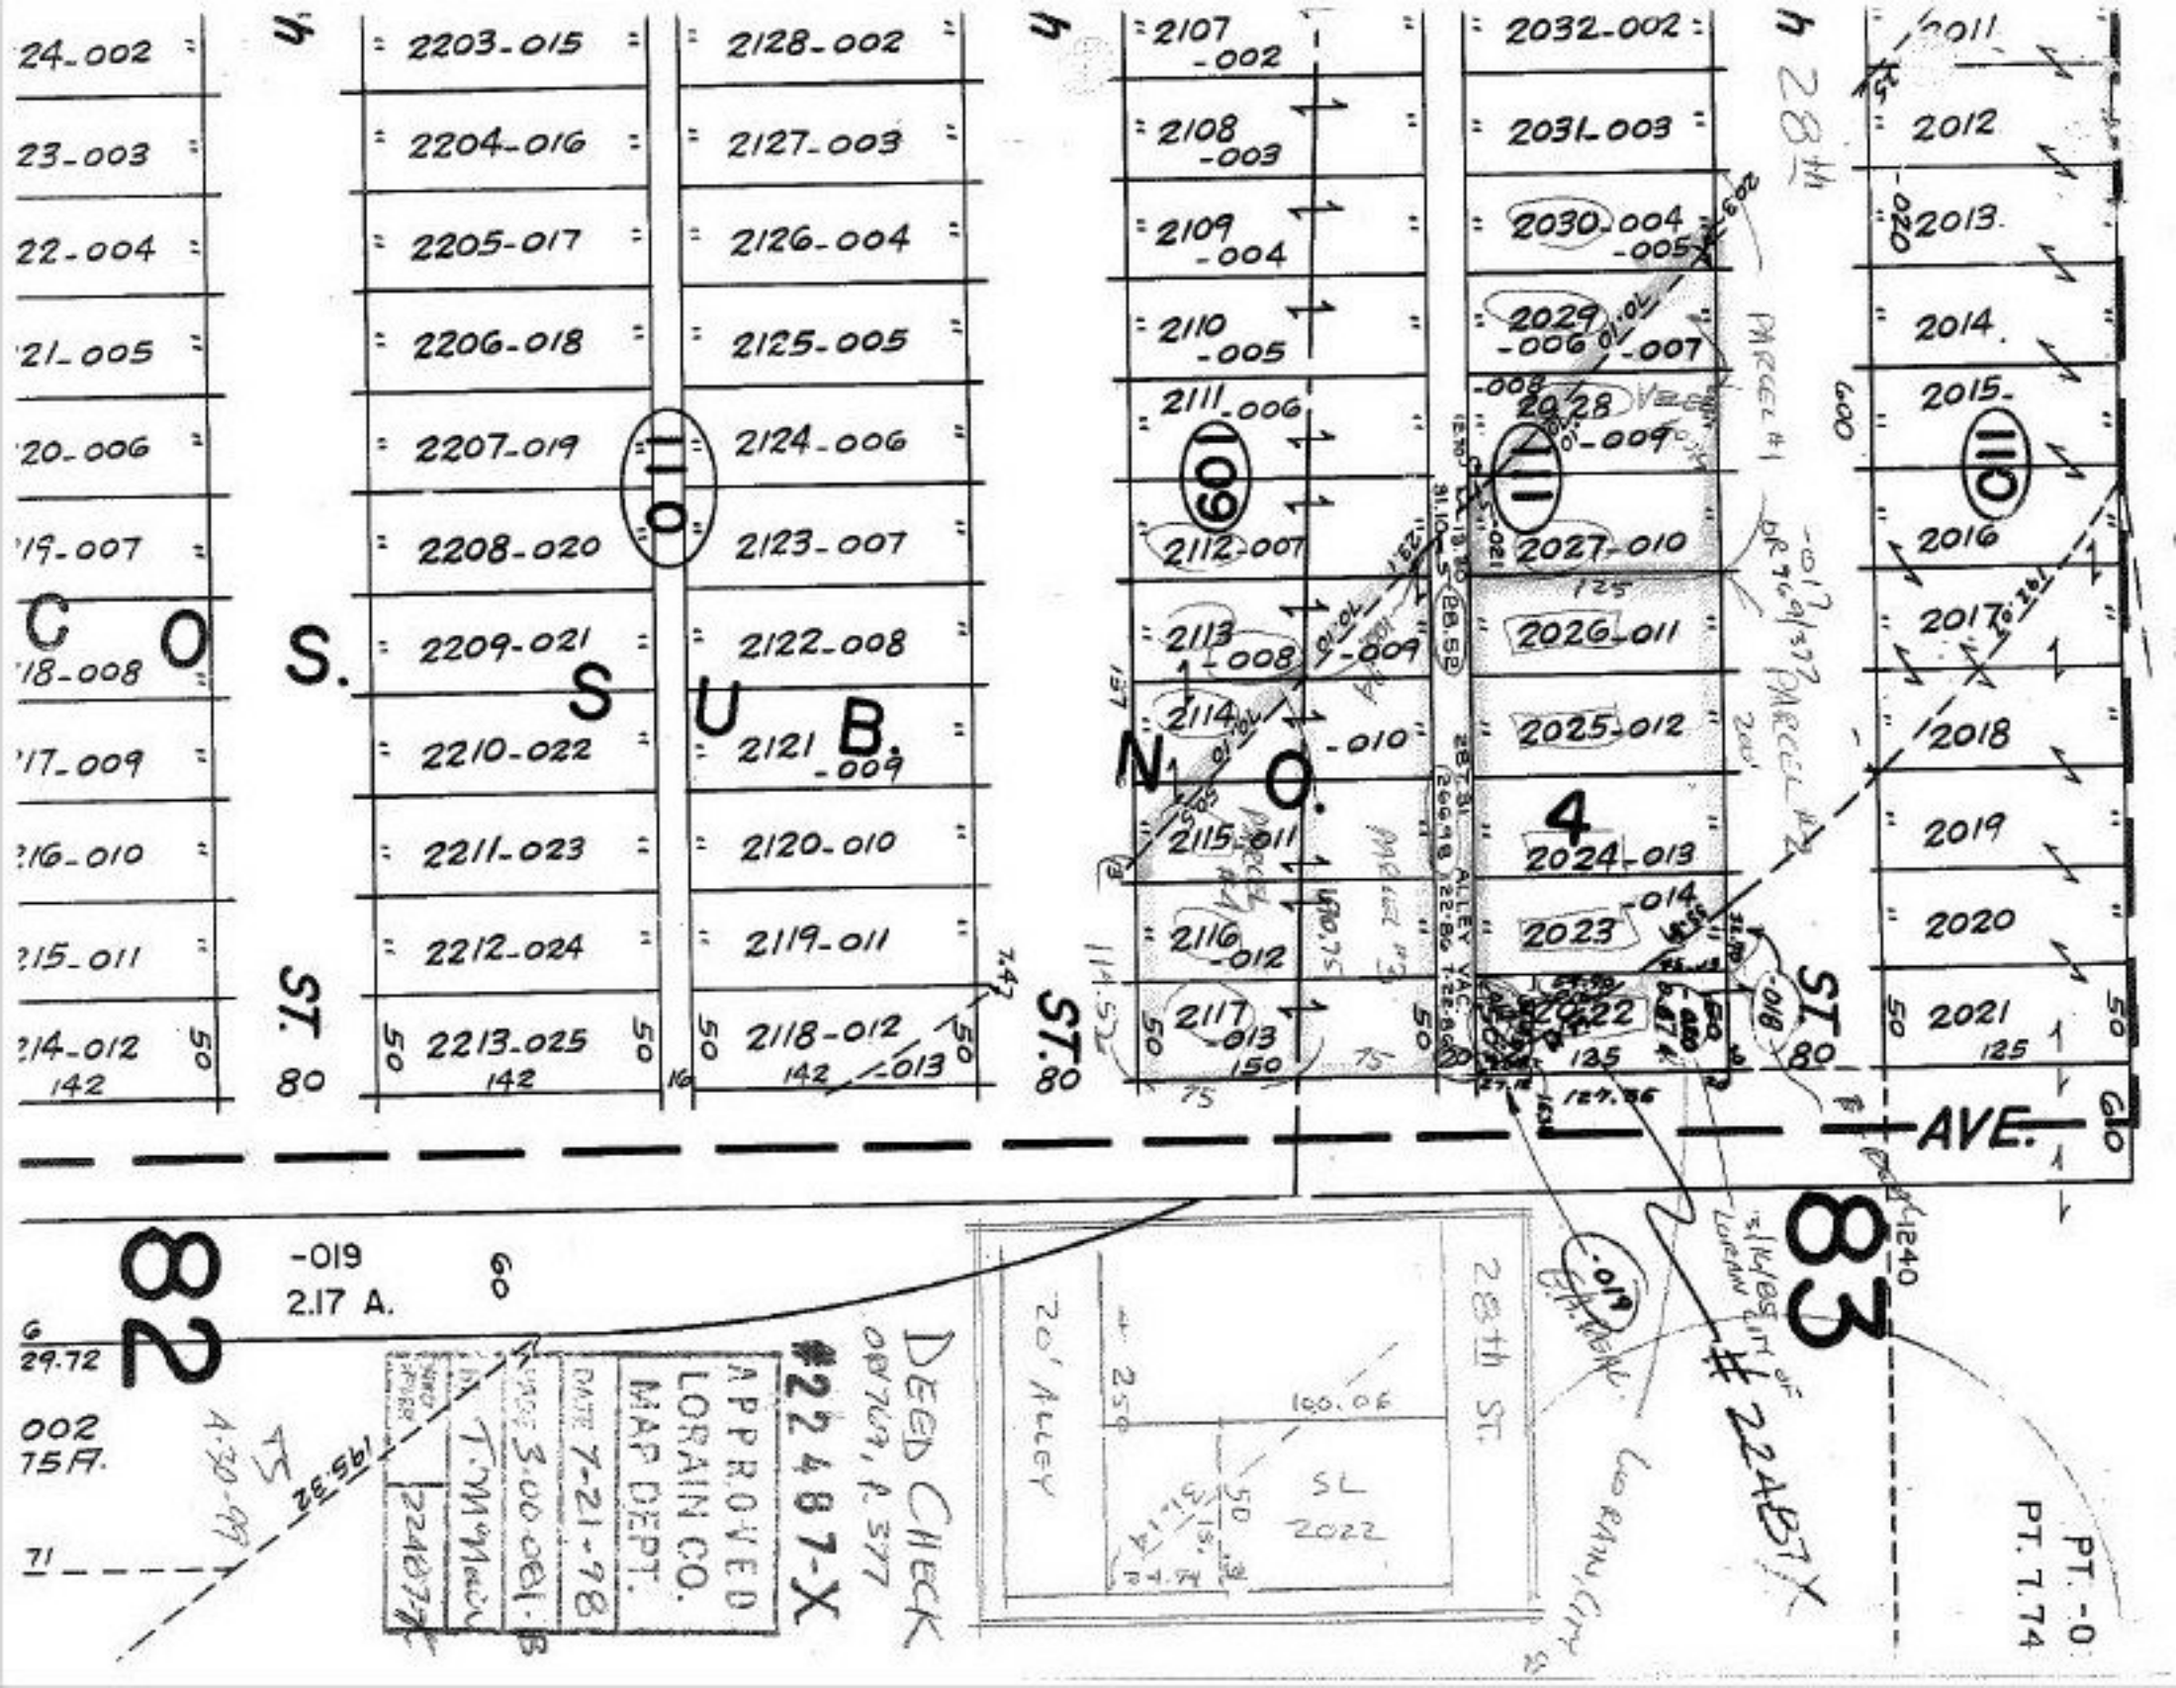
S. SUB. NO. 4
ST.
AVE.
28th St.
20' Alley
DEED CHECK
APPROVED
LORAIN CO.
MAP DEPT.
DATE 7-21-98
#22487-X
#22487-X
PARCEL #1
PARCEL #2
PT. 0
PT. 7.74
2.17 A.
2203-015
2204-016
2205-017
2206-018
2207-019
2208-020
2209-021
2210-022
2211-023
2212-024
2213-025
2128-002
2127-003
2126-004
2125-005
2124-006
2123-007
2122-008
2121-009
2120-010
2119-011
2118-012
2107-002
2108-003
2109-004
2110-005
2111-006
2112-007
2113-008
2114-010
2115-011
2116-012
2117-013
2032-002
2031-003
2030-004
2029-006
2028-009
2027-010
2026-011
2025-012
2024-013
2023-014
2022
2012
2013
2014
2015
2016
2017
2018
2019
2020
2021
82
83