PARENT PARCEL: 12-00-077-000-006, 12-00-084-102-023, 025

CHILD PARCEL: 12-00-084-102-042, THRU -045

STARTING POINT: CL OF ROOT RD.

NO. 22487

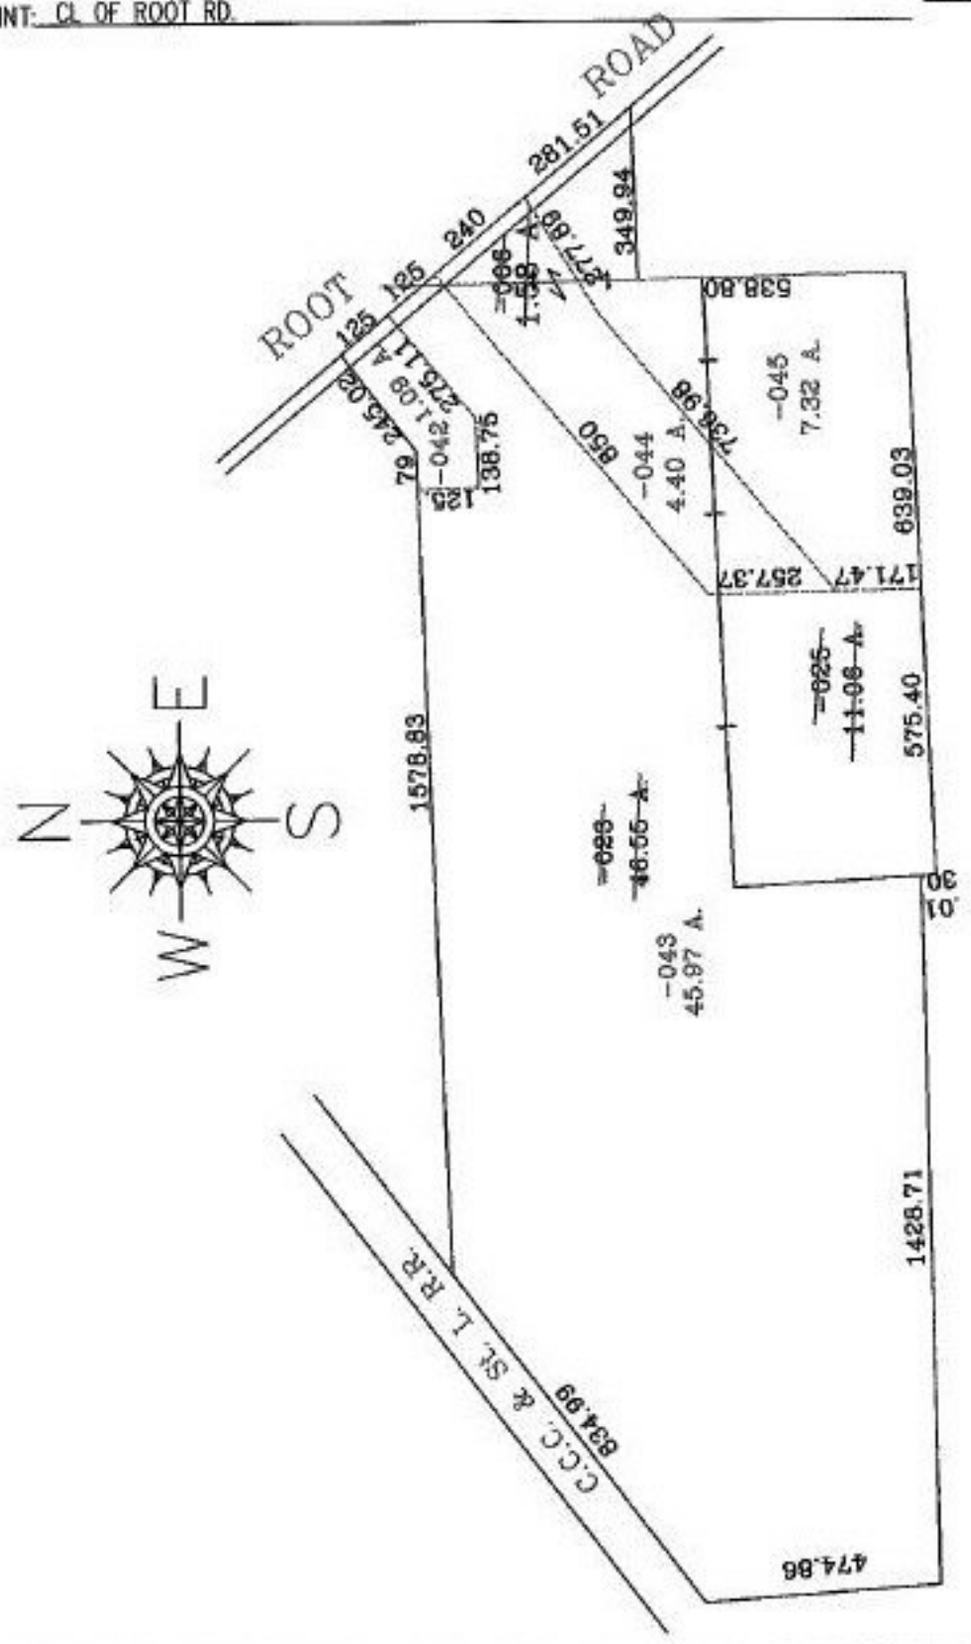

SPLITS/DEEDS PROCESSED

LORAIN COUNTY TAX MAP DEPARTMENT

226 MIDDLE AVE. ELYRIA, OHIO

SURVEYED BY: DENNIS A. SEIFERT

CLOSURE: 0.02 : 10,000

MAP PAGE(S): 12-A, 12-00-084-B

APPROVED BY: JAH DATE: 6-12-98

SCALE: 1"= 400 PRIOR INSTRUMENT: OR 937/720