PARENT PARCEL: 07-00-002-101-025, 050
CHILD PARCEL: 07-00-002-101-051 thru -055
STARTING POINT: cl of Berea Rd. & E. line of O.L. 2

NO. 22488

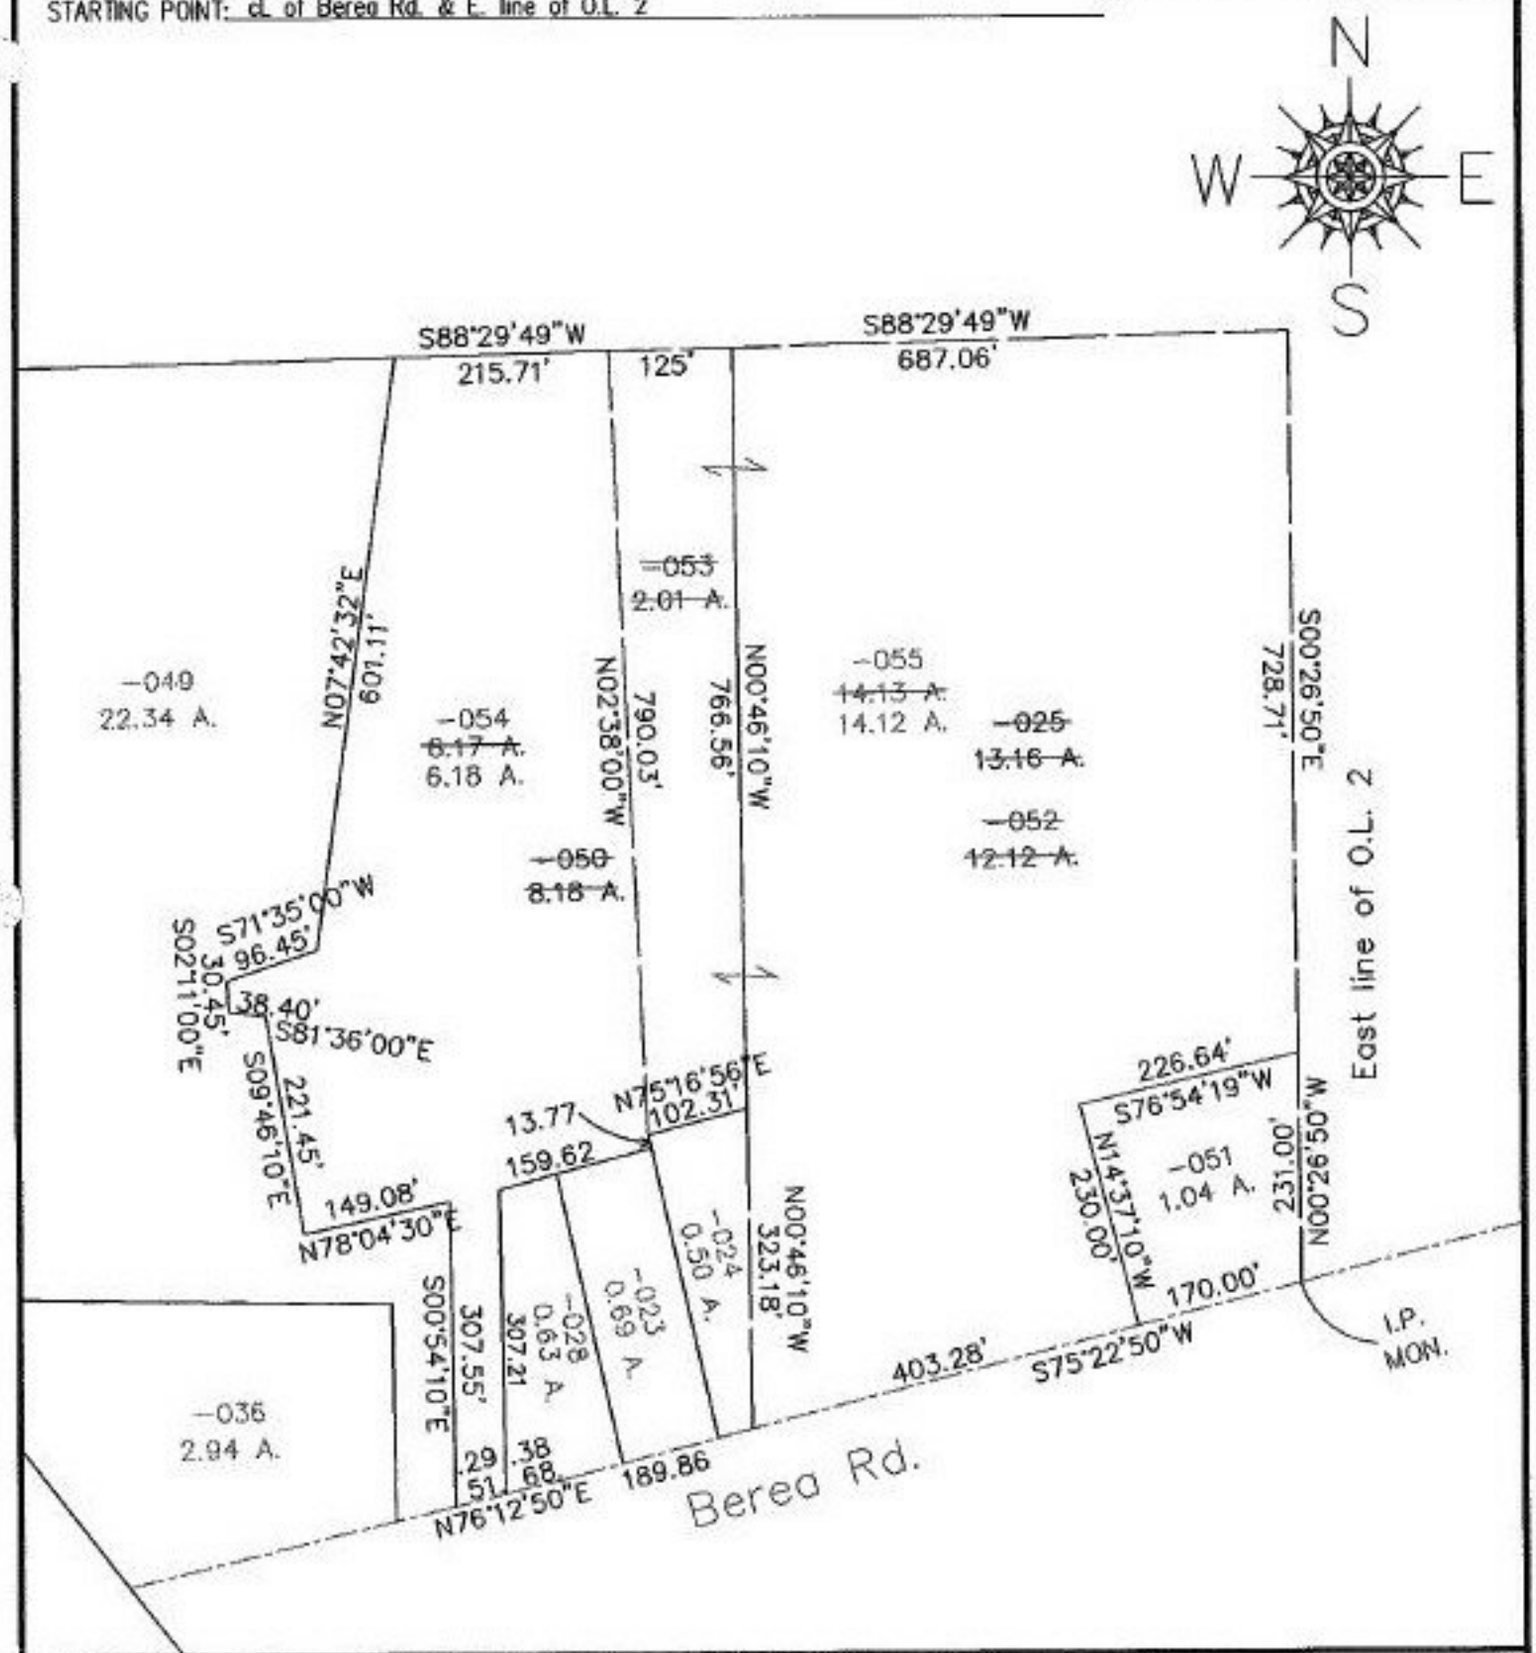


SPLITS/DEEDS PROCESSED
LORAIN COUNTY TAX MAP DEPARTMENT
226 MIDDLE AVE. ELYRIA, OHIO

SURVEYED BY: David L. Elwell
CLOSURE: 0.05:10,000 SCALE: 1"= 200
MAP PAGE(S): 07-00-002-B
APPROVED BY: kac DATE: 3/30/98
PRIOR INSTRUMENT: 1433/246, #970473942

5-5-98