#22490-D
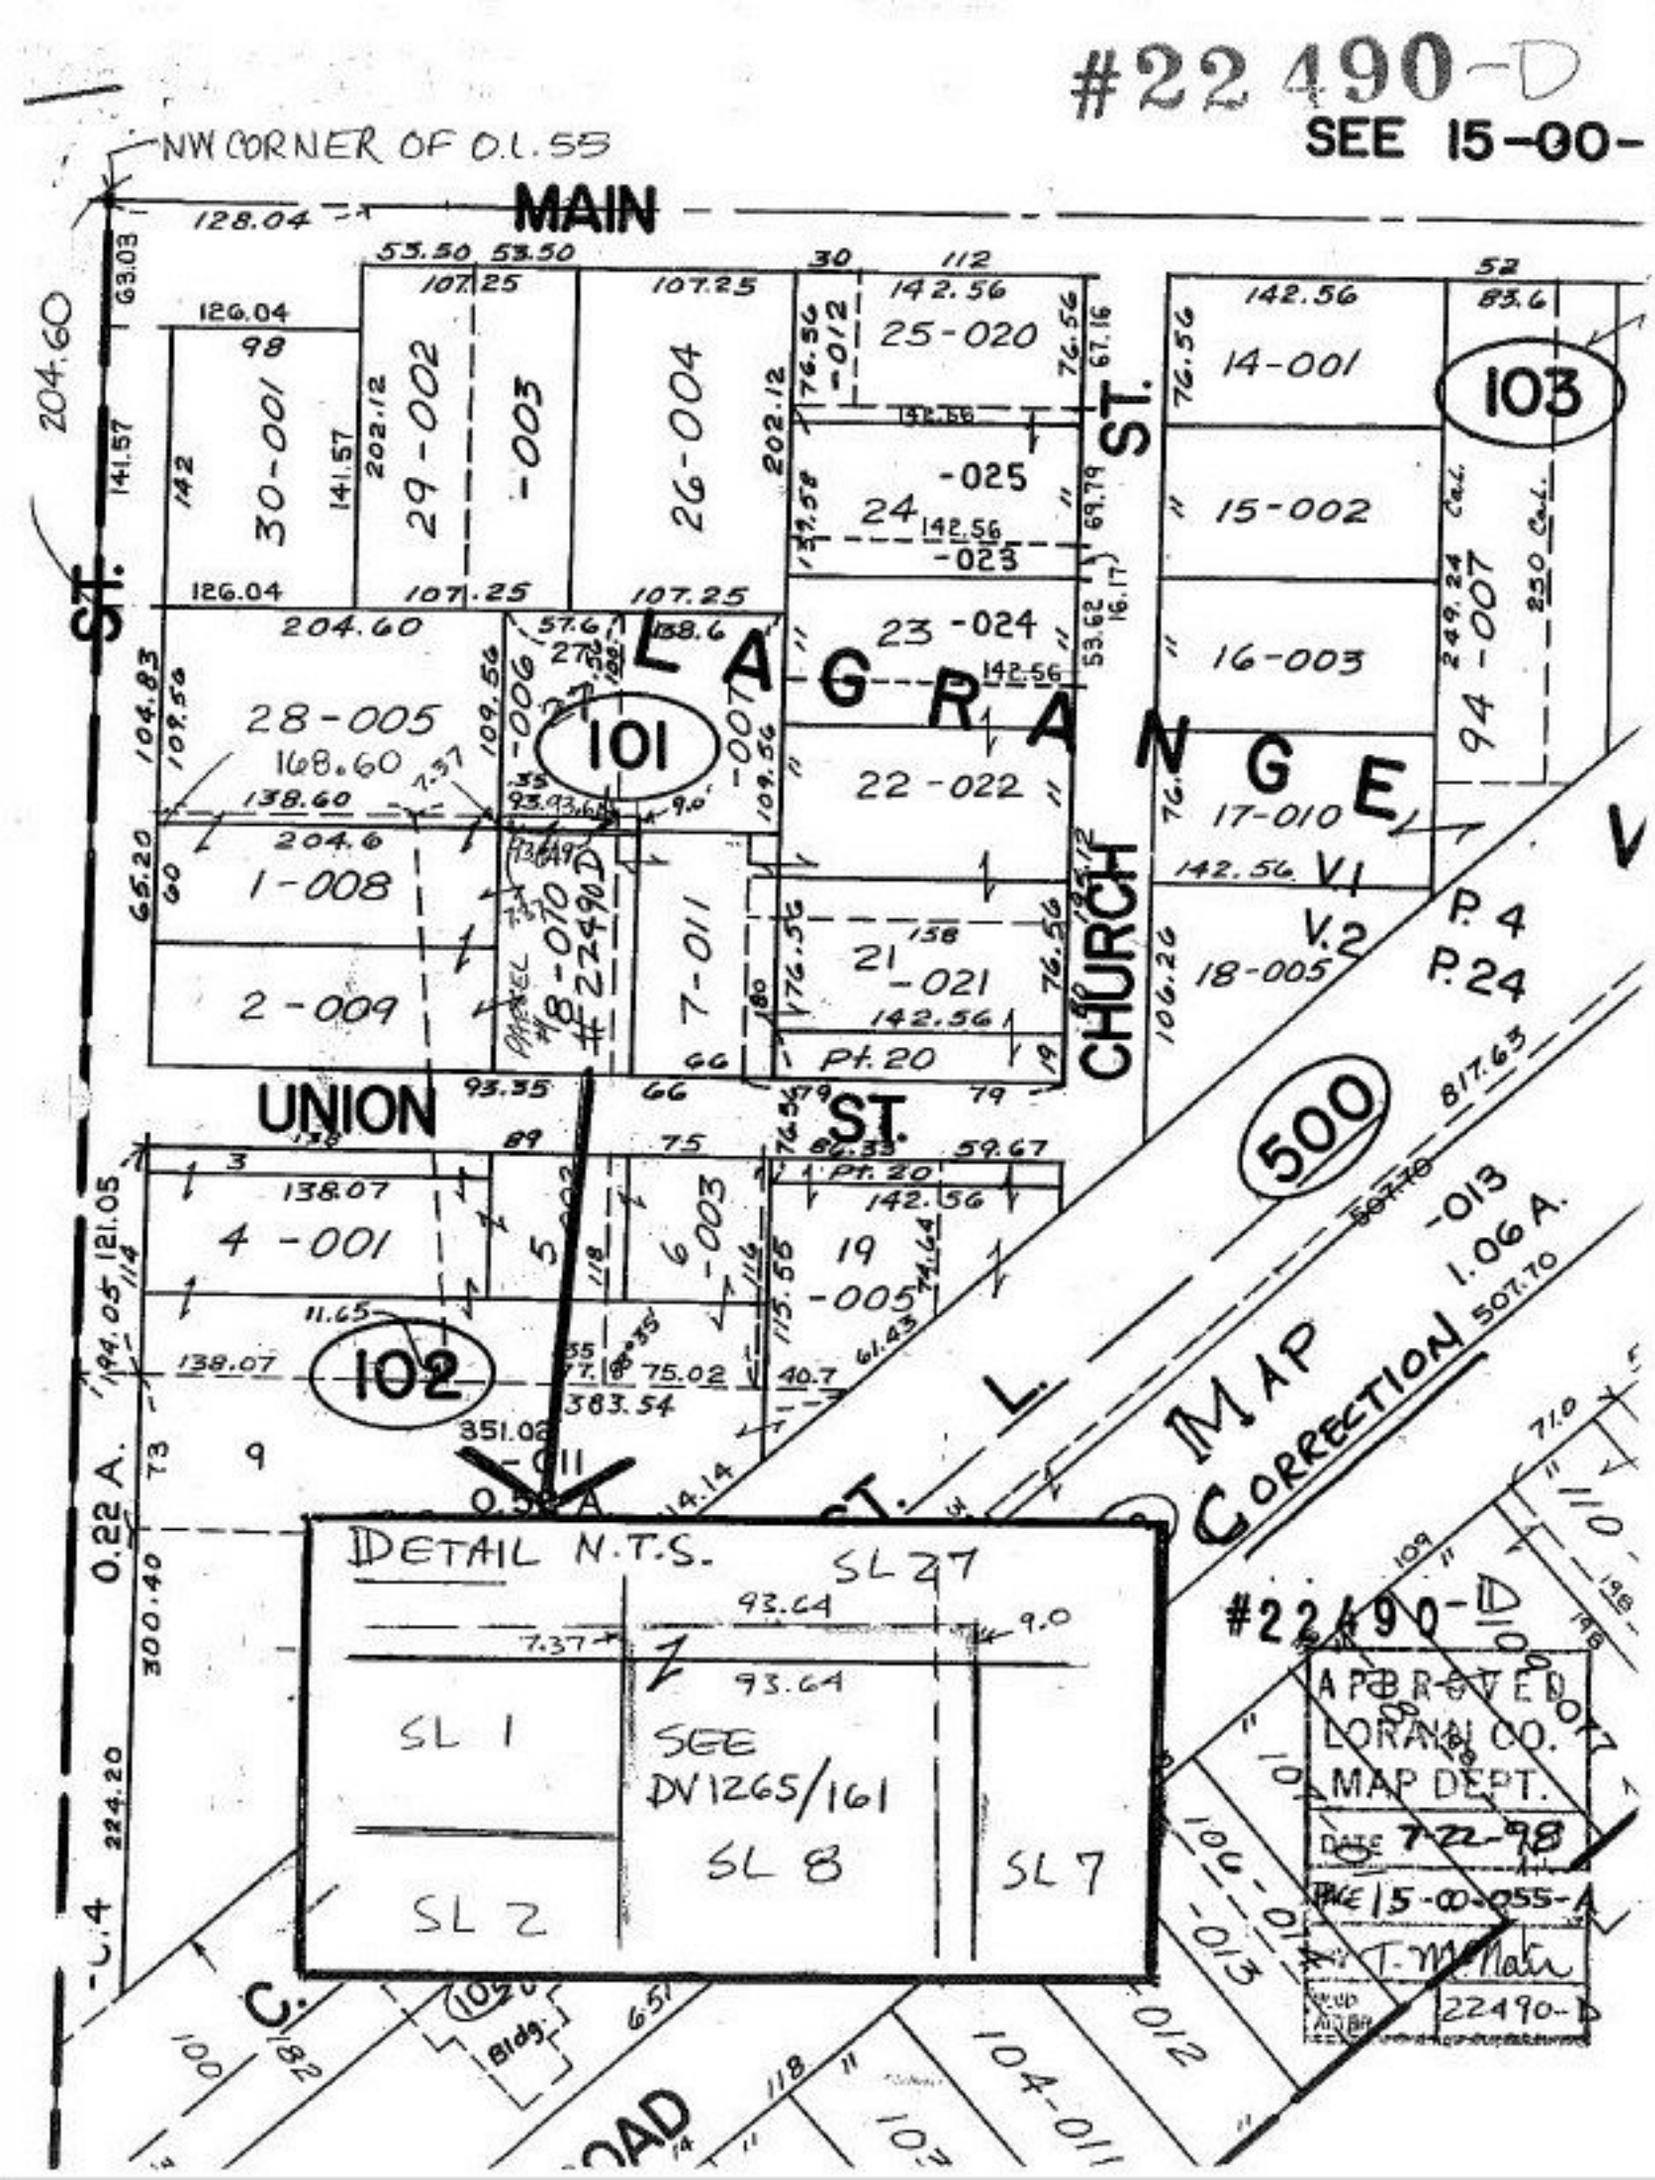
SEE 15-00-