#22491

NO. 22491

PARENT PARCEL: 06-25-001-000-082, 07-00-048-000-007, 10-00-005-102-313
11-00-091-000-002, 003, 004, 005, 019, 021, 11-00-092-000-002, 063

CHILD PARCEL: 11-00-091-000-020, 021, 022

STARTING POINT: cl. of Dewhurst Rd. & cl. of Chestnut Ridge Rd.

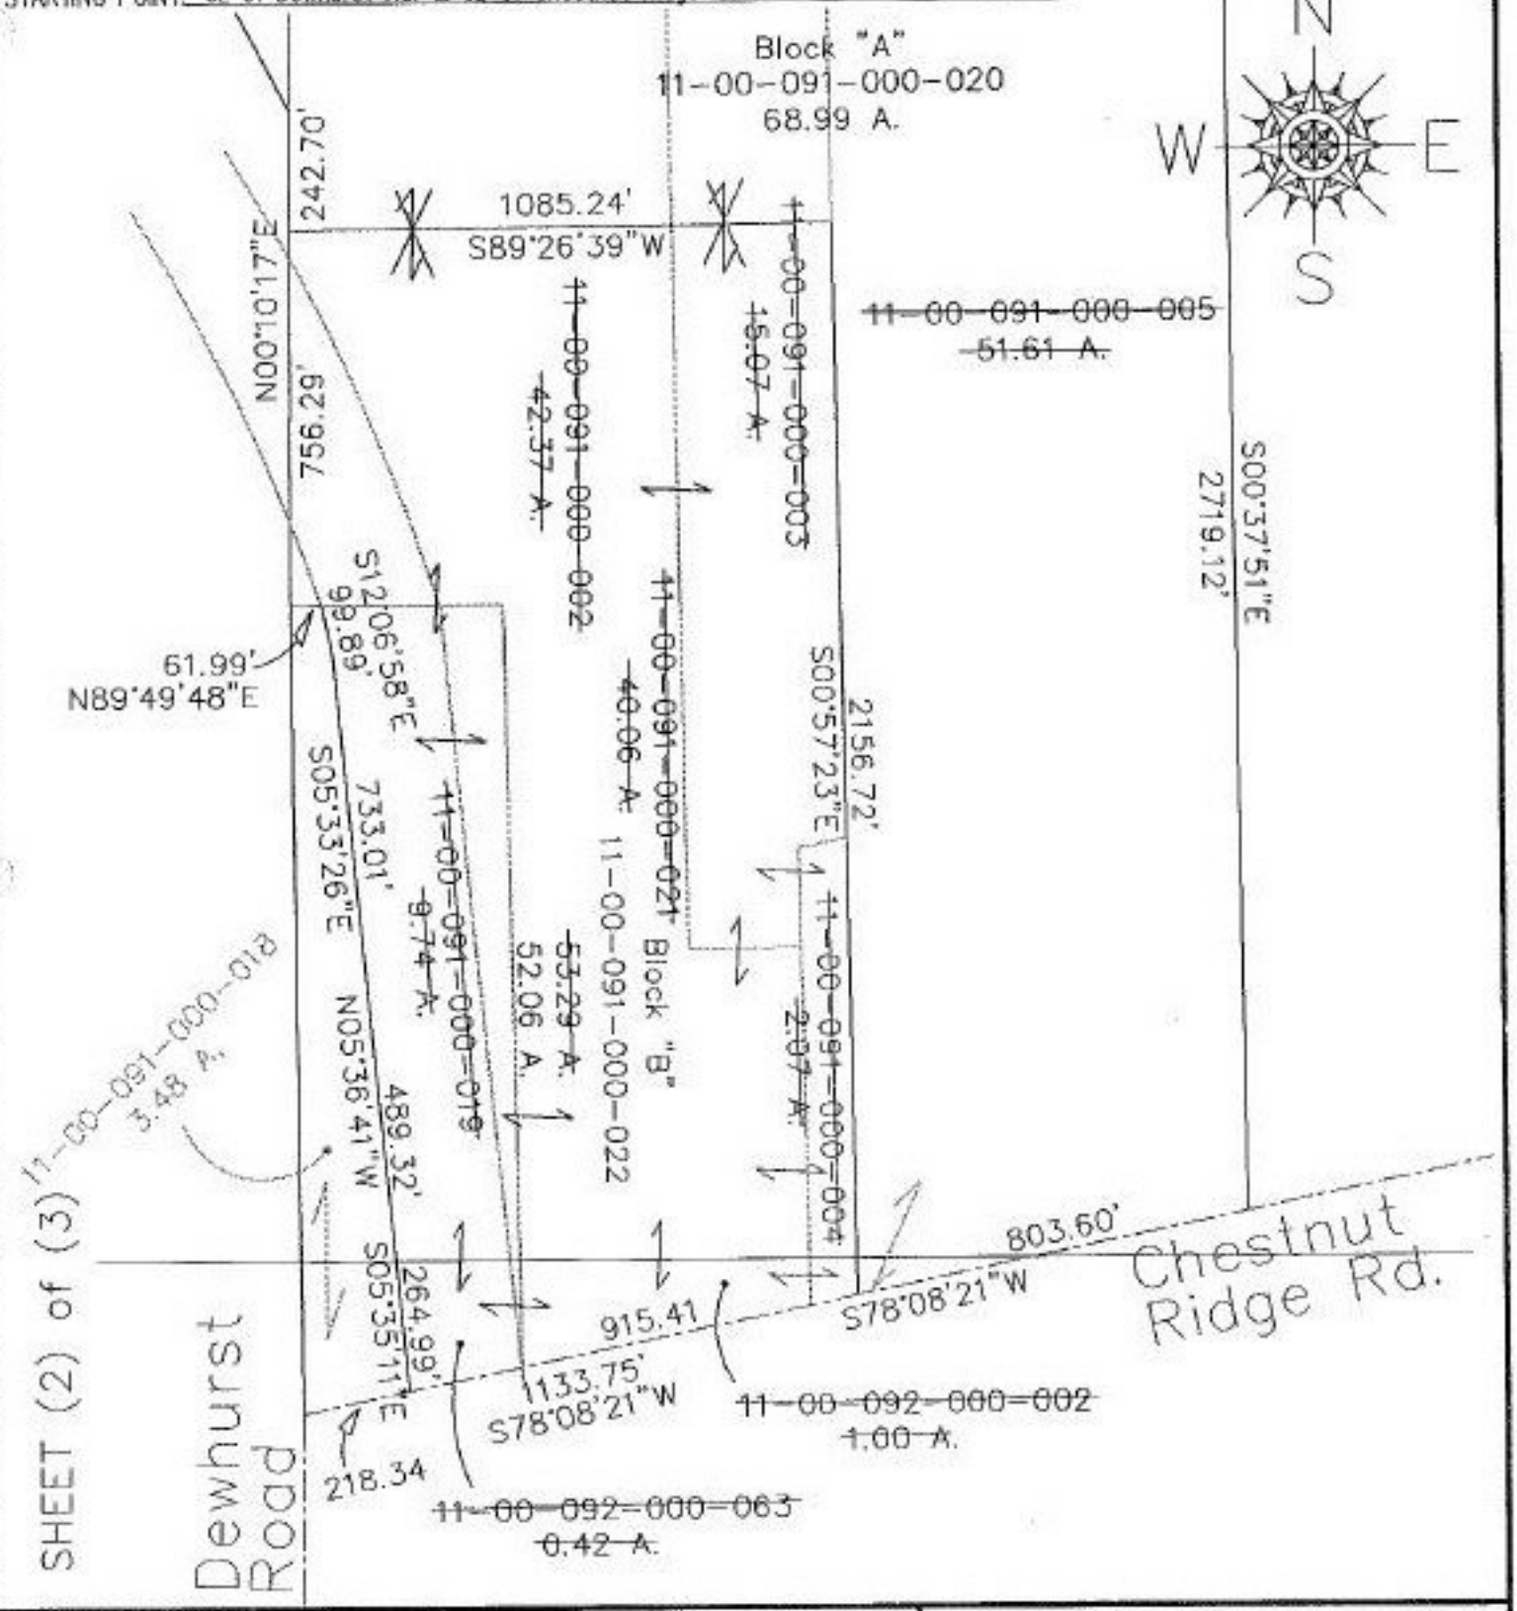

SPLITS/DEEDS PROCESSED
LORAIN COUNTY TAX MAP DEPARTMENT
226 MIDDLE AVE. ELYRIA, OHIO

SURVEYED BY: Terin Kaminski
MAP PAGE(S): 6-144, 7-E, 10-00-005-D, 11-A, 11-00-092-A
APPROVED BY: kac DATE: 3/19/98
SCALE: 1" = 400 PRIOR INSTRUMENT: