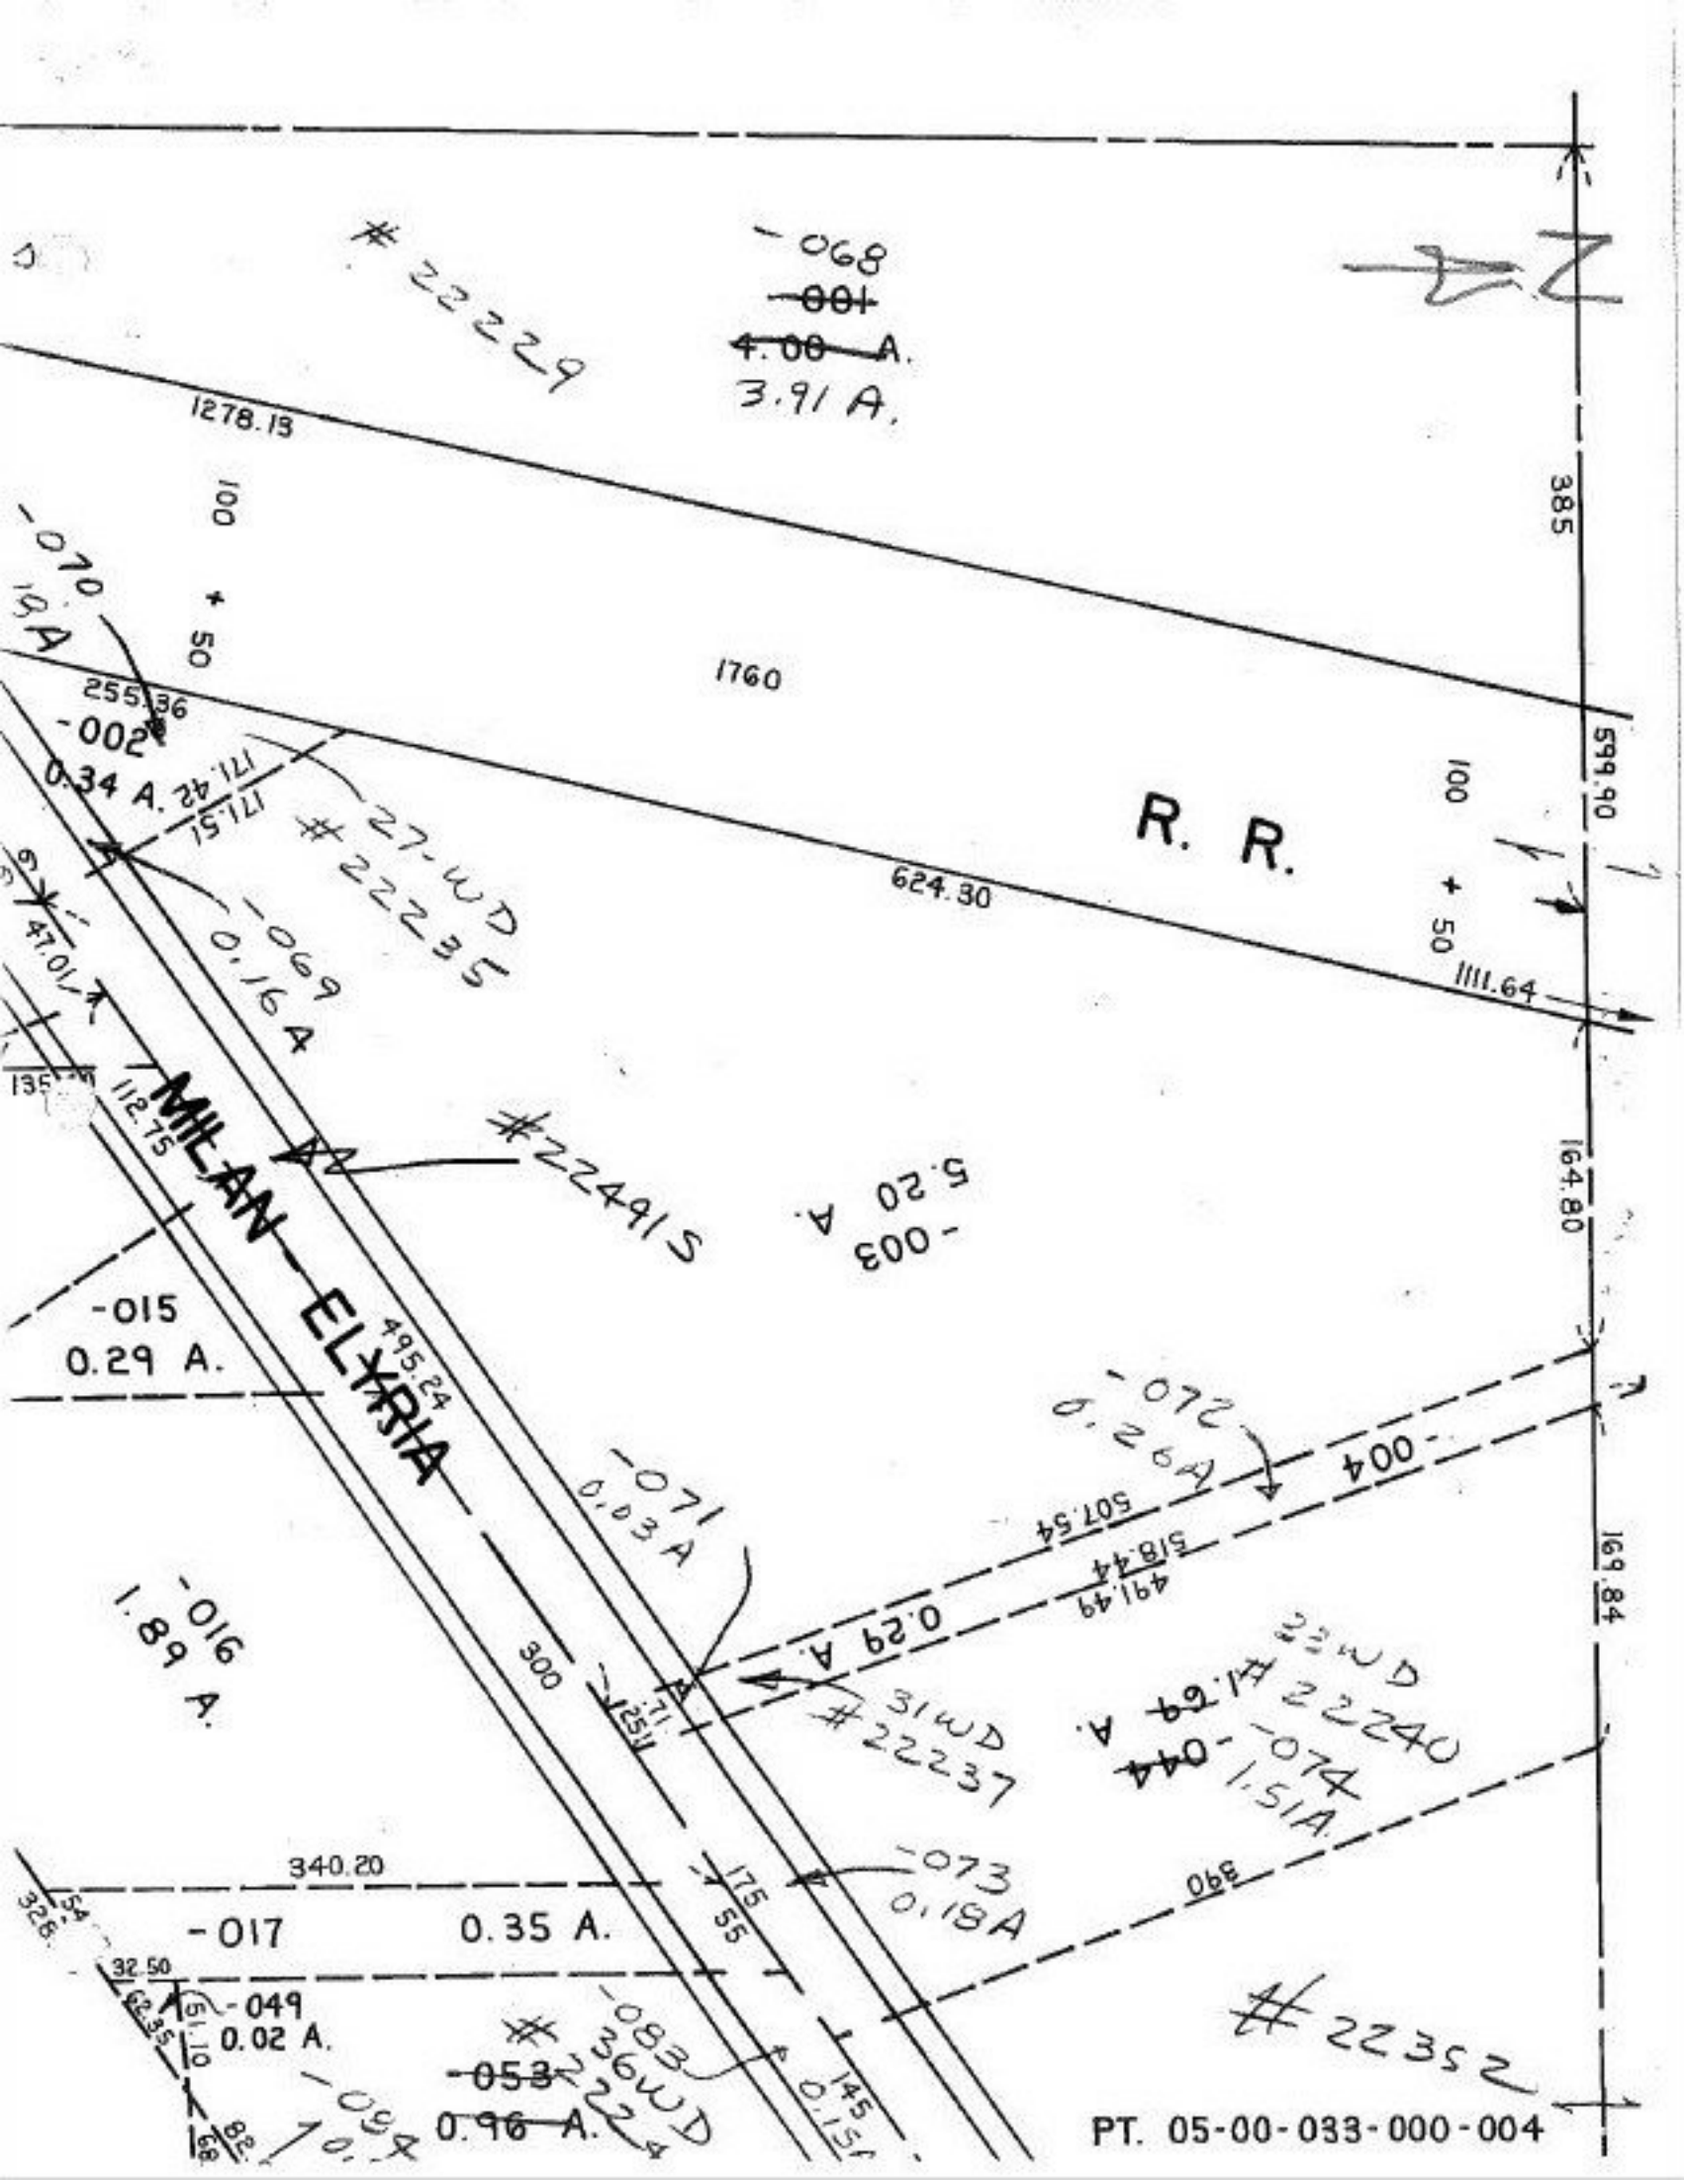

-068
~~-001~~
~~4.00 A.~~
3.91 A.
#22229
1278.13
100
+ 50
-070
19 A
255.36
-002
0.34 A.
171.42
171.51
27-WD
#22235
-069
0.16 A
1760
R. R.
624.30
100
+ 50
1111.64
385
599.90
164.80
169.84
47.01
112.75
MILAN - ELYRIA
#22491S
-003
5.20 A.
-015
0.29 A.
495.24
-071
0.03 A
-072
0.26 A
-004
507.54
518.44
491.49
0.29 A.
-016
1.89 A.
300
31WD
#22237
33WD
#22240
-074
1.51 A.
-044
-073
0.18 A
340.20
175
55
390
-017
0.35 A.
32.50
-049
0.02 A.
-083
36WD
#22224
-053
0.96 A.
145
#22352
PT. 05-00-033-000-004